

Note:
For continuation
see Dwg. #438457

PARTIAL PLAN EL. 110'-0"

NOTES:
1. Where not indicated otherwise, Reinf. to be symmetrical about Col. line (18)


REFERENCE DRAWINGS:
Drawing List, Notes & Legend 438425

D.C. 683850

REINDEXED REV. 7

UNITS 1 & 2

CONCRETE REINFORCING
PLAN AT ELEV. 115'-0"
AUXILIARY BUILDING- AREA H & K
DIABLO CANYON
DEPARTMENT OF ENGINEERING
PACIFIC GAS AND ELECTRIC COMPANY
SAN FRANCISCO, CALIFORNIA

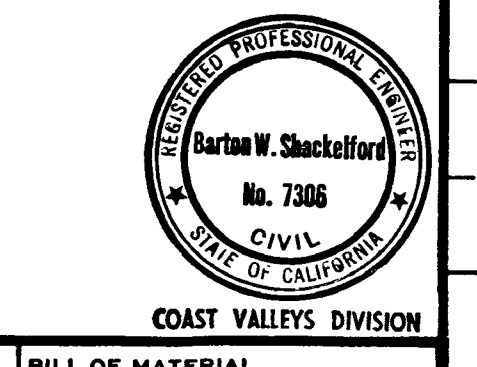

BILL OF MATERIAL
DRAWING LIST 050052
SUPERSEDED BY
SUPERSEDED BY
SHEET NO. SHEETS
DRAWING NUMBER
438458 7

NO.	DATE	DESCRIPTION	GM	BY	CH.	APPR.
7	8-21-78	TITLE CHANGED, AS BUILT BY 101.E		SE	JK	
		D.C. POSTED				

COORDINATION
NOT REQUIRED

CHANGES APPROVED BY SUPERVISING ENGINEER						
NO.	DATE	DESCRIPTION	GM	BY	CH.	APPR.
3	11-2-77	CHANGED CONC. OUTLINE AT COL. LINE D		S.E.	J.K.	
4	11-14-77	CHANGED CONC. OUTLINE IN TRENCH AND ADDED SEC. M & B		F.H.	J.B.	
4	3-30-77	REMOVE HOLD AREA BETWEEN T & V. REV. REINF. & CONC. OUTLINE BETWEEN T & V.		GEM	L.B.	OWS

CHANGES APPROVED BY SUPERVISING ENGINEER						
NO.	DATE	DESCRIPTION	GM	BY	CH.	APPR.
3	10-31-78	REMOVED HOLD IN AREA BETWEEN TRENCH & HOLD BETWEEN TRENCHES		F.H.	L.B.	OWS
2	11-10-78	REMOVE HOLD AREA BETWEEN TRENCH & V		F.H.	K.K.	OWS
1	8-6-78	REMOVE HOLD AREA BETWEEN TRENCH & V		F.H.	L.B.	OWS

APPROVED
GM 184972
SUPERV. BY R. Krauss
CHECKED BY B. Ballou
DR. S. Elmaghrabi
CH. L. E. Bonyay
CH. L. B. OWS
DATE 6-22-78
SCALE
7/8" = 1 FT.