
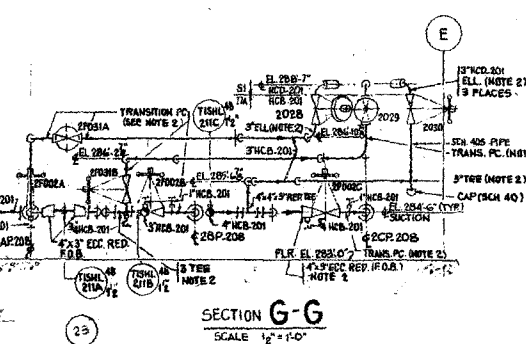
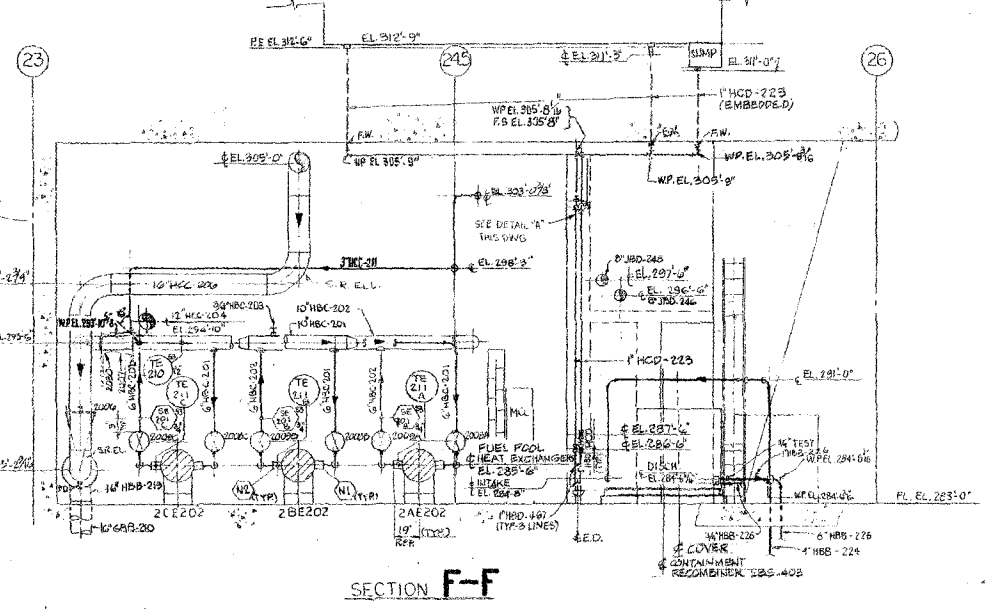
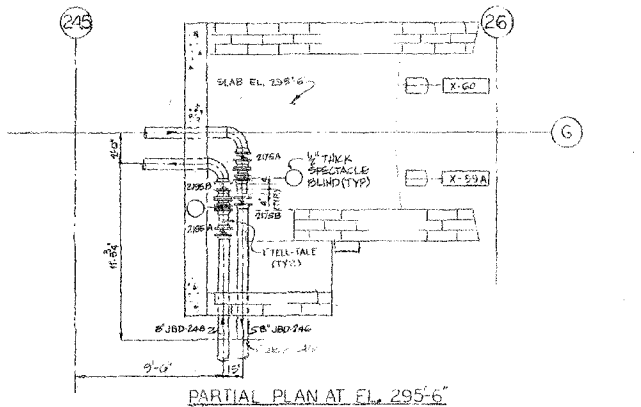
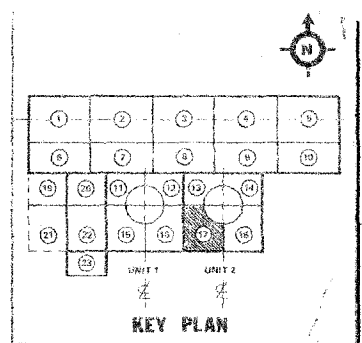
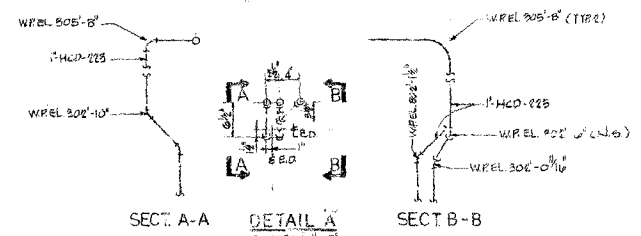


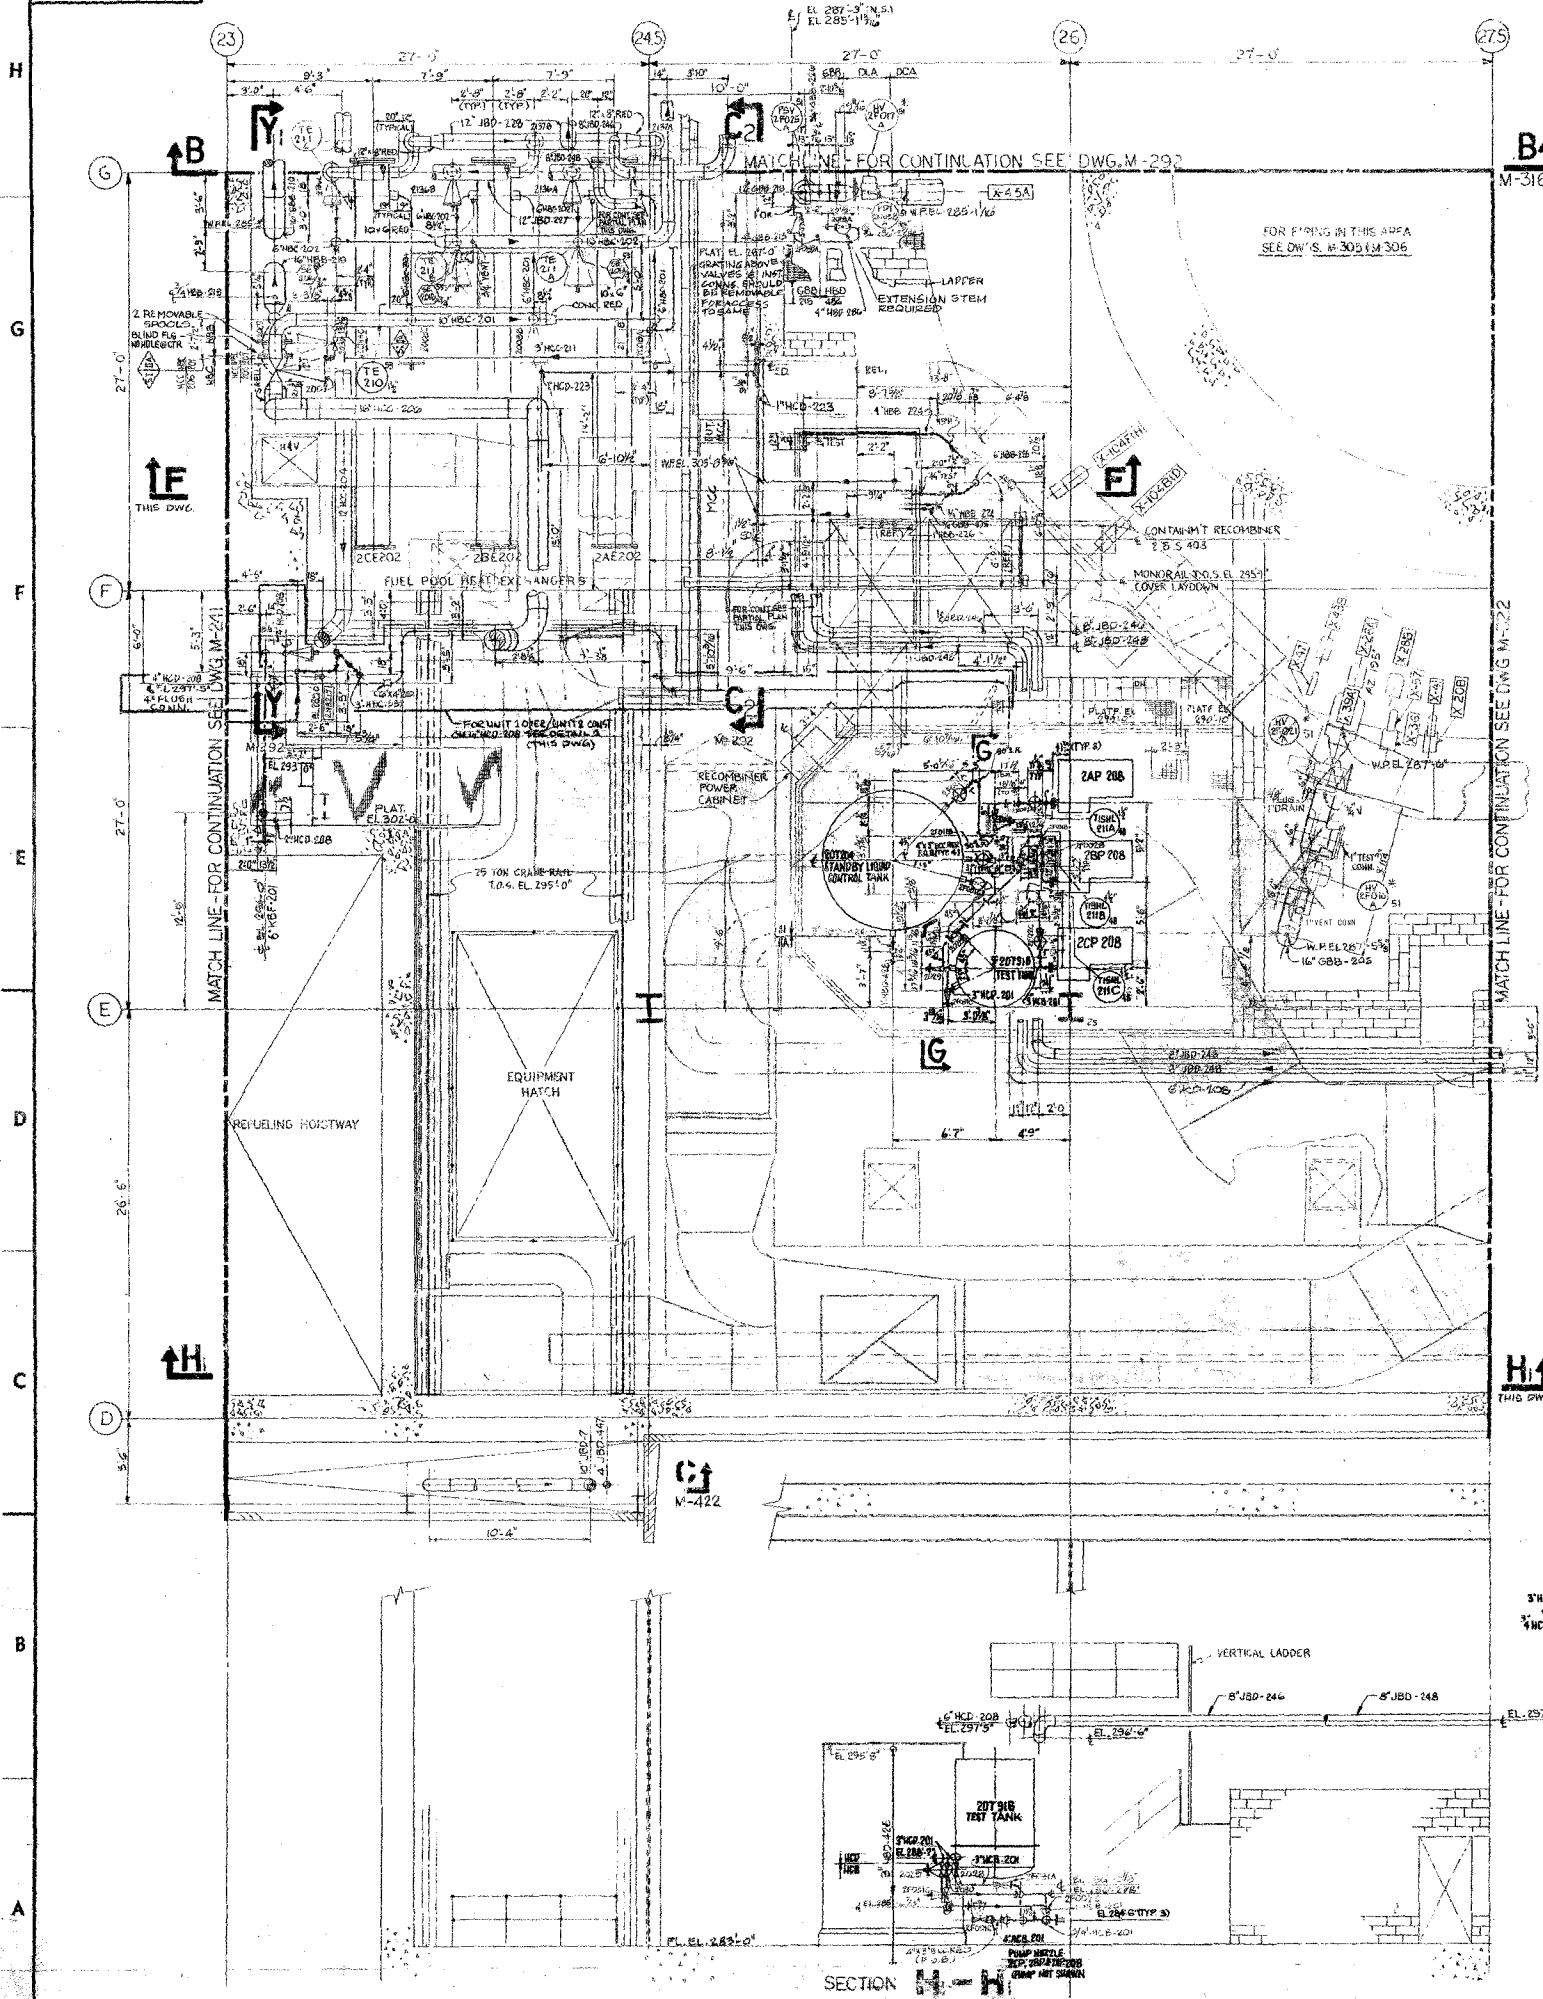

- NOTES:
1. ALL DIMENSIONS, GRAPHIC REPRESENTATIONS AND DATA CONCERNING ANY COMPONENTS OTHER THAN LARGE PIPING 24" AND LARGER ARE FOR REFERENCE ONLY.
 2. SCH 40S COUNTDOWN ONE END TO MATCH SCH 10S.
 3. DUE TO EXTENSIVE CHANGES, REVISIONS TO THIS DRAWING HAVE BEEN OMITTED FOR DRAWING CLARITY.

30	INCORPORATED:	DR-00458 REV. 001	CH	RA	RF
30	REVISED TO UPDATE PER AS BUILT	CONSTRUCTION FILE APPROVED	10/1	10/1	10/1
DATE	REVISION	BY	DATE	DATE	DATE
SCALE 1/4" = 1'-0"	CONTRIBUTOR	DATE	DATE	DATE	DATE
BECHTEL SAN FRANCISCO					
LIMERICK GENERATING STATION UNITS 1 & 2 PHILADELPHIA ELECTRIC COMPANY					
PIPING AND MECHANICAL REACTOR BLDG. UNIT NO. 2 PLAN AT EL 283'-0" AREA 17					
JOB NO.	DRAWING NO.	REV.			
8031	M-312	30			

REVIEWED FOR ALARA
REV. DATE 7-7-81
INITIAL