


ALTERNATE WELL WATER SUPPLY SYSTEM  
 SUPPLY TO WATER TREATMENT SYSTEM  
 (REFERENCE PROCEDURE 2.2.57)

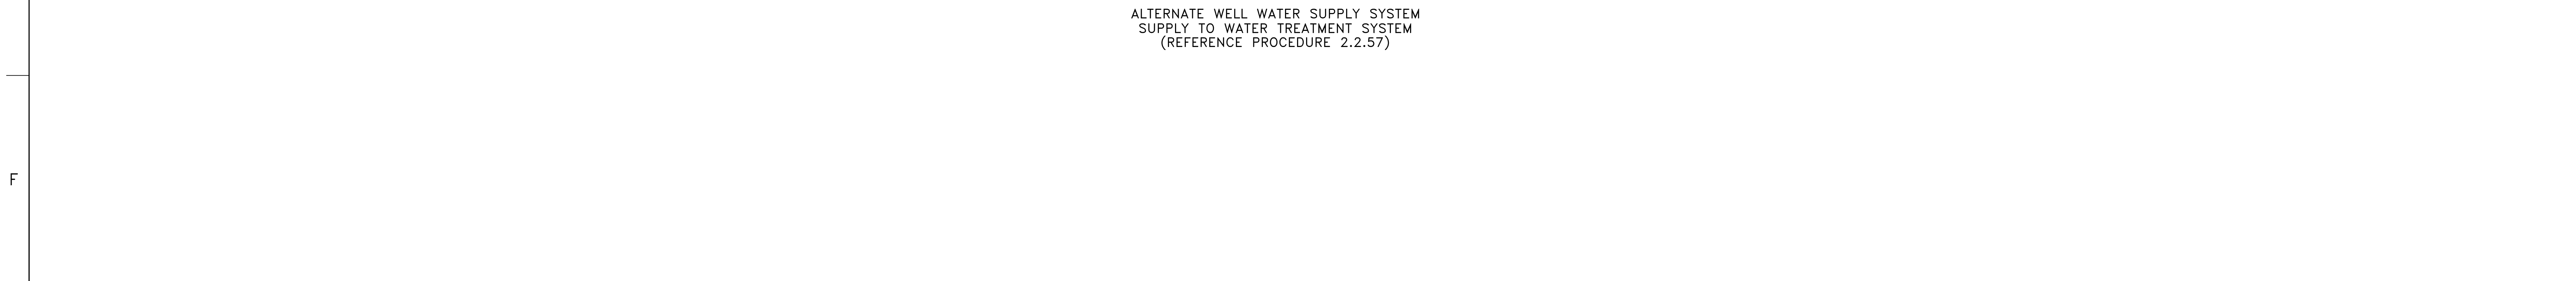

- NOTES:
1. DELETED
  2. HEAVY LINES INDICATE EQUIPMENT & PIPING FURNISHED AND INSTALLED UNDER CONTRACT E69-4.
  3. LIGHT LINES INDICATE EQUIPMENT & PIPING FURNISHED BY OTHERS AND INSTALLED UNDER CONTRACT E69-4.
  4. UNLESS OTHERWISE INDICATED ALL PRESSURE AND FLOW INSTRUMENT ROOT VALVES SHALL BE 3/4" LINES UP TO AND INCLUDING ROOT VALVES SHALL BE FURNISHED AND INSTALLED UNDER CONTRACT E69-4.
  5. DELETED
  6. DELETED
  7. AT SAMPLING POINTS SP-32 & SP-52, CONNECTIONS, PROBES AND ROOT VALVES SHALL BE FURNISHED AND INSTALLED UNDER CONTRACT E69-4. PROBES SHALL BE FURNISHED AND INSTALLED IN ACCORDANCE WITH CONTRACT PARAGRAPH 3.4.2 AND DWG. SP-07211; FIGURE NUMBER AS NOTED. ALL OTHER SAMPLING POINTS ARE SUPPLIED BY DEGREMONT-COTTRELL AS INDICATED ON D.C. DWGS. CONTINUATION OF SAMPLE PIPING BY E70-3.
  8. WHERE LINES INTERCONNECT AND ARE CONTINUED ON OTHER DRAWINGS, ZONE NUMBERS ARE APPROXIMATE ONLY.
  9. HYDRA-PNEUMATIC PRESSURE MAINTENANCE SYSTEM NO LONGER USED AND ABANDONED IN PLACE.

NOTE: ALL ITEMS MARKED WITH [A] ARE "AS BUILT" ITEMS AND ARE NOT SHOWN ON PIPING DRAWINGS.

REVISIONS TO THIS DRAWING  
 REQUIRES A REVISION TO THE  
 CORRESPONDING ISOKEY.

VERSIONS/REVISIONS BY NPPD			
NO.	DESCRIPTION	ORDER/DFTI	DATE
1	AS BUILT	AE	06/28/02

SIGNIFICANT NUMBER		DRAWN		DATE	
1		HFY		06/28/02	
2		CHECKED		DATE	
3		APPROVED		DATE	
4		FILMED		DATE	
5		2034			
6		COOPER NUCLEAR STATION		BURNS & ROE	
7		FLOW DIAGRAM			
8		PLANT MAKE UP WATER			
9		TREATMENT SYSTEM			

AS BUILT  
 454003627  
 STATUS: Release  
 STATUS DATE: 12/22/2021  
 DS APPROVED: JEDAUDEL  
 VER: AE REV: 72 SIZE: F

C0017934