


TCC NUMBER: 5470720
 DC# 2022-0619
 DRAFTER: DJB
 ASSIGNED ENG: JOMADDO
 DATE: 11/21/2022

NOTE:
 FOR NOTES SEE THIS DWG. SHT. 1

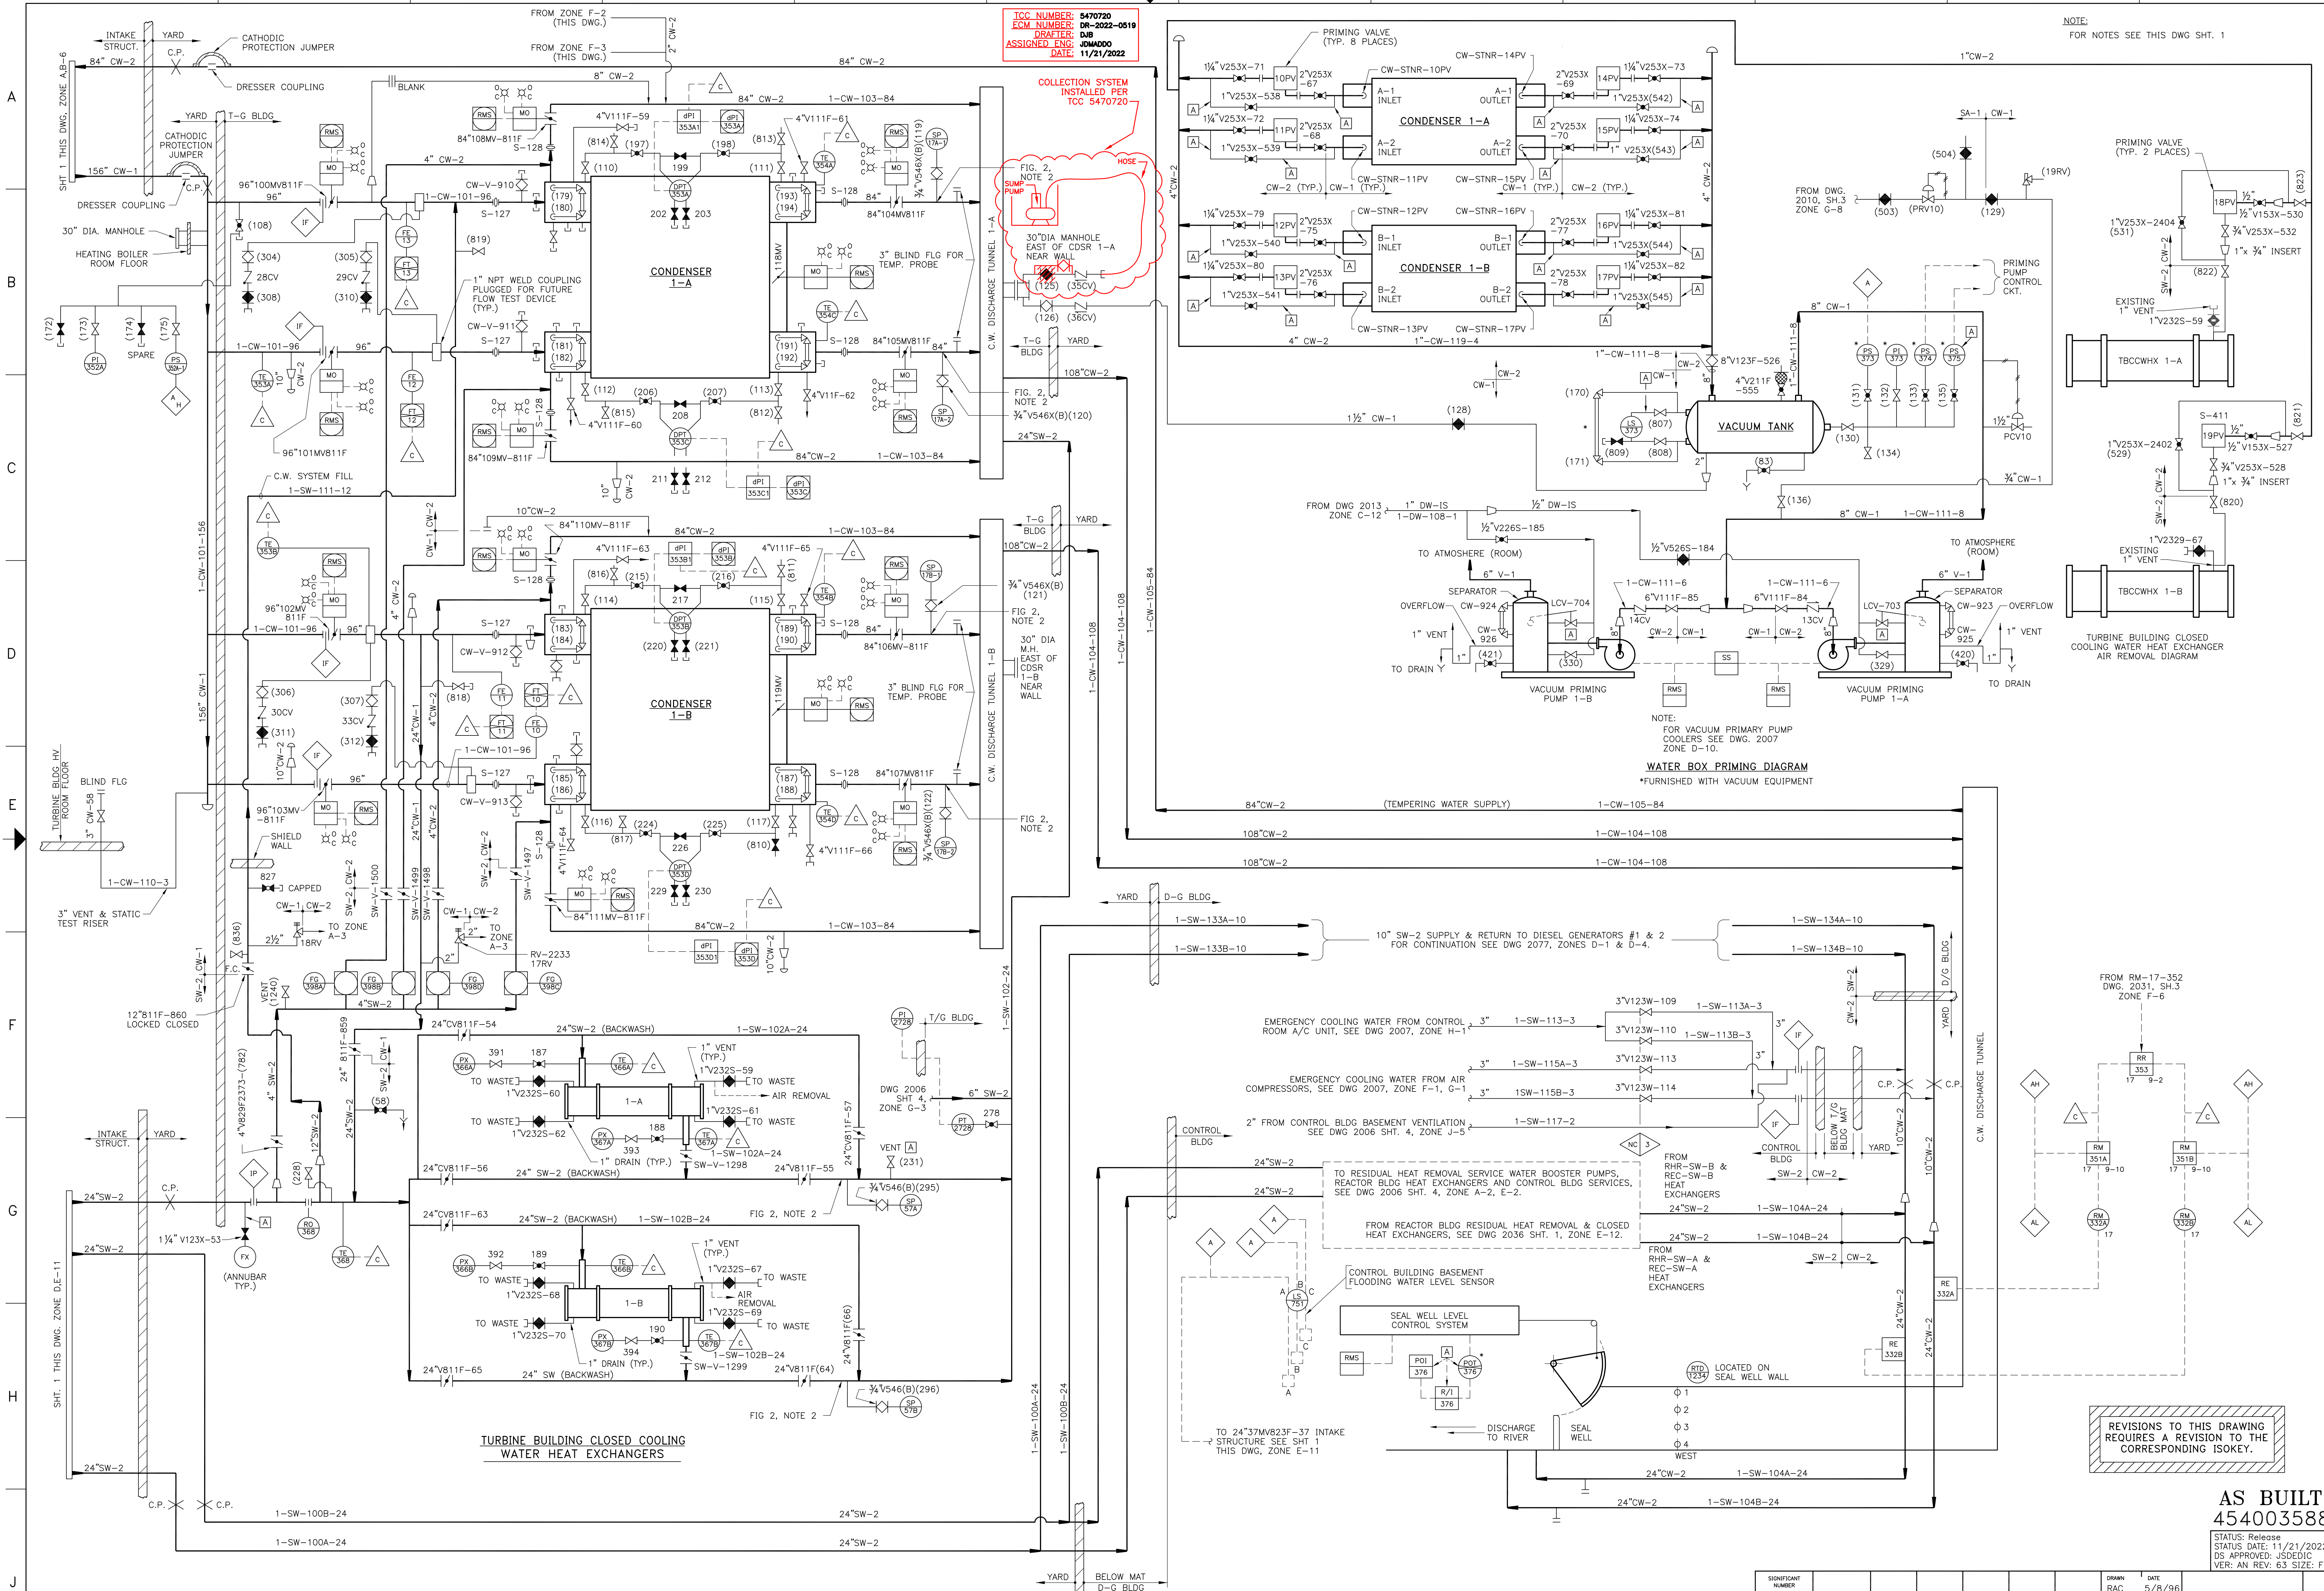

COLLECTION SYSTEM
 INSTALLED PER
 TCC 5470720

NOTE:
 FOR VACUUM PRIMARY PUMP
 COOLERS SEE DWG. 2007
 ZONE D-10.
WATER BOX PRIMING DIAGRAM
 *FURNISHED WITH VACUUM EQUIPMENT

REVISIONS TO THIS DRAWING
 REQUIRES A REVISION TO THE
 CORRESPONDING ISOKEY.

AS BUILT
 454003588
 STATUS: Release
 STATUS DATE: 11/21/2022
 DS APPROVED: JSDEDC
 VER: AN REV: 63 SIZE: F

NO.	DESCRIPTION	ORDER DFT	DATE	ENG
AK/760	DR-2022-0001		01/3/22	JOMADDO
AK/710	DR-2022-0352 (TCC INSTALLATION)		04/28/22	JOMADDO
AK/620	DR-2022-0352 (TCC REMOVAL)		04/28/22	JOMADDO
AK/630	DR-2022-0519 (TCC INSTALLATION)		04/28/22	JOMADDO

SIGNIFICANT NUMBER	GROUP	DATE	DATE	DATE	DATE	DATE	DATE
1							
2							
3							
4							
5							
6							
7							
8							
9							
10							
11							
12							

FLOW DIAGRAM
 CIRCULATING, SCREEN WASH & SERVICE
 WATER SYSTEMS
 COOPER NUCLEAR STATION

DRAWN: RAC
 CHECKED: DATE
 APPROVED: DATE
 FILMED: DATE

BURNS & ROE
 2006 SH 3