

- NOTE:
1. UNLESS OTHERWISE SPECIFIED ALL PIPE SHALL BE FDR-2
 2. ALL VALVE NUMBERS IN PARENTHESIS () ARE NUMBERS TO BE USED IN OPERATING PROCEDURES. THESE NUMBERS ARE ASSIGNED BY NPPD AND WILL NOT APPEAR ON PIPING DRAWINGS.
 3. △ WHERE SHOWN WITH NUMBERS REPRESENT POINTS OF CONNECTION TO EXISTING SYSTEMS. E73-58 SPECIFICATION DEFINES WORK FROM THIS POINT.
 4. WHERE LINES INTERCONNECT AND ARE CONTINUED ON OTHER DRAWINGS, ZONE NUMBERS ARE APPROXIMATE ONLY.
 5. FLOOR DRAIN SEALED WITH GROUT PER CED 6014761.
 6. EQUIPMENT ABANDONED IN PLACE.

REVISIONS TO THIS DRAWING
REQUIRES A REVISION TO THE
CORRESPONDING ISOKEY.

AS BUILT

454003605

STATUS: Release
STATUS DATE: 03/02/2022
DS APPROVED: LJJENSE
VER: AF REV: 19 SIZE: F


VERSIONS/REVISIONS BY NPPD			
NO.	DESCRIPTION	ORDER DFT	DATE
AD77	DR-2020-0021	20-001	DLR 6/16/20
AF718	DR-2021-0085	504-595	DLR/07/27/21
AF719	DR-2022-0001	504-595	DLR/03/22/22

SIGNIFICANT NUMBER		DRAWN		DATE	
GROUP	HYF	HYF	DATE	HYF	DATE
1			5/13/02		
2					
3					
4					
5					
6					

COOPER NUCLEAR STATION
FLOW DIAGRAM
TURB. & RADWASTE BLDG. CONTAMINATED
FL. DRAIN & RADWASTE ROOF DRAIN SYS.

BURNS & ROE

2017

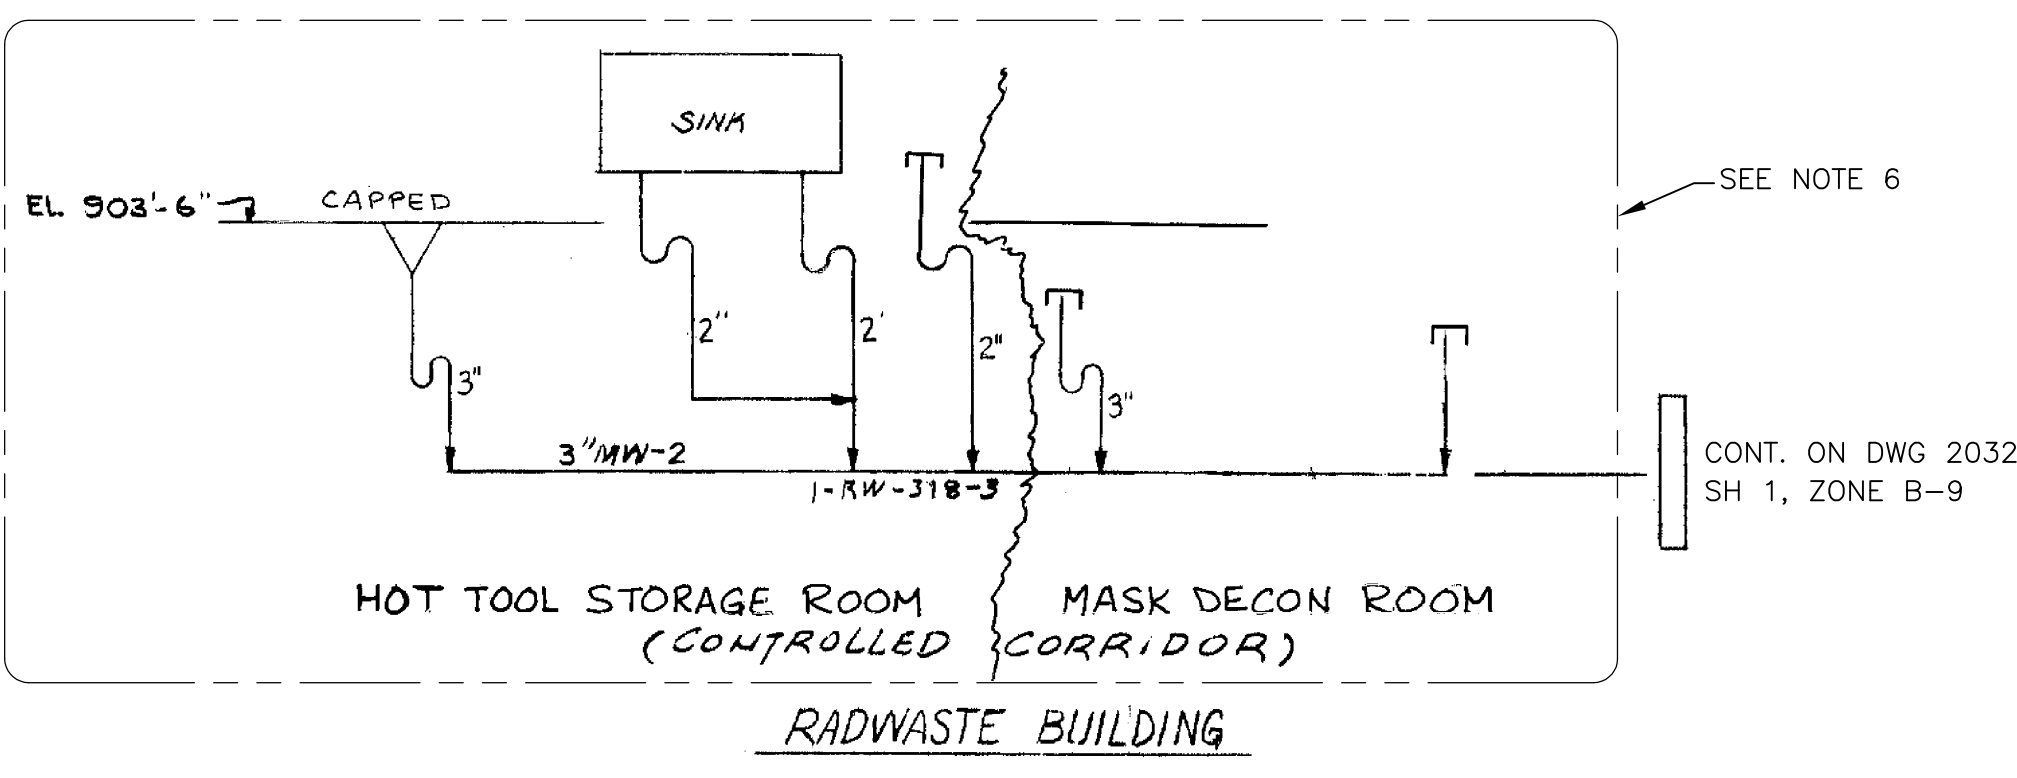

SEE NOTE 6
CONT. ON DWG 2032
SH 1, ZONE B-9

TO STORM
SEWER
FOR CONT. SEE
DWG.

00172917