


PLAN VIEW SUPPRESSION CHAMBER

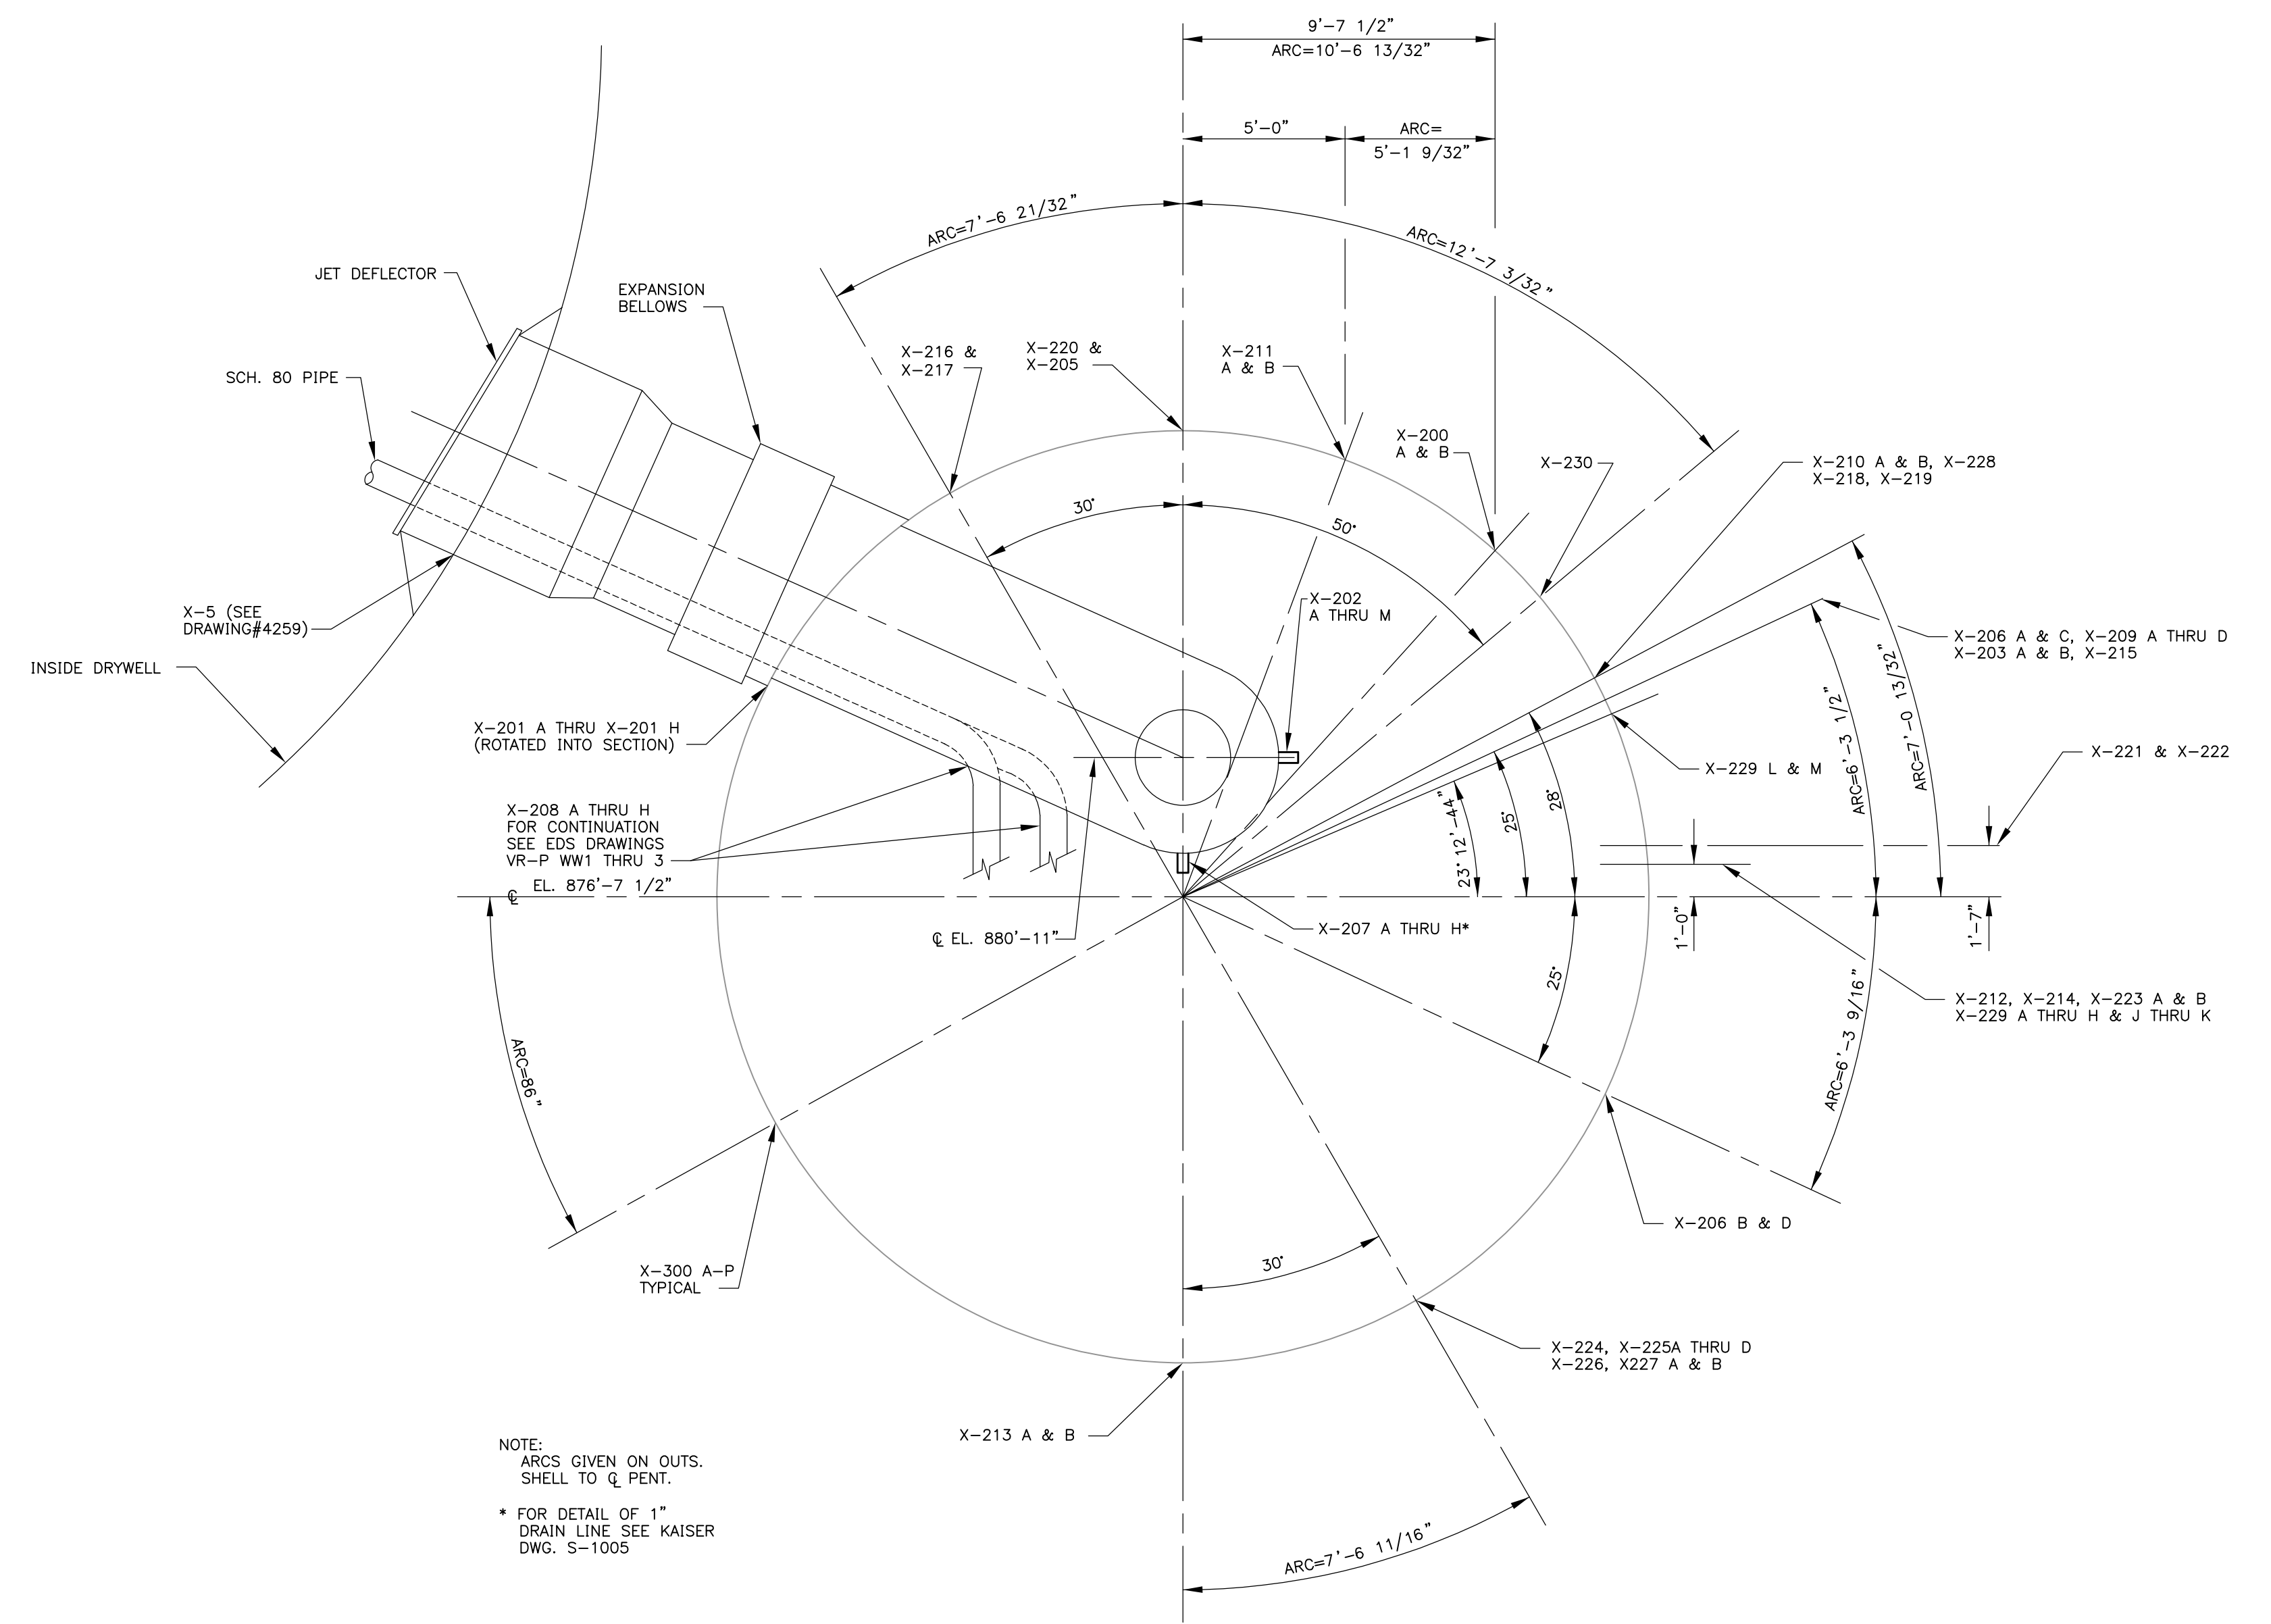

COMPOSITION SECTION

ROTATE COUNTER CLOCKWISE

NOTE:  
 ARCS GIVEN ON OUTS.  
 SHELL TO Q. PENT.  
 \* FOR DETAIL OF 1" DRAIN LINE SEE KAISER DWG. S-1005

NOTES:

1. ALL PENETRATIONS ARE SHOWN IN THEIR APPROXIMATE LOCATIONS. LOCATIONS WERE TAKEN FROM BURNS AND ROE DRAWING 4260 SHT. 2 AND CHICAGO BRIDGE AND IRON COMPANY DRAWING # 5.

NO.	REVISIONS

REVISIONS BY N.P.P.D.					
NO.	REVISIONS	DFT	CHK	APP	DATE
000	CR96-0160 (CCN 97-0097)	SPB	JEH	JRF	1-31-97

\* THIS DRAWING GENERATED BY NPPD

SIGNIFICANT NUMBER	1	2	3	4	5	6	DRAWN SPB	DATE 3/22/96	BURNS & ROE*	
	GROUP									CHECKED JEH
CONTAINMENT SUPPRESSION CHAMBER PENETRATION LOCATION SHEET 2A								APPROVED JRF	DATE 1/31/97	
								FILMED	4260	REVISION NOO

DO NOT REVISE MANUALLY

454243227  
 AS BUILT

CADD DRAWING

C0012743