




800099-1HN-1

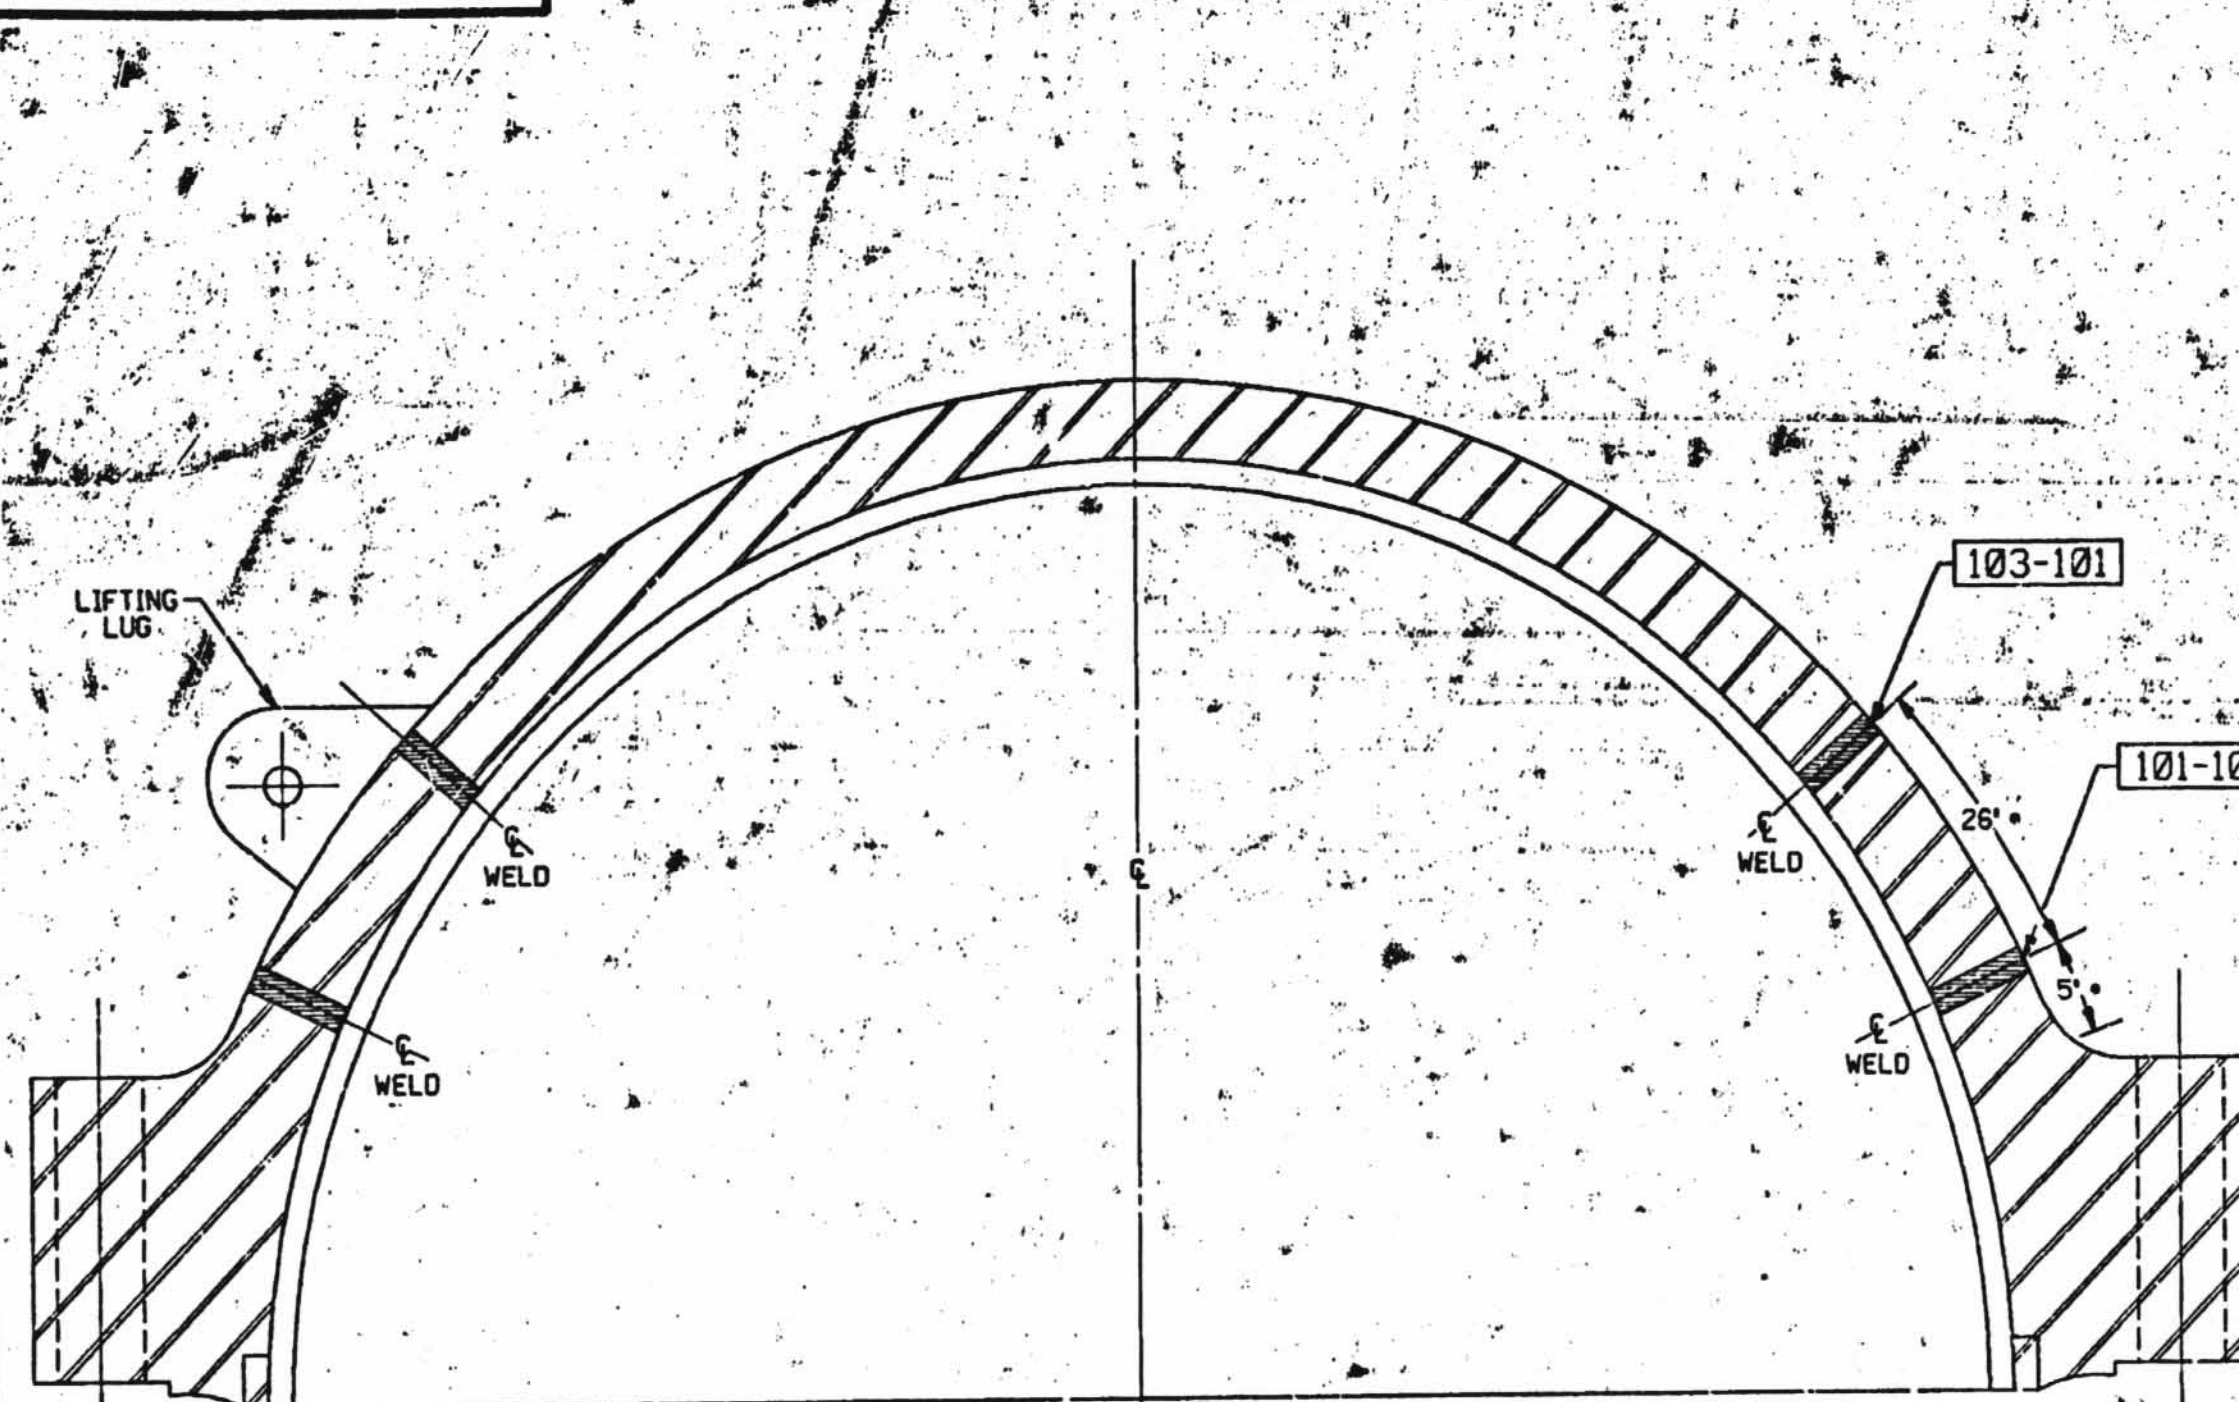


SECTION 'D-D'

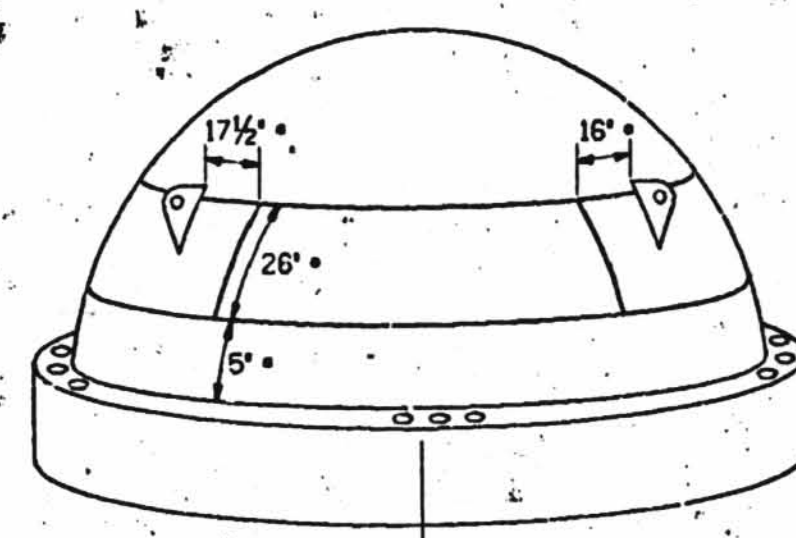

VIEW 'E-E'

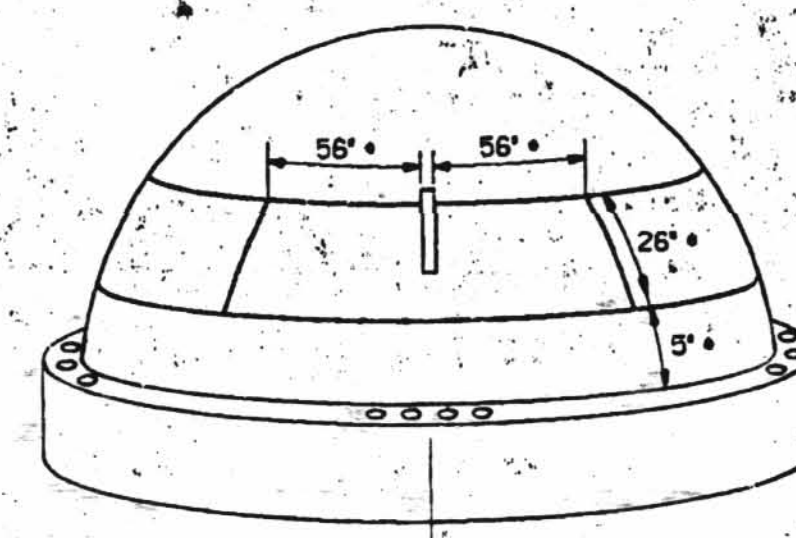


VIEW 'F-F'

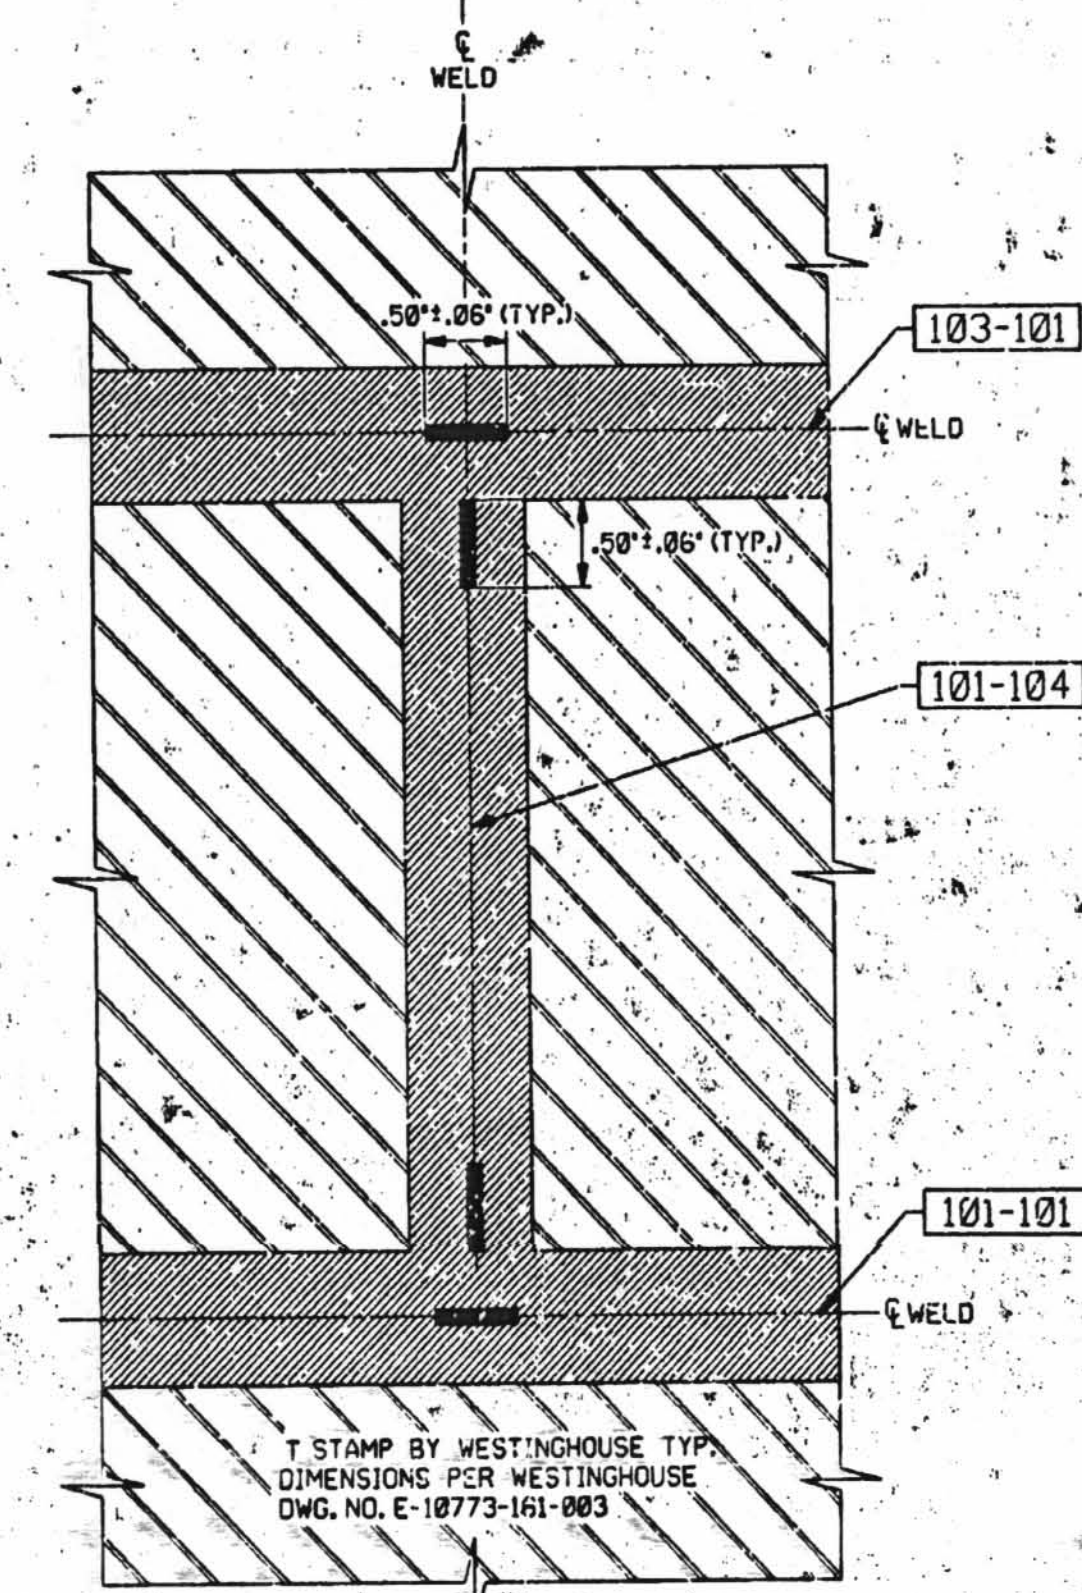

DETAIL 'A'

- NOTES:
1. DRAWING NOT TO SCALE.
 2. DIMENSIONS (") ARE FIELD DIMENSIONS.
 3. DISTANCE FROM LIFTING LUG IS MEASURED FOLLOWING UPPER WELDED SEAM CENTER.
 4. MEASUREMENTS TO BE TAKEN WITH A FLEXIBLE TAPE FOLLOWING CONTOUR OF HEAD ASSEMBLY.
 5. WELD IDENTIFICATION NOS. HAVE THE PREFIX 1-SB-RV-
 6. WORK THIS DRAWING WITH 650007, 650008 AND 650010.
 7. WESTINGHOUSE SHOP ORDER NSS-105

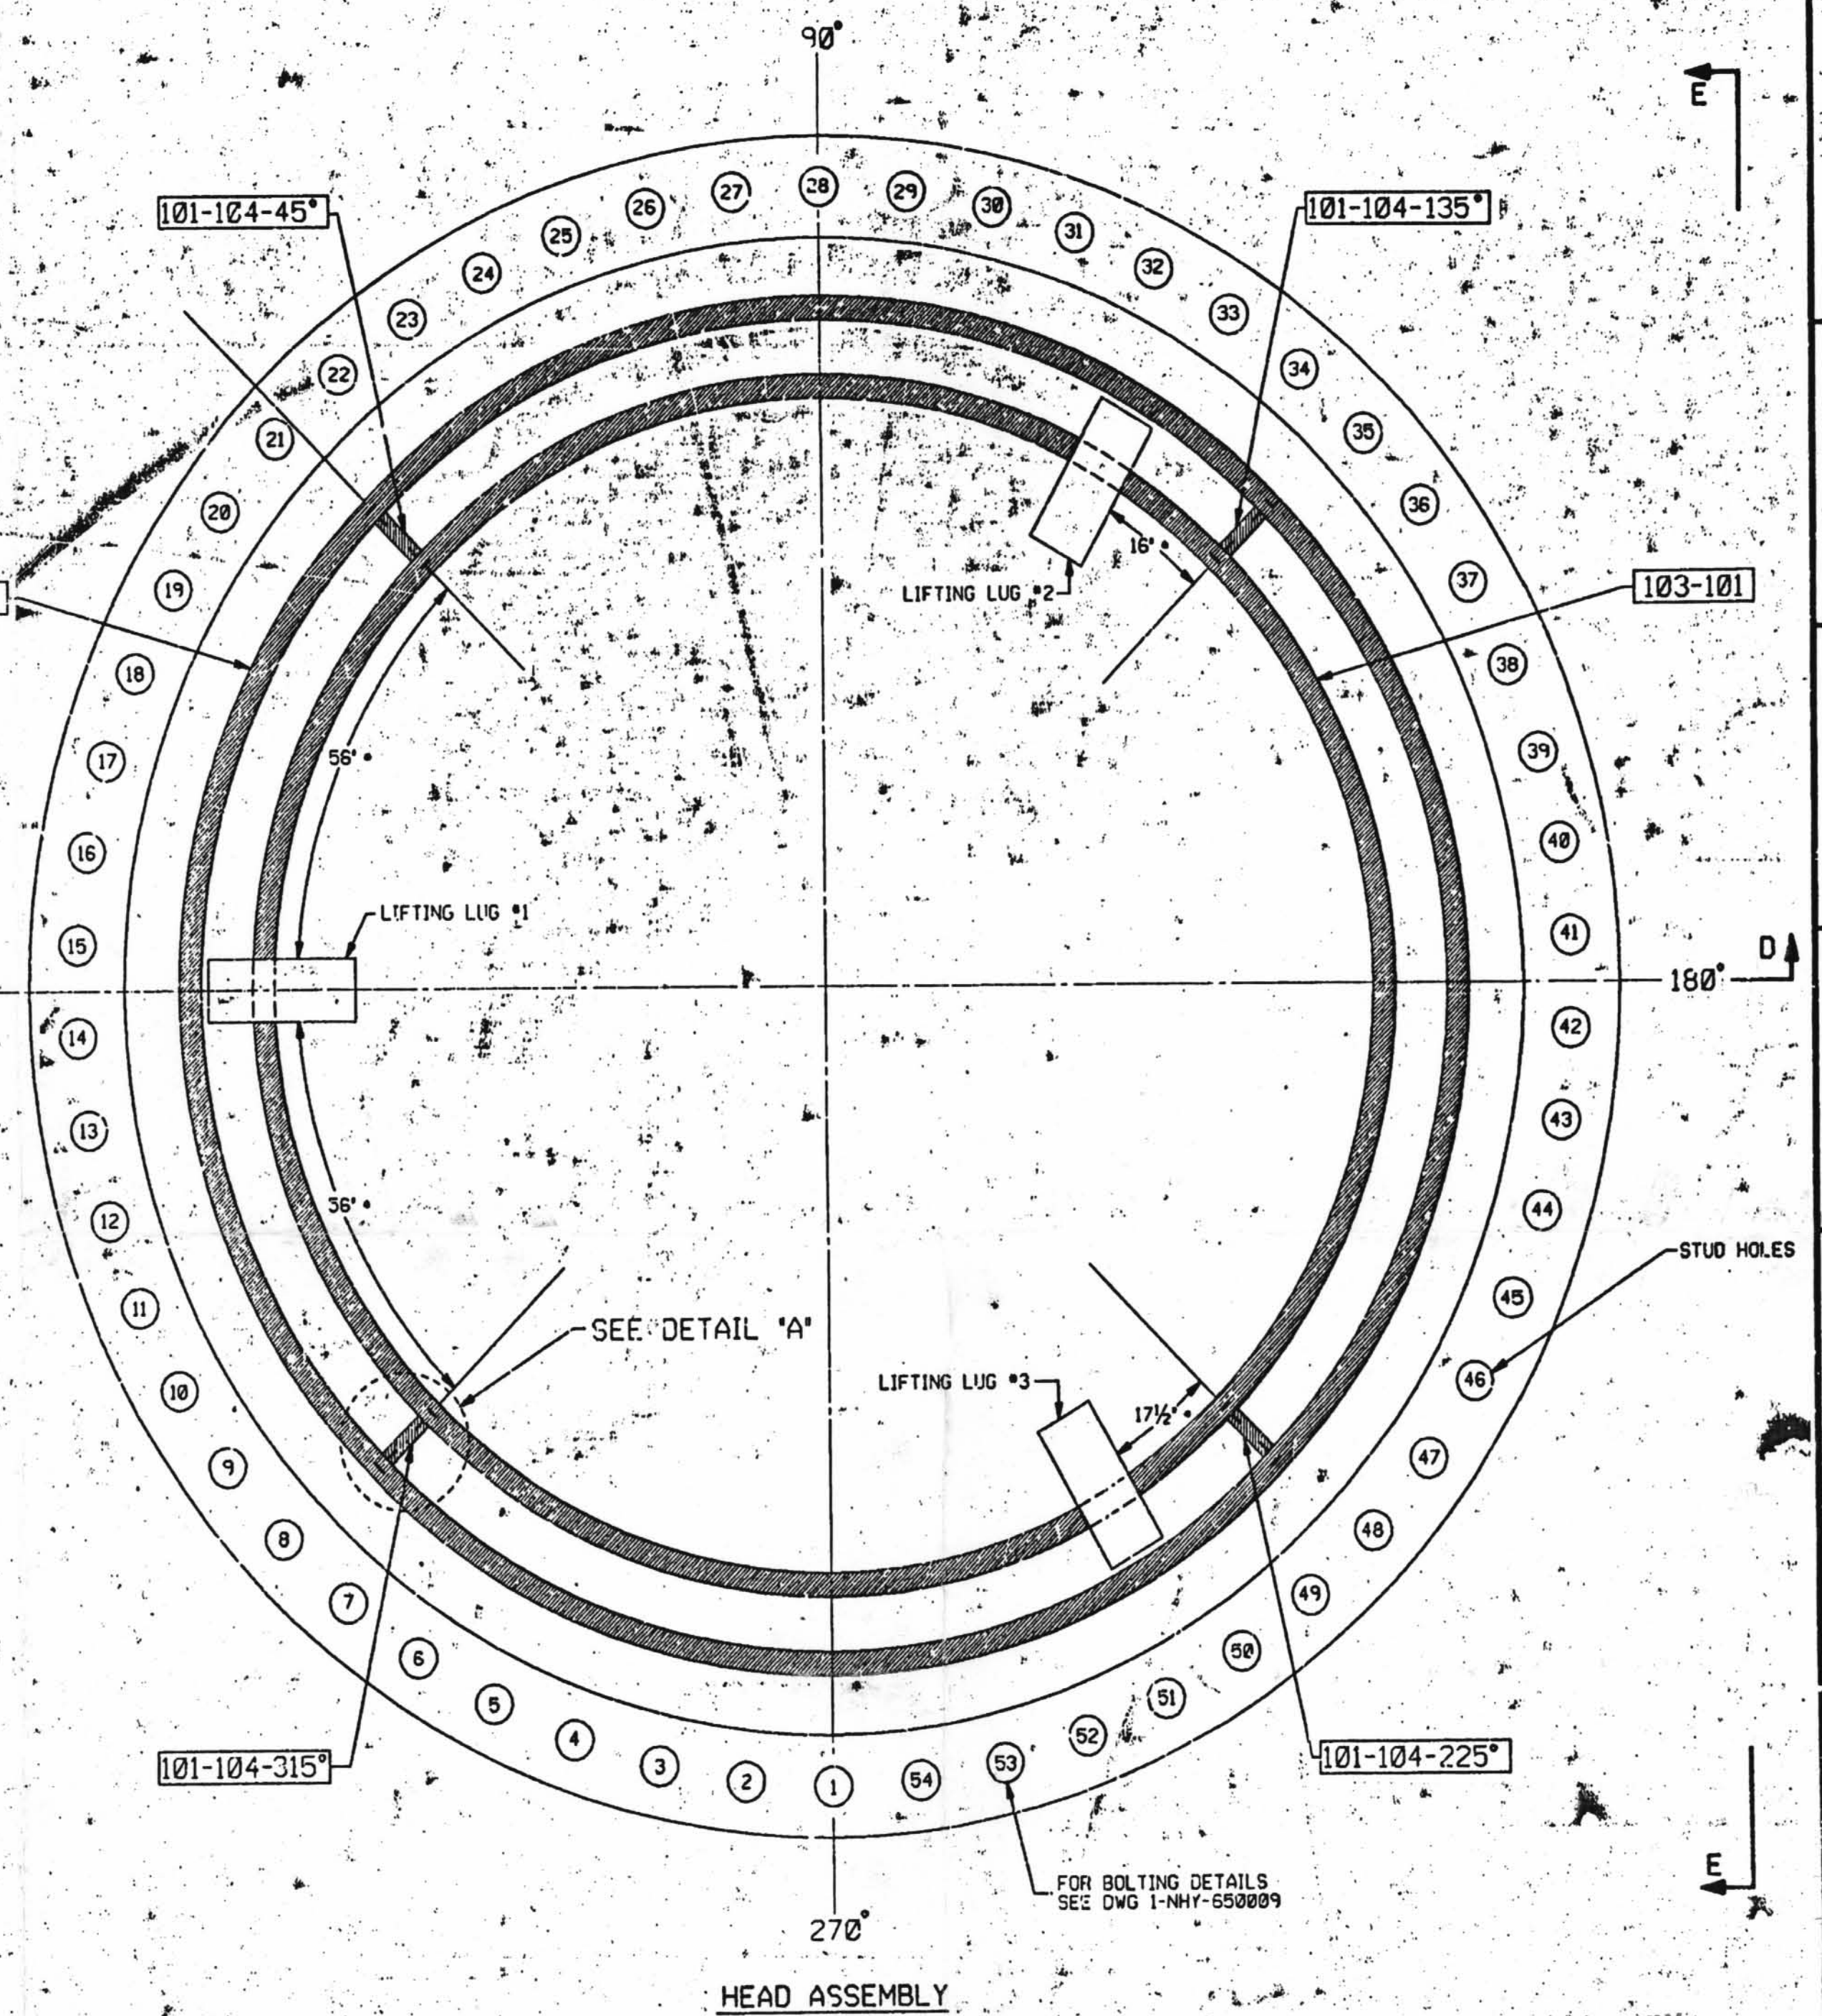

HEAD ASSEMBLY

FOR INFORMATION ONLY

REV		DATE	DSGN	DRWN	CHKD	BY	DATE	DESCRIPTION
1		3/7/51	MPW	JM	DR	DR		ORIGINAL ISSUE
PP-32668 REF. DRAWING NO. 01 REV AS-BUILT LOCATION OF WELD SEAMS TITLE SEABROOK STATION								
REACTOR VESSEL RC-E-1 ISI EQUIPMENT WELDS 1-NHY-650008								

D-9