


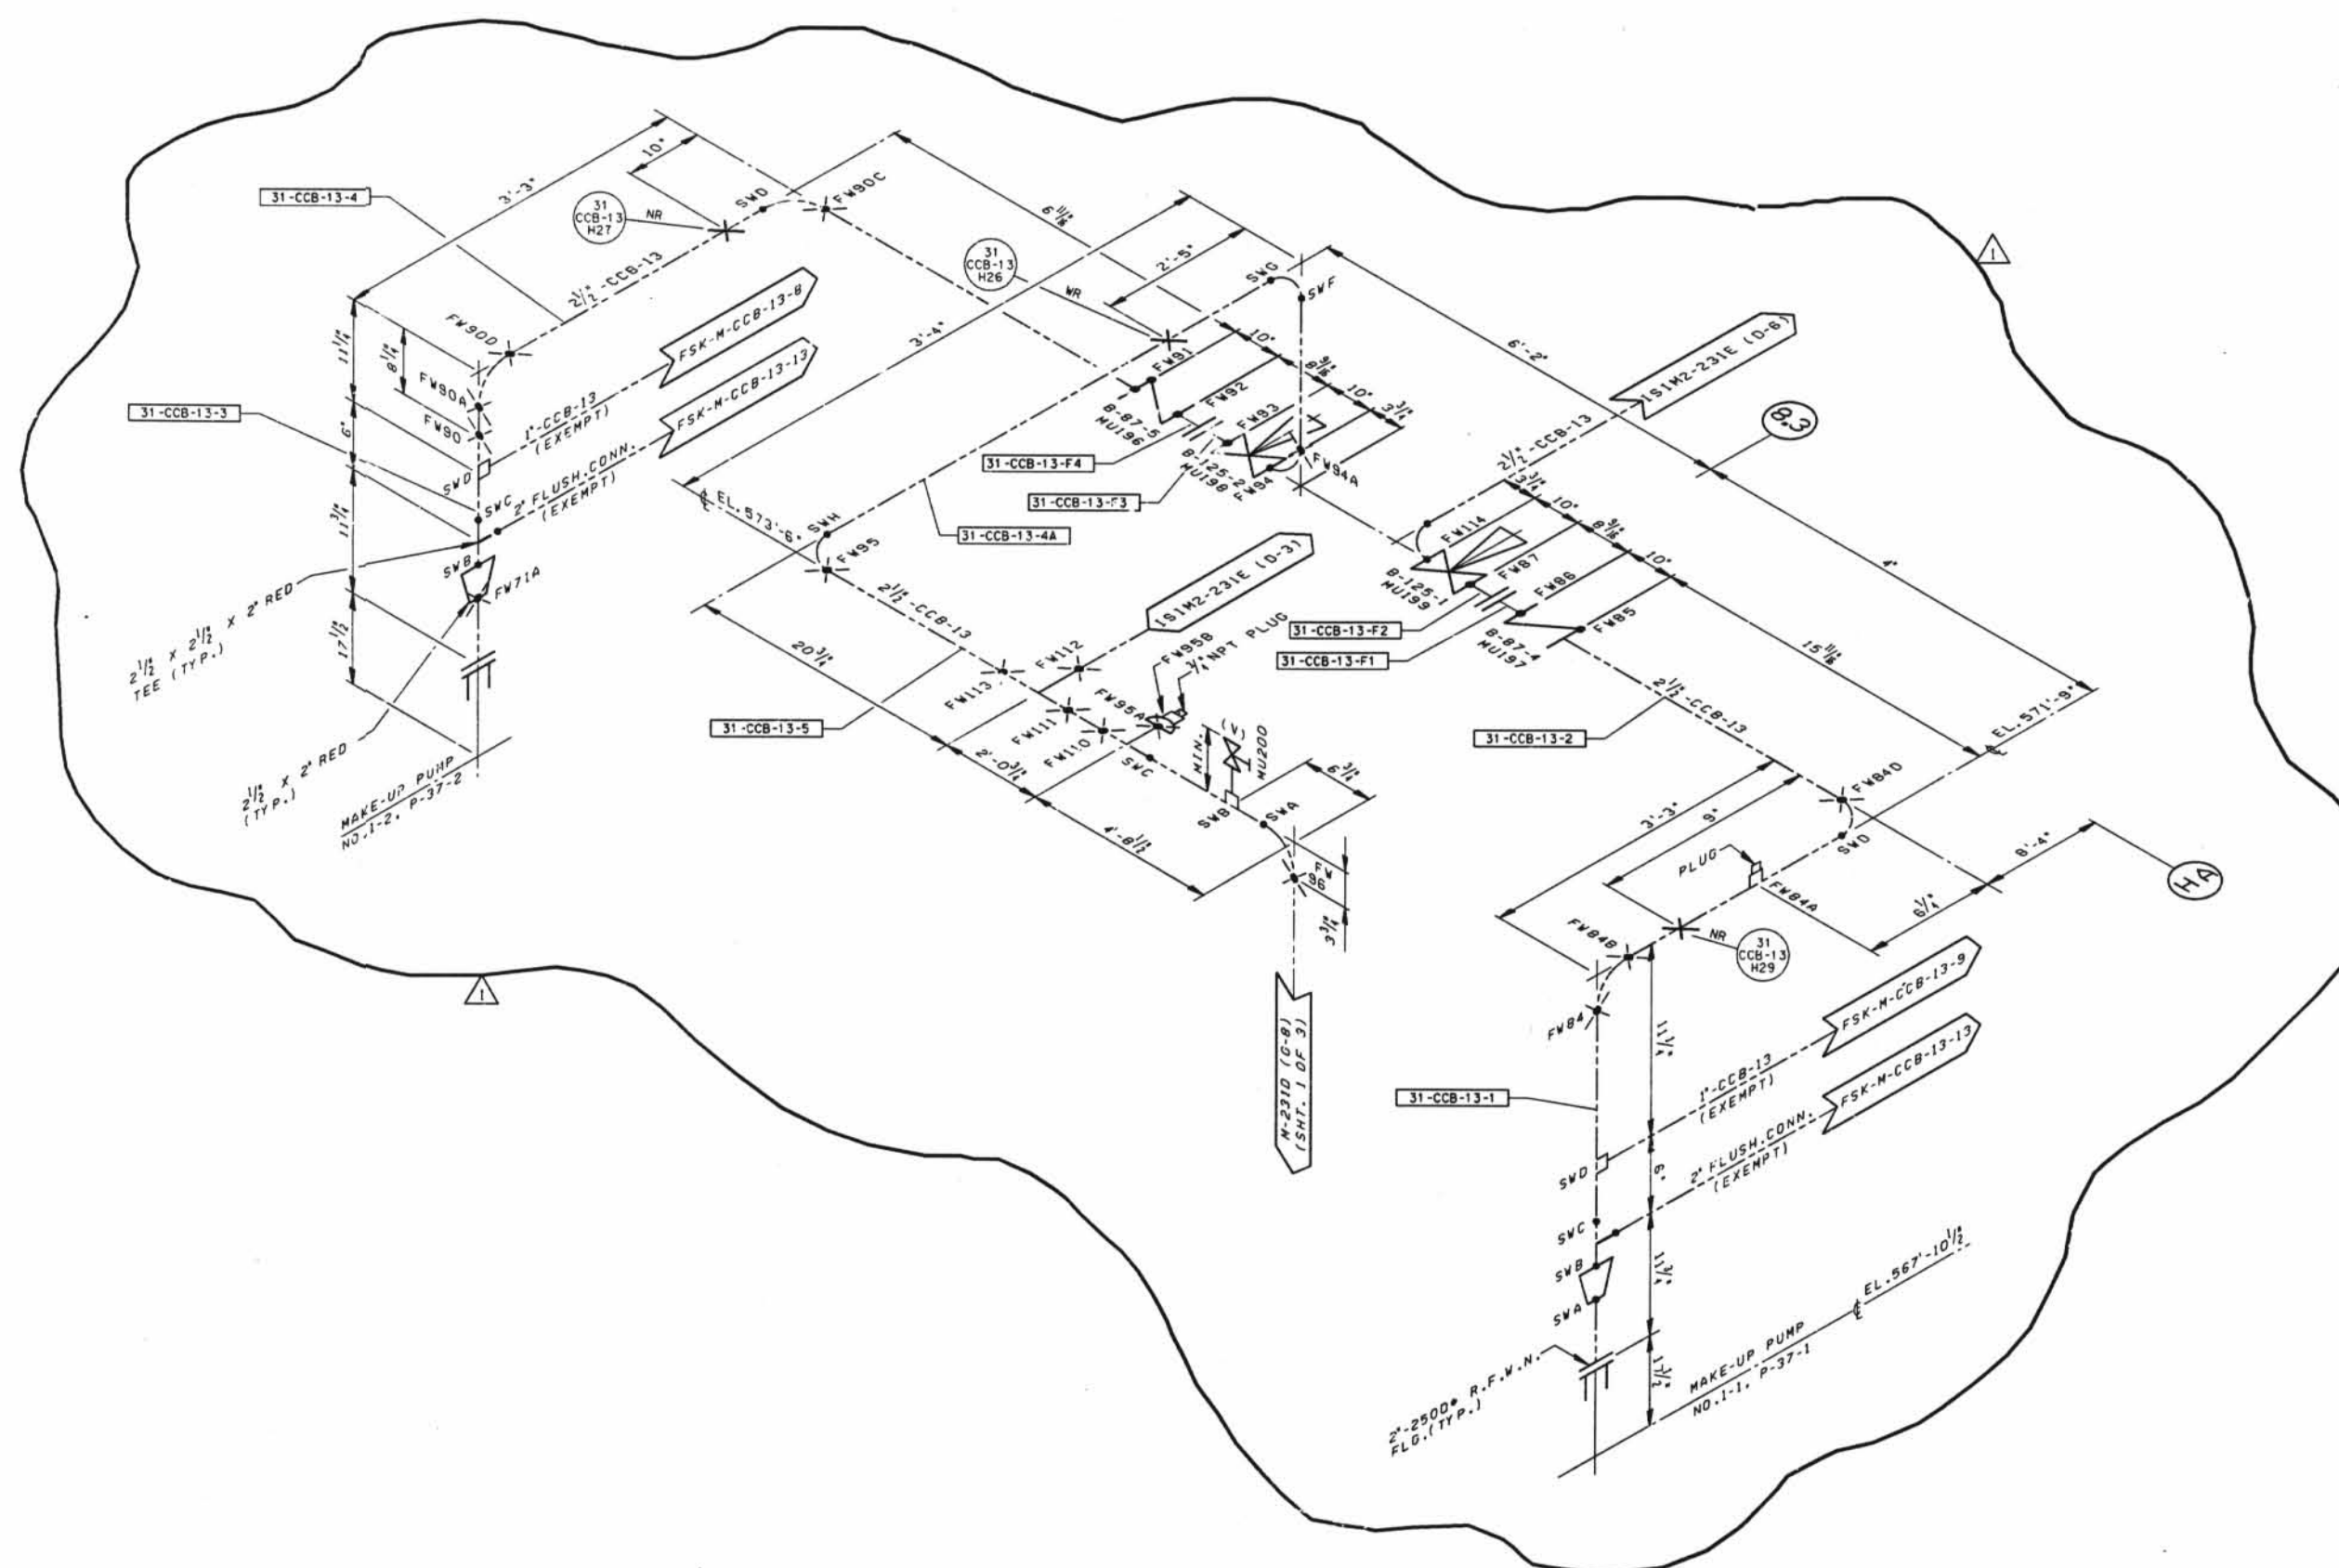

LEGEND

- ASME SECTION XI CLASS 1 PIPING
- ASME SECTION XI CLASS 2 PIPING
- ASME SECTION XI CLASS 3 PIPING
- NON-ISI NUCLEAR CLASS AND HSC CLASS
- PRESSURE BOUNDARY EXTENSION
- REFERENCE & CONTINUITY
- D - D- HVAC DUCT

- | | |
|-----|------------------------------------|
| A | ANCHOR |
| CS | CONSTANT SPRING HANGER |
| V5 | VARIABLE SPRING HANGER |
| HS | HYDRAULIC SNUBBER |
| MS | MECHANICAL SNUBBER |
| N | NON-WELDED SUPPORT ATTACHMENT |
| W | WELDED INTEGRAL SUPPORT ATTACHMENT |
| R | RIGID SUPPORT |
| T | SWAY STRUT |
| SW | SHOP WELD |
| FW | FIELD WELD |
| WL | LONGITUDINAL WELD |
| WOL | WELDJOINT |

NOTES:

1. MULTIPLE SWAY STRUTS, SPRING SUPPORTS OR SMUBBERS IN A SINGLE PIPING SUPPORT ARE SHOWN BY A NUMBER BEFORE THE SUPPORT TYPE. (EXAMPLE: 2NHS TWO HYDRAULIC TYPE SMUBBERS THAT ARE NOT WELDED INTEGRAL TO THE PIPE).
2. THE PIPING SYSTEMS ON THIS DRAWING ARE OUTSIDE OF THE ISI BOUNDARY. THEY ARE SHOWN FOR REFERENCE AND CONTINUITY PURPOSES ONLY. THE CONFIGURATION SHOWN MAY NOT REPRESENT THE ACTUAL AS-BUILT CONDITION.

△ GENERAL NOTE

GENERAL NOTE
DIMENSIONS SHOWN ON THIS DRAWING ARE TO BE USED FOR APPROXIMATE LOCATION ONLY. USE DESIGN DRAWINGS FOR DIMENSIONAL VERIFICATION.

REFERENCE DRAWINGS:

ISID2-031C MAKEUP AND PURIFICATION SYSTEM

[illegible]