



LEGEND

- ASME SECTION XI CLASS 1 PIPING
- ASME SECTION XI CLASS 2 PIPING
- ASME SECTION XI CLASS 3 PIPING
- NON-ISI NUCLEAR CLASS AND HSC CLASS
- PRESSURE BOUNDARY EXTENSION
- REFERENCE B CONTINUITY
- D-D HYDRAULIC
- A ANCHOR
- CS CONSTANT SPRING HANGER
- VS VARIABLE SPRING HANGER
- HS HYDRAULIC SHUBBER
- MS MECHANICAL SHUBBER
- N NON-WELDED SUPPORT ATTACHMENT
- W WELDED INTEGRAL SUPPORT ATTACHMENT
- R RIGID SUPPORT
- T SWAY STRUT
- SW SHOP WELD
- FW FIELD WELD
- LW LONGITUDINAL WELD
- WOL WELDOLLET
- ISI ITEM NUMBER DESIGNATION USED IN THE FIRST 10 YEAR INSERVICE INSPECTION INTERVAL

NOTES:

- MULTIPLE SWAY STRUTS, SPRING SUPPORTS OR SHUBBERS IN A SINGLE PIPING SUPPORT ARE SHOWN BY A NUMBER BEFORE THE SUPPORT TYPE. (EXAMPLE: 2MS - TWO HYDRAULIC TYPE SHUBBERS THAT ARE NOT WELDED INTEGRAL TO THE PIPE).
- THE SPENT FUEL POOL COOLING LINE 10-HSC-24 WELDS AND SUPPORTS ARE EXEMPT FROM INSERVICE EXAMINATION REQUIREMENTS PER 10D 1220. THE WELDS AND SUPPORTS SHOWN MAY NOT REPRESENT THE ACTUAL AS-BUILT CONDITION.
- PIPING SYSTEMS ON THIS DRAWING WHICH ARE OUTSIDE OF THE ISI BOUNDARY, ARE SHOWN FOR REFERENCE AND CONTINUITY PURPOSES ONLY. THE CONFIGURATION SHOWN MAY NOT REPRESENT THE ACTUAL AS-BUILT CONDITION.


GENERAL NOTE:

DIMENSIONS SHOWN ON THIS DRAWING ARE TO BE USED FOR APPROXIMATE LOCATION ONLY. USE DESIGN DRAWINGS FOR DIMENSIONAL VERIFICATION.

REFERENCE DRAWINGS:

- IS102-033B DECAY HEAT TRAIN 1
- IS102-035 SPENT FUEL POOL COOLING SYSTEM

IS102-235A-3		ISSUED FOR SECOND TO YEAR ISI	
DATE	REVISIONS	BY	DATE
DAVIS-BESSE NUCLEAR POWER STATION			
UNIT NO. 1			
INSERVICE INSPECTION ISOMETRIC			
SPENT FUEL POOL COOLING SYSTEM			
AUXILIARY BUILDING-AREA 7			
IS102-235A		SHEET 2	

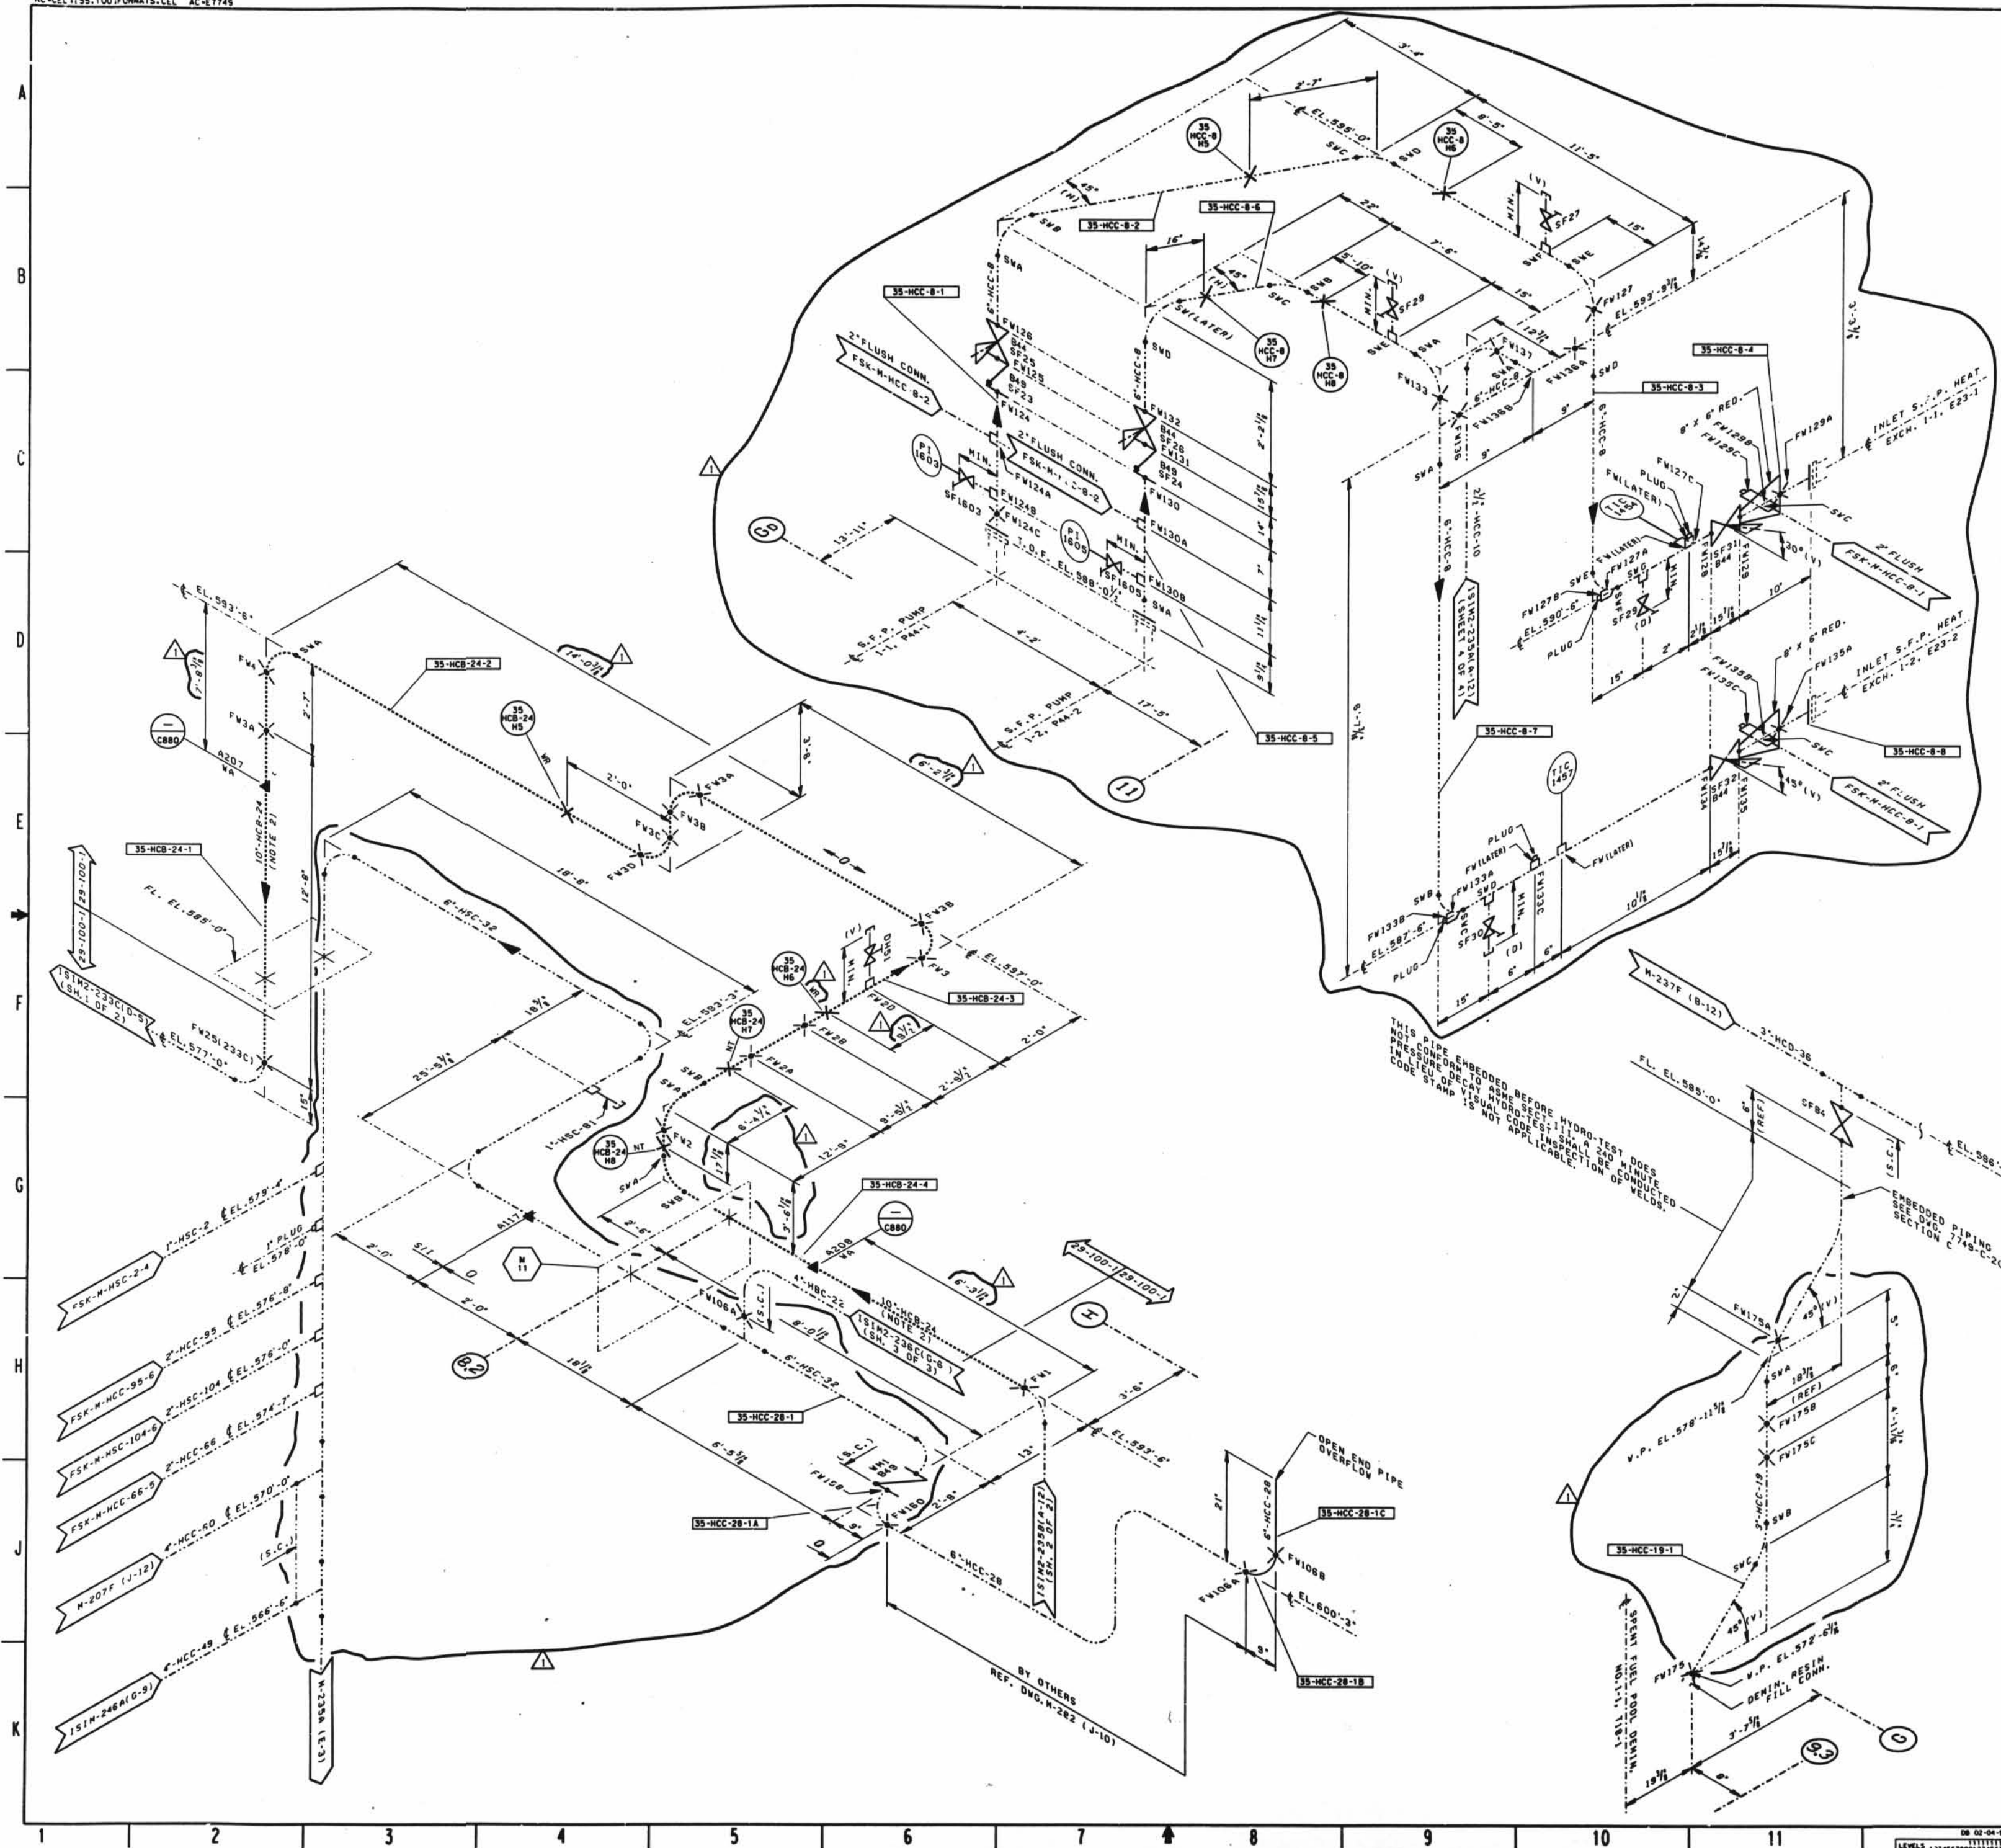

D-45