


SECTION A - A'
SCALE: 1" = 20'

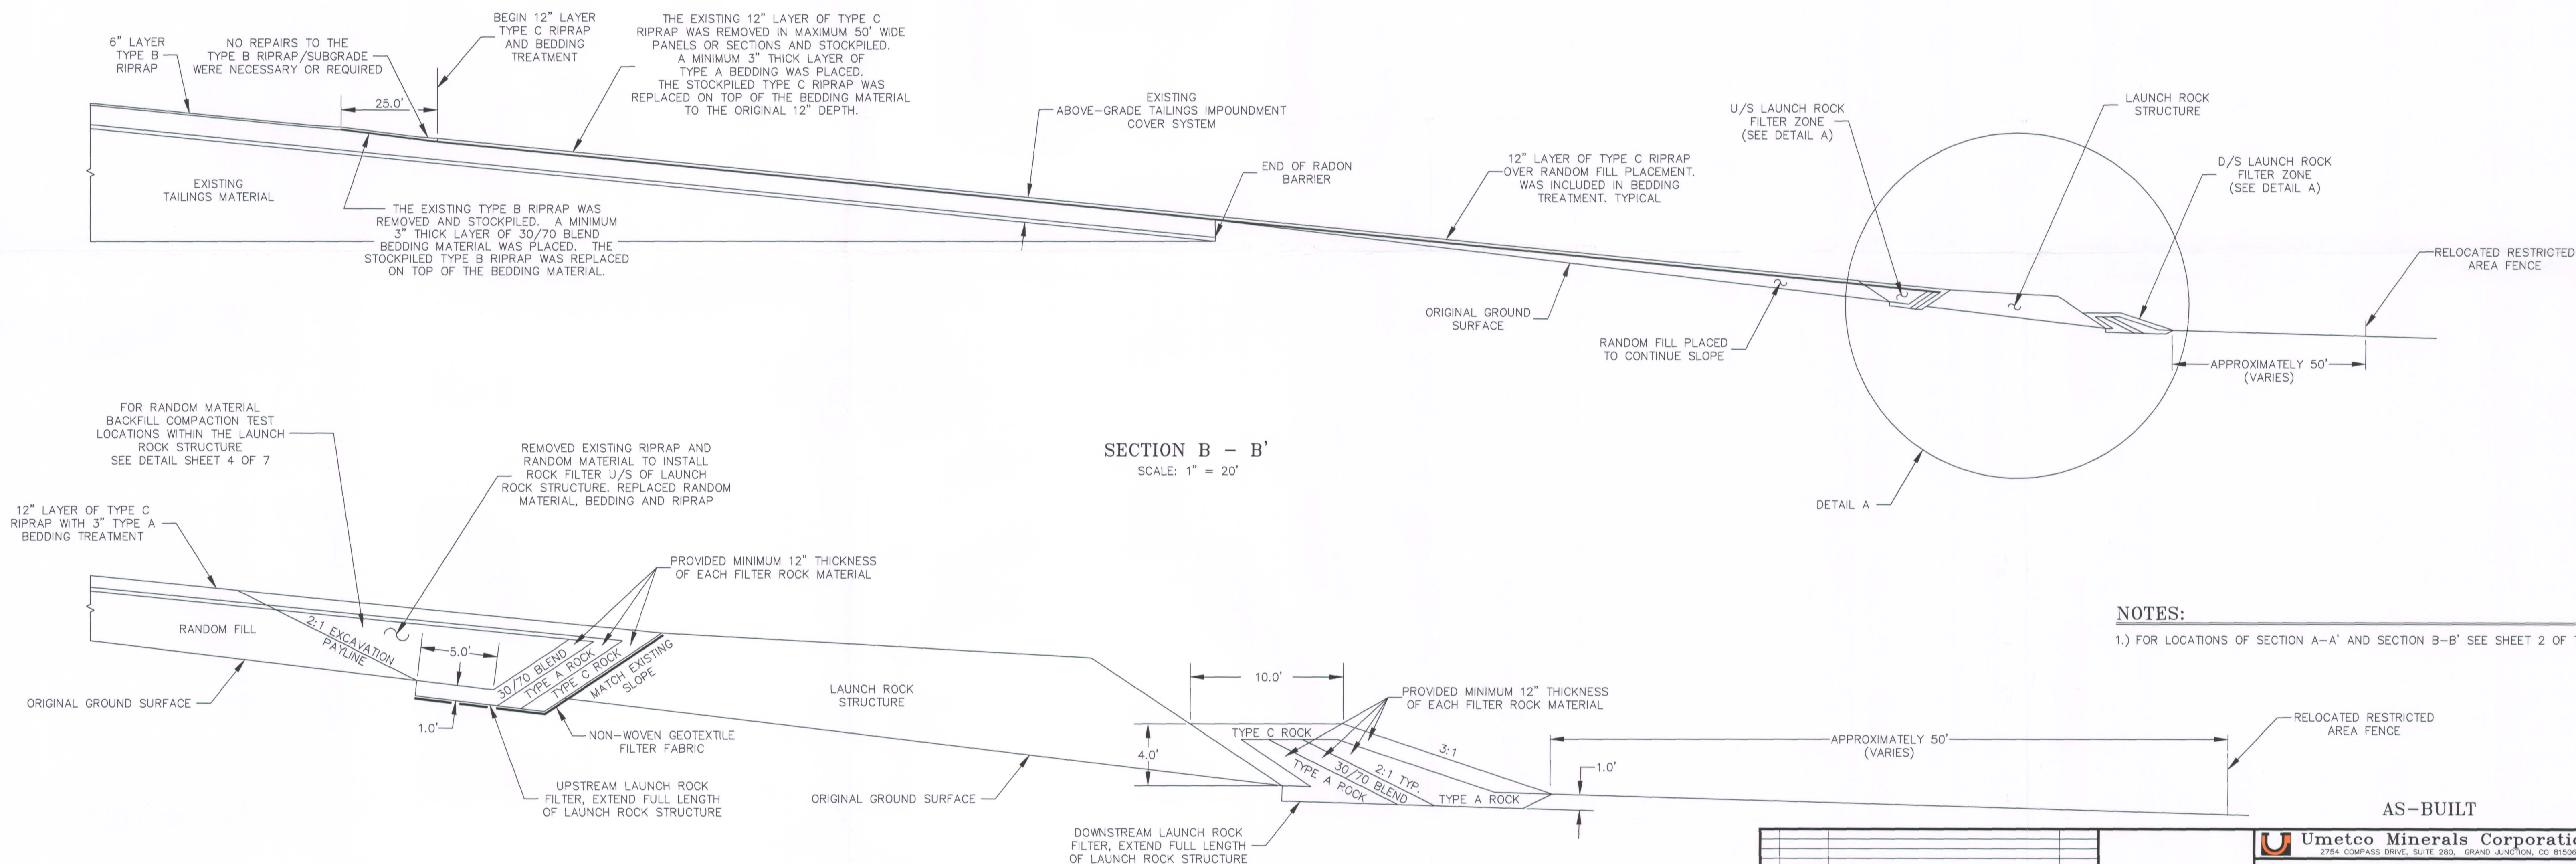

SECTION B - B'
SCALE: 1" = 20'

DETAIL A
SCALE: 1" = 5'

NOTES:
1.) FOR LOCATIONS OF SECTION A-A' AND SECTION B-B' SEE SHEET 2 OF 7.

AS-BUILT			
Umetco Minerals Corporation 2754 COMPASS DRIVE, SUITE 280, GRAND JUNCTION, CO 81506			
GAS HILLS, WYOMING			
ABOVE-GRADE TAILINGS IMPOUNDMENT DESIGN ENHANCEMENT EROSION AND RILL REPAIR PLAN SECTIONS AND DETAILS			
DESIGN: JHH	DRAWN: JHH	SHEET 3 OF 7	
CHECKED BY:	DATE: 12-8-2010		
ENGINEERING APPROVAL:	HS & EA APPROVAL:		
NO.	DATE	REVISION - DESCRIPTION	BY
1	1-2012	AS BUILT	R.W.G.
DWG: GH-AG-REPAIR-12-11-AB			

D03