



EAST GAS HILLS RECLAMATION PROJECT
NATRONA AND FREEMONT COUNTIES, WYOMING


FINAL CONSTRUCTION REPORT, ADDENDUM I
2011 ABOVE-GRADE TAILINGS IMPOUNDMENT
AND
A-9 REPOSITORY
EROSION PROTECTION ENHANCEMENT CONSTRUCTION
AS-BUILT DRAWINGS

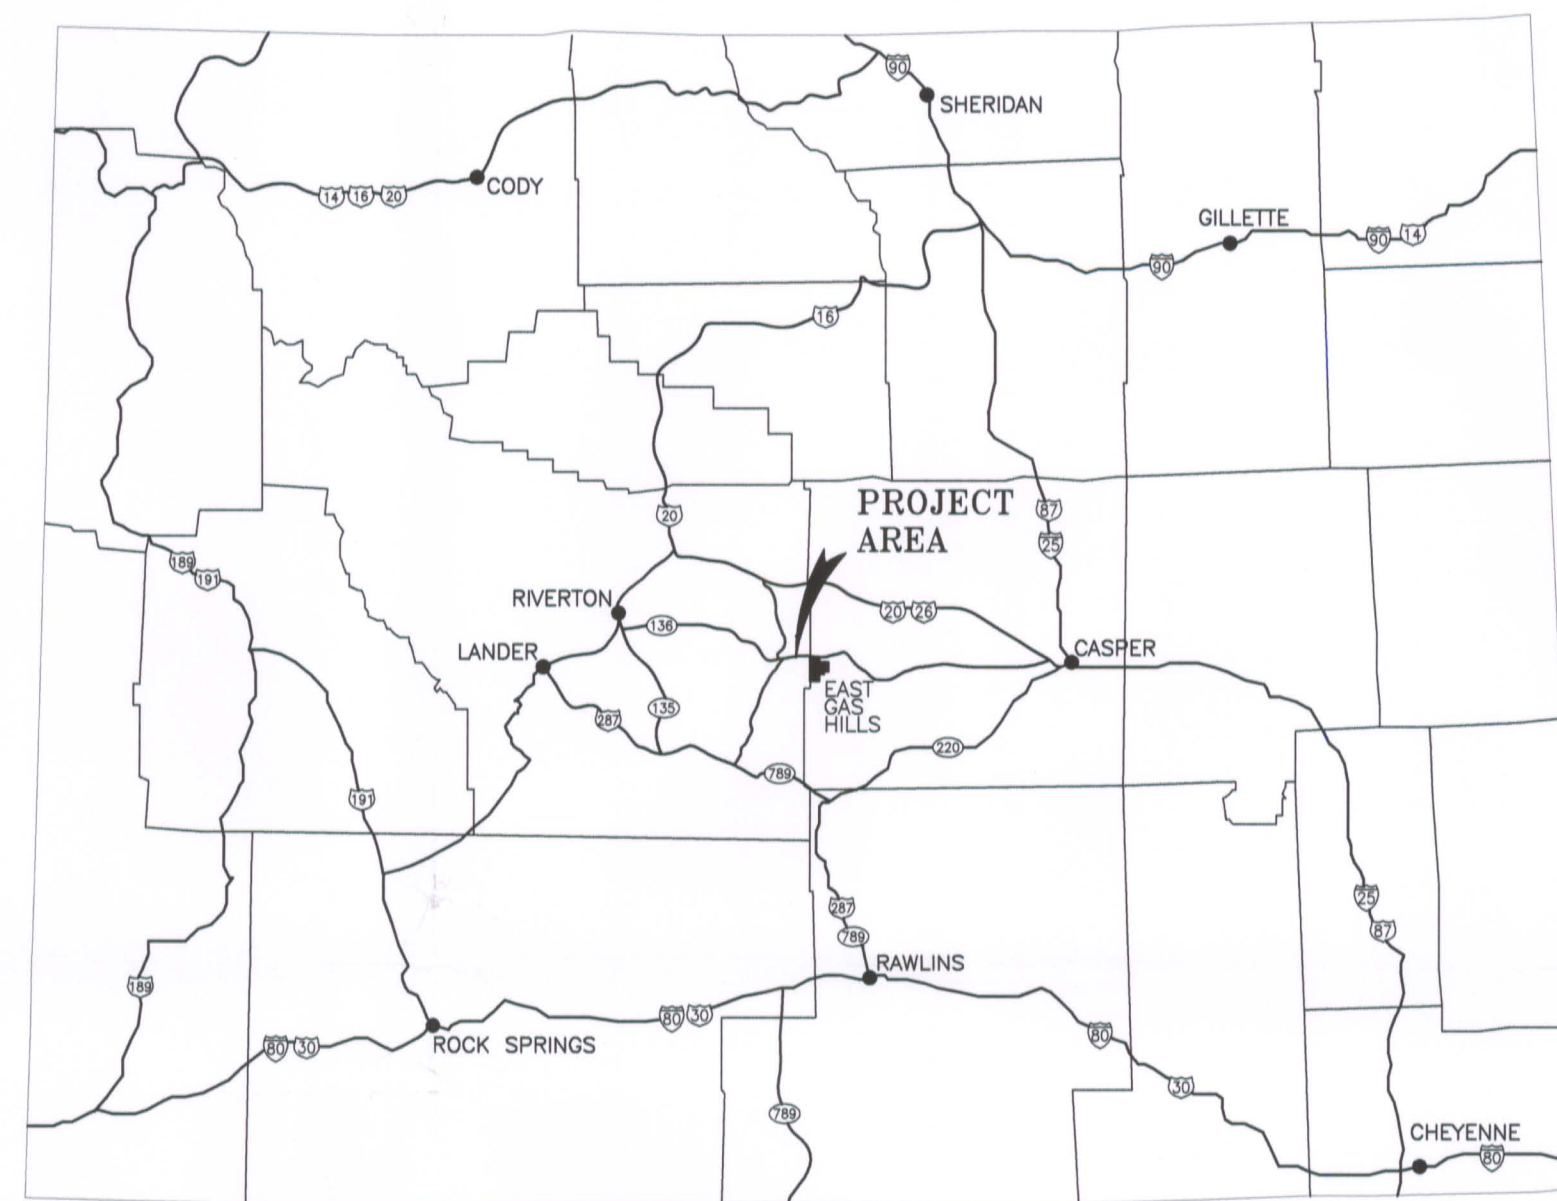

STATE OF WYOMING
NOT TO SCALE

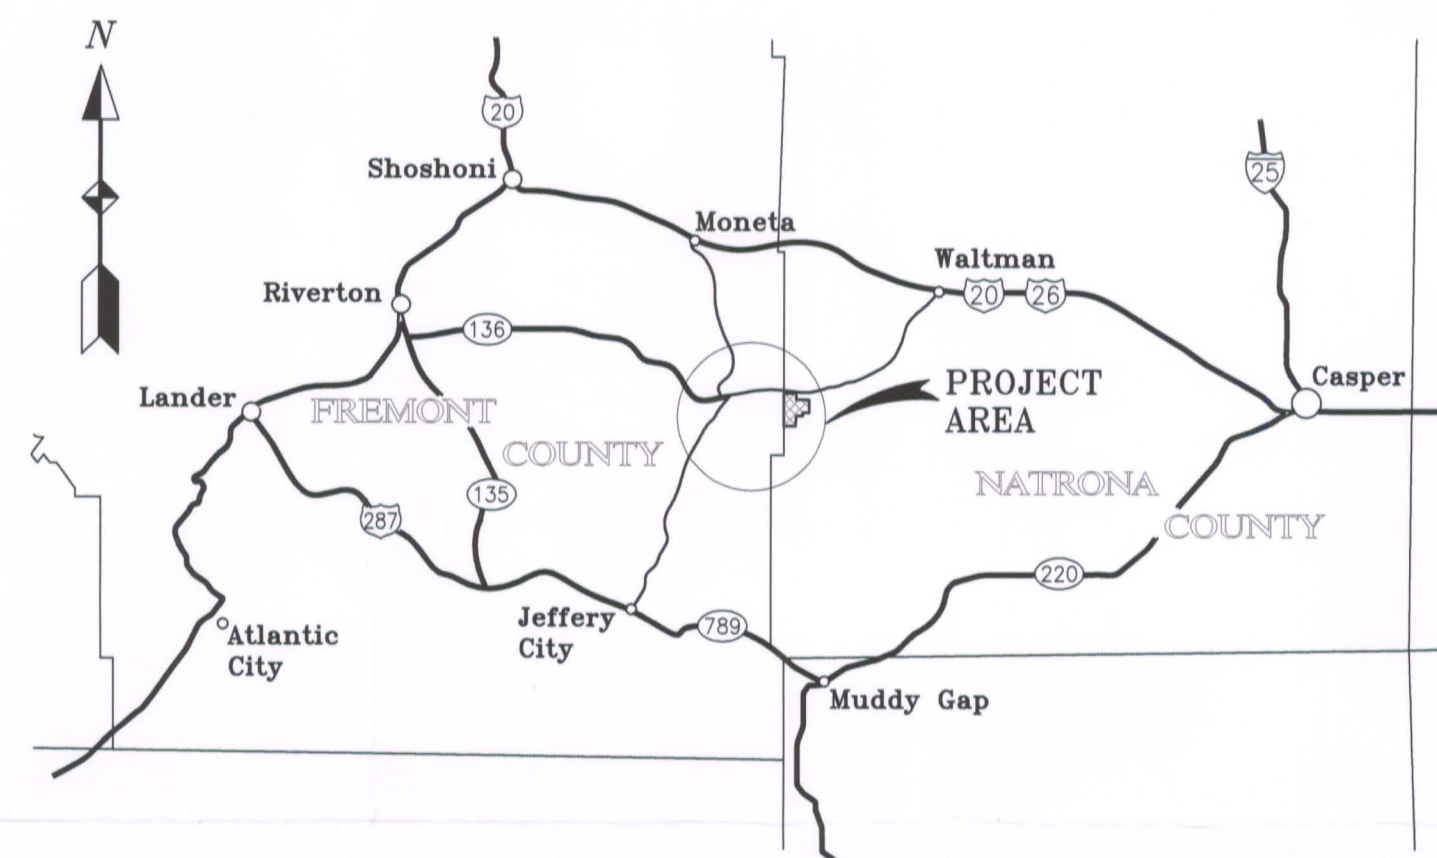

VICINITY MAP
NOT TO SCALE

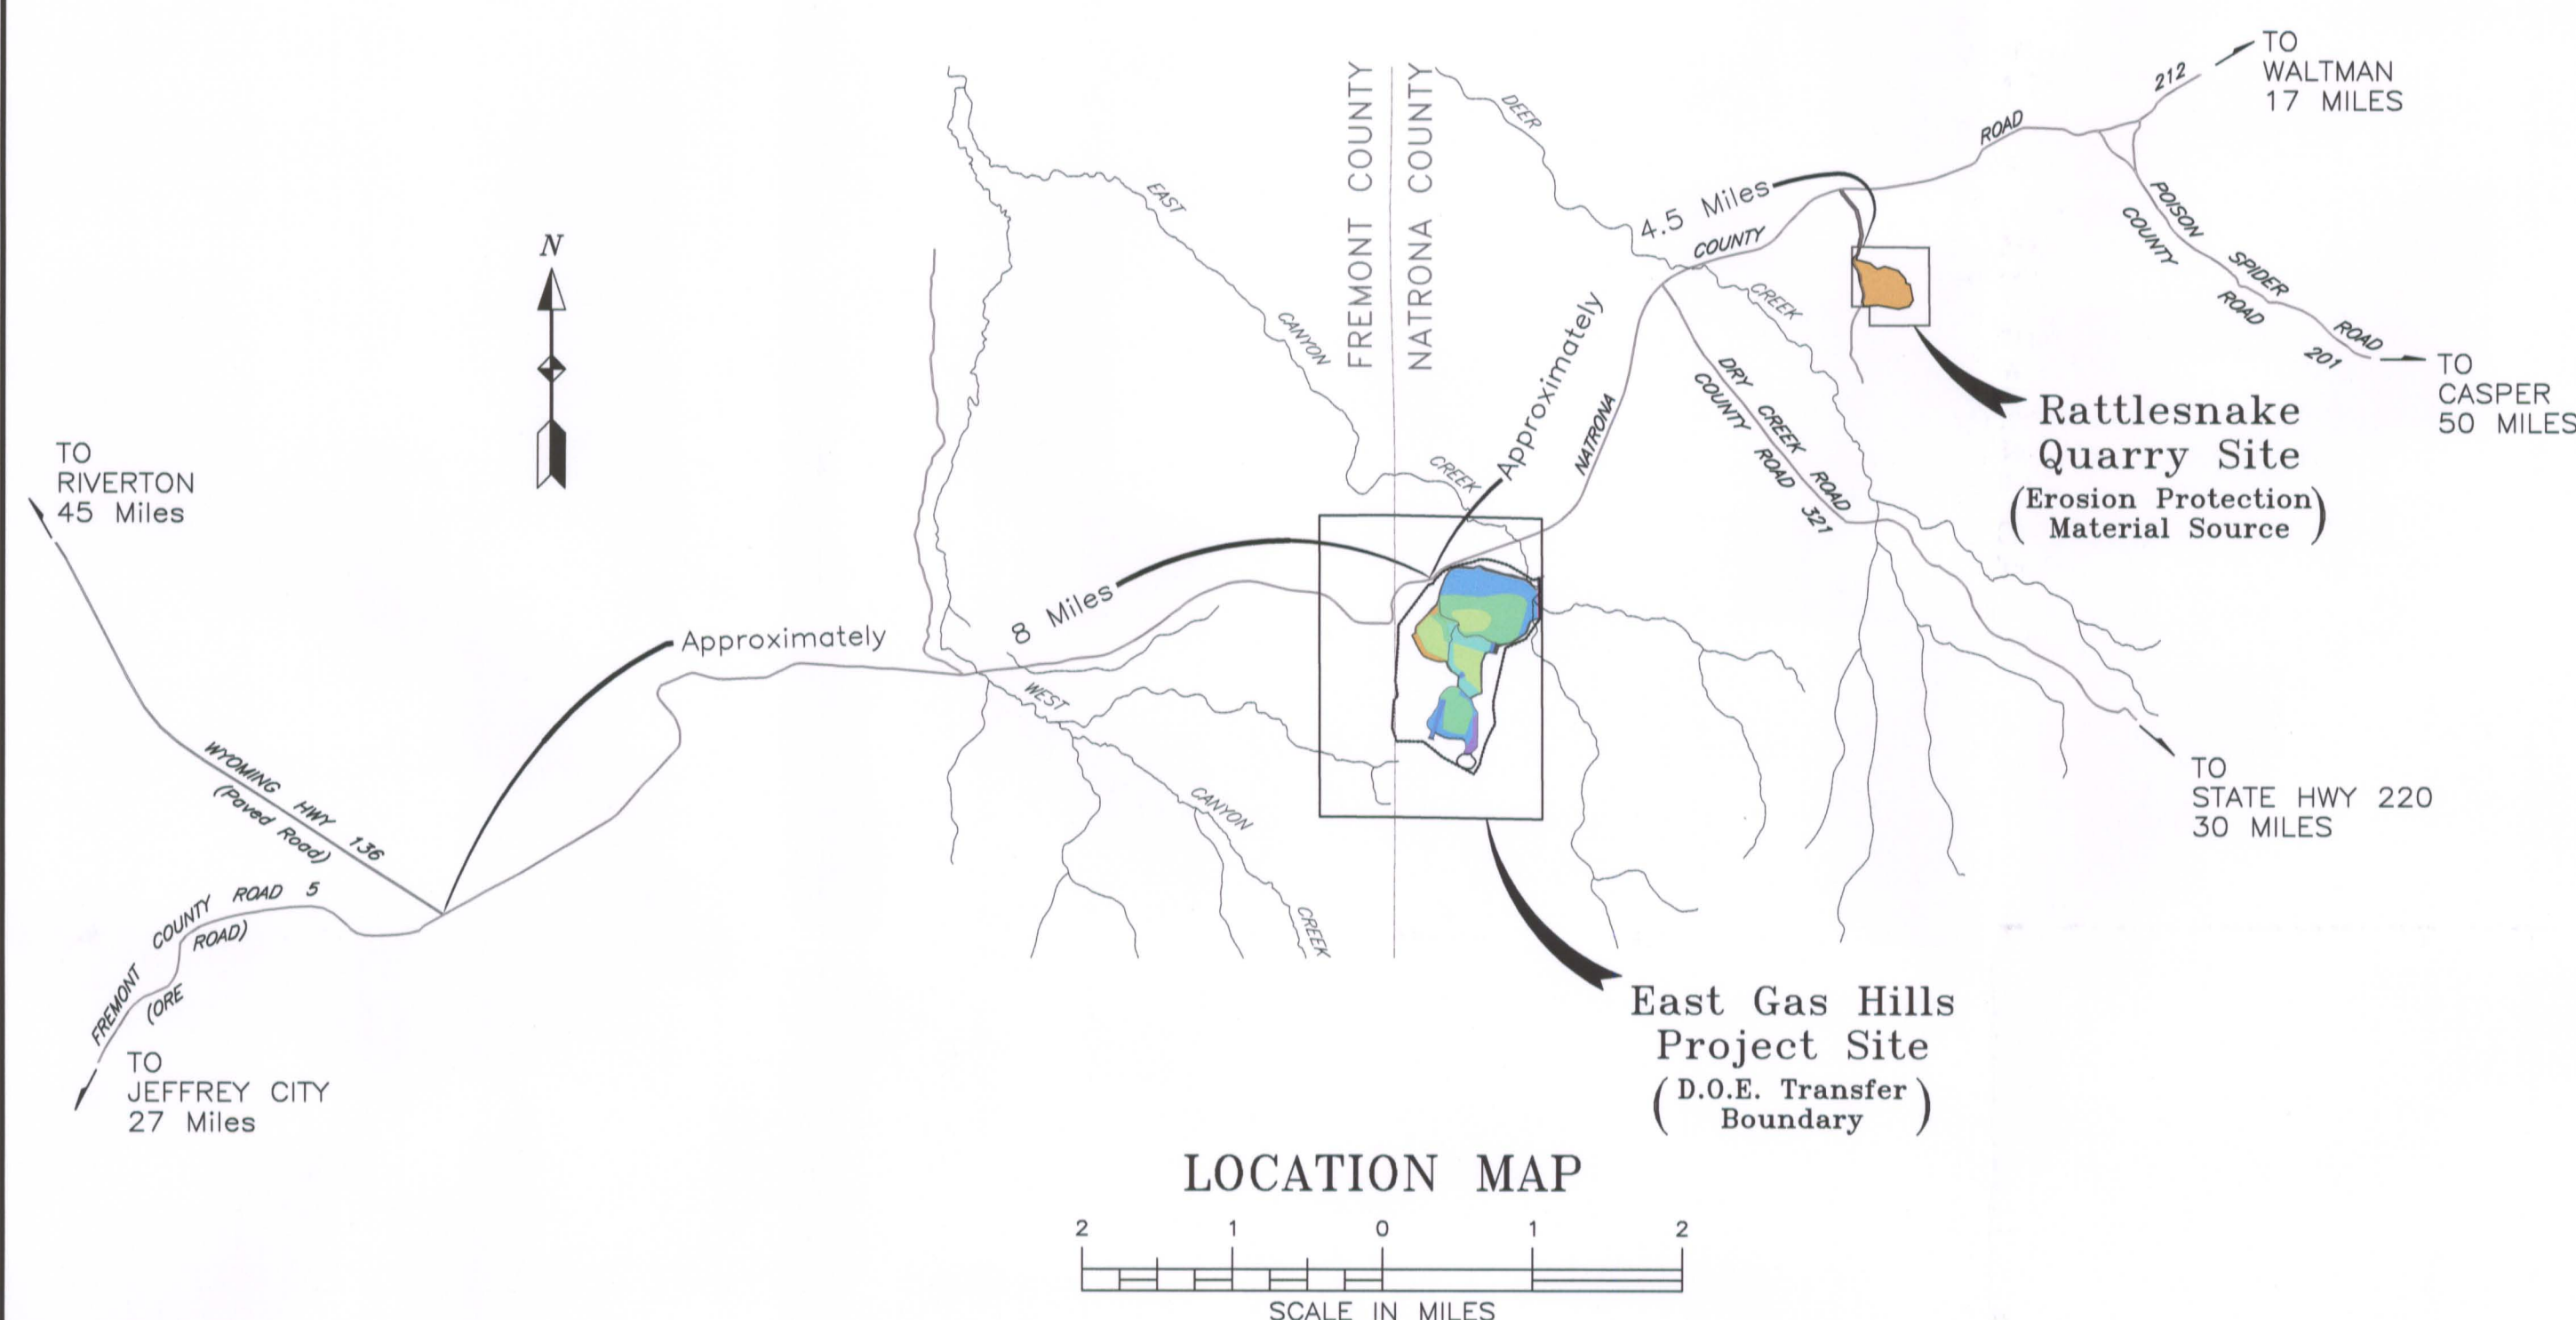

PREPARED BY:

UMETCO MINERALS CORPORATION

2754 COMPASS DRIVE, SUITE 280

P.O. BOX 1029

GRAND JUNCTION, COLORADO, CO 81502


(970) 245-3700

SHEET NO.	TITLE
1 OF 7	VICINITY AND LOCATION MAPS
2 OF 7	ABOVE-GRADE TAILINGS IMPOUNDMENT DESIGN ENHANCEMENT, EROSION AND RILL REPAIR PLAN
3 OF 7	ABOVE-GRADE TAILINGS IMPOUNDMENT DESIGN ENHANCEMENT, EROSION AND RILL REPAIR PLAN, SECTIONS AND DETAILS
4 OF 7	ABOVE-GRADE TAILINGS IMPOUNDMENT DESIGN ENHANCEMENT, IN-PLACE GRADATION AND DEPTH VERIFICATION CHECK LOCATIONS
5 OF 7	EROSION CONTROL APRON CHANNEL, PLAN AND DETAILS
6 OF 7	A-9 REPOSITORY DESIGN ENHANCEMENT, EROSION AND RILL REPAIR PLAN
7 OF 7	A-9 REPOSITORY DESIGN ENHANCEMENT, IN-PLACE GRADATION AND DEPTH VERIFICATION CHECK LOCATIONS

GENERAL NOTES:

- ALL CONSTRUCTION CONFORMED TO THE DRAWINGS AND SPECIFICATIONS. DRAWINGS AND SPECIFICATIONS WERE NOT CHANGED.
- THE CONTRACTOR WAS RESPONSIBLE FOR CONTROL OF POLLUTION, SURFACE WATER AND EROSION THROUGHOUT THE DURATION OF THE CONTRACT.
- THE CONTRACTOR WAS RESPONSIBLE FOR THE FOLLOWING:
A. ALL PERMITS AND/OR LICENSES REQUIRED FOR CONSTRUCTION
B. PROPER NOTIFICATION TO ALL NECESSARY AGENCIES
C. PRIOR TO CONSTRUCTION AND FOR REQUIRED INSPECTIONS.
D. THE EXACT LOCATION OF ANY UTILITY LINES AND COORDINATION OF ANY DISRUPTION IN SERVICES WITH AFFECTED PARTIES.
- THE OWNER'S QUALITY CONTROL OFFICER OBSERVED AND APPROVED OF ALL EARTHWORK, RIPRAP, AND CONSTRUCTION ACTIVITIES. CONTRACTOR DID COORDINATE AND ASSIST THE QUALITY CONTROL OFFICER WITH TESTING.
- THE OWNER'S REPRESENTATIVE WAS NOTIFIED OF ANY DISCREPANCIES AND/OR CONFLICTS PRIOR TO CONTINUING CONSTRUCTION. NONE WERE NOTED.
- ALL LOCATIONS AND ELEVATIONS WERE FIELD VERIFIED PRIOR TO CONSTRUCTION.

AS-BUILT

 Umetco Minerals Corporation 2754 COMPASS DRIVE, SUITE 280, GRAND JUNCTION, CO 81508				GAS HILLS, WYOMING	
				VICINITY AND LOCATION MAPS	
				DESIGN: T.E.G.	DRAWN: R.W.Q.
				CHECKED BY:	DATE: 12/2010
ENGINEERING APPROVAL:				HS & EA APPROVAL:	
NO. DATE REVISION - DESCRIPTION BY DWG:GH-LOC-MAPS-2011-AB				SHEET 1 OF 7	