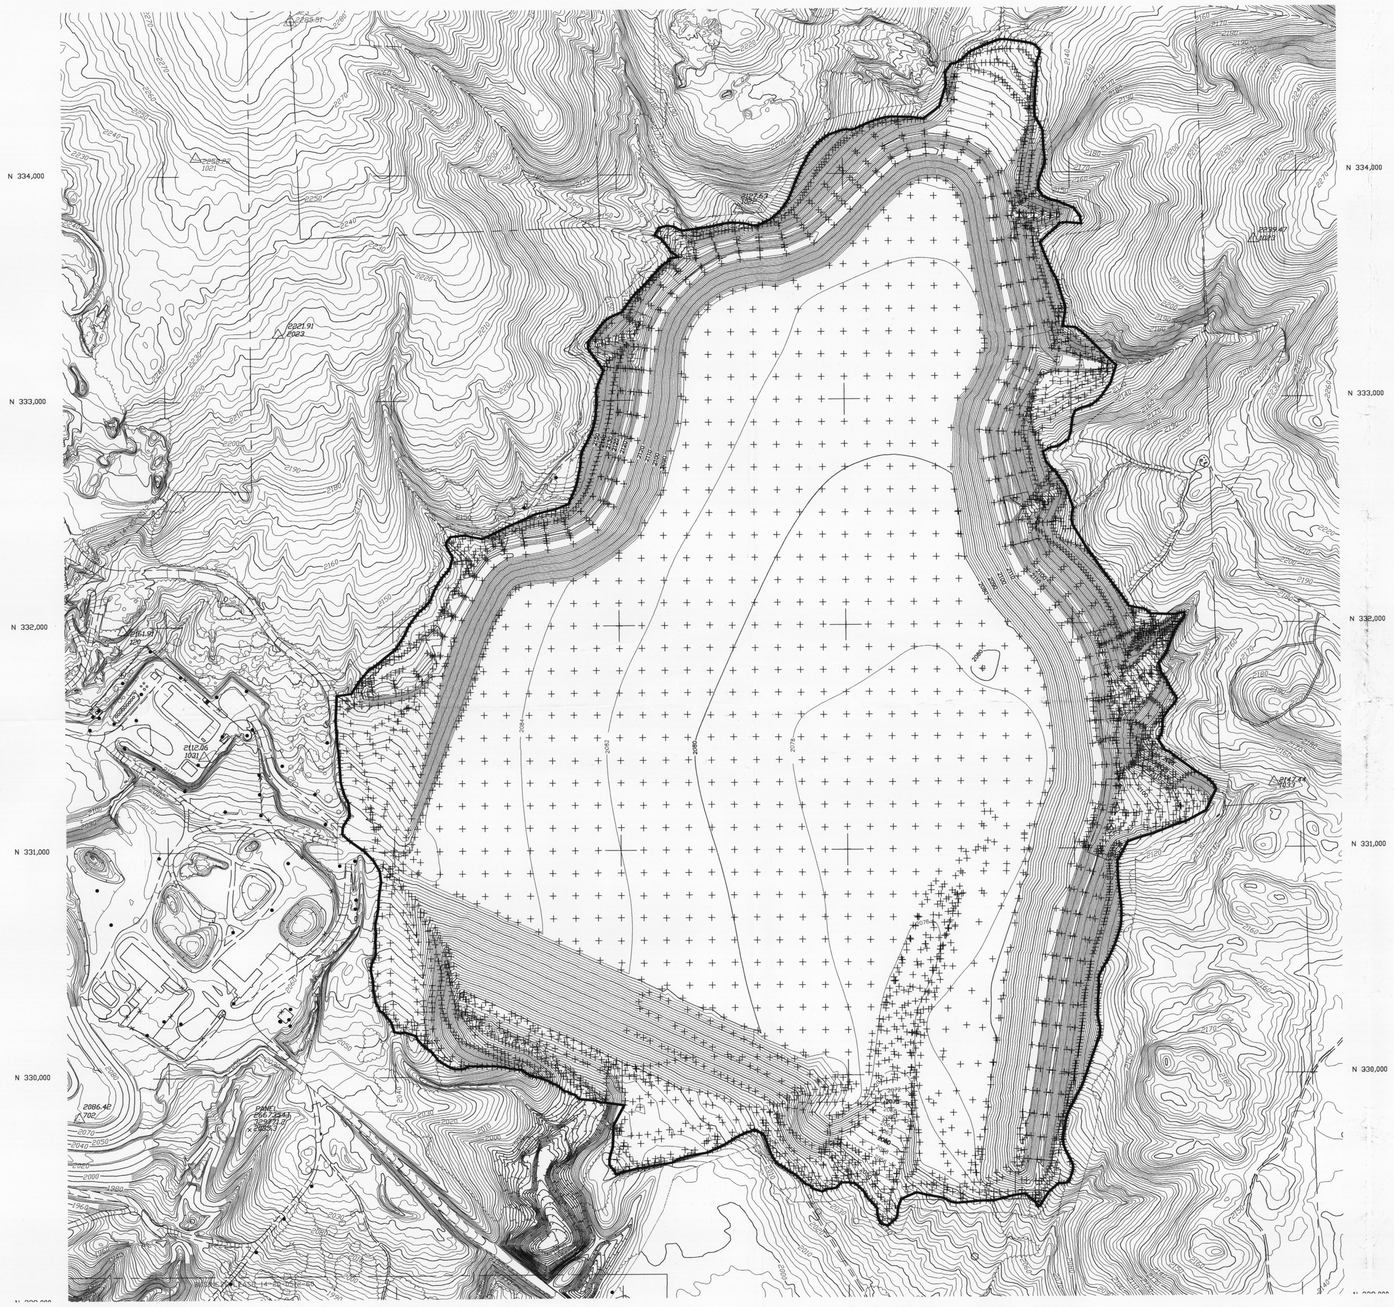

LEGEND

CONTOUR INTERVAL 2'

DATE OF AERIAL PHOTOGRAPHY: 5-16-93

AS-BUILT SURVEYED BY C.E. SPURLOCK & ASSOC., INC. 4-8-97

MAP WAS RECREATED BY SHEPHERD MILLER, INC. (10-20-99)

REVISIONS		
DATE	BY	
10/20/99	TGB(SMI)	RECREATED DRAWING OF AS-BUILT
		FINAL TOP OF TAILING COVER
11/1/99	TGB(SMI)	RECREATED ASCII FILE FROM
		SURVEY POINTS (ASBUILT-SMI.TXT)

ASCII FILE: ASBLT96.CSV (SPURLOCK FILE)
PROJECT FILE: 03-317\CLIENT\SPURLOCK-99
ACAD FILE: ASBUILT-SMI.DWG

PROJECT AREA:
SHERWOOD URANIUM MILLSITE

STATE WASHINGTON COUNTY STEVENS

SECTION 2,3 & 34,35 TWP. 27&28N RGE. 37E

TITLE:
RANDOM SAMPLE POINTS STAKED IN TAILING & MARGIN AREA

WESTERN NUCLEAR INC.

Design By	Scale	Date
KWB	1"= 300'	5/19/97
Drawn By KWB	Checked By	Sheet 1 of 1

DWG. NO.

D-1

Plotted: 5/20/99
Drawn: TGB
Date: 09:27:54a

F:\DATA\CLIENT\SPURLOCK-99\ASBLT-SMI.dwg