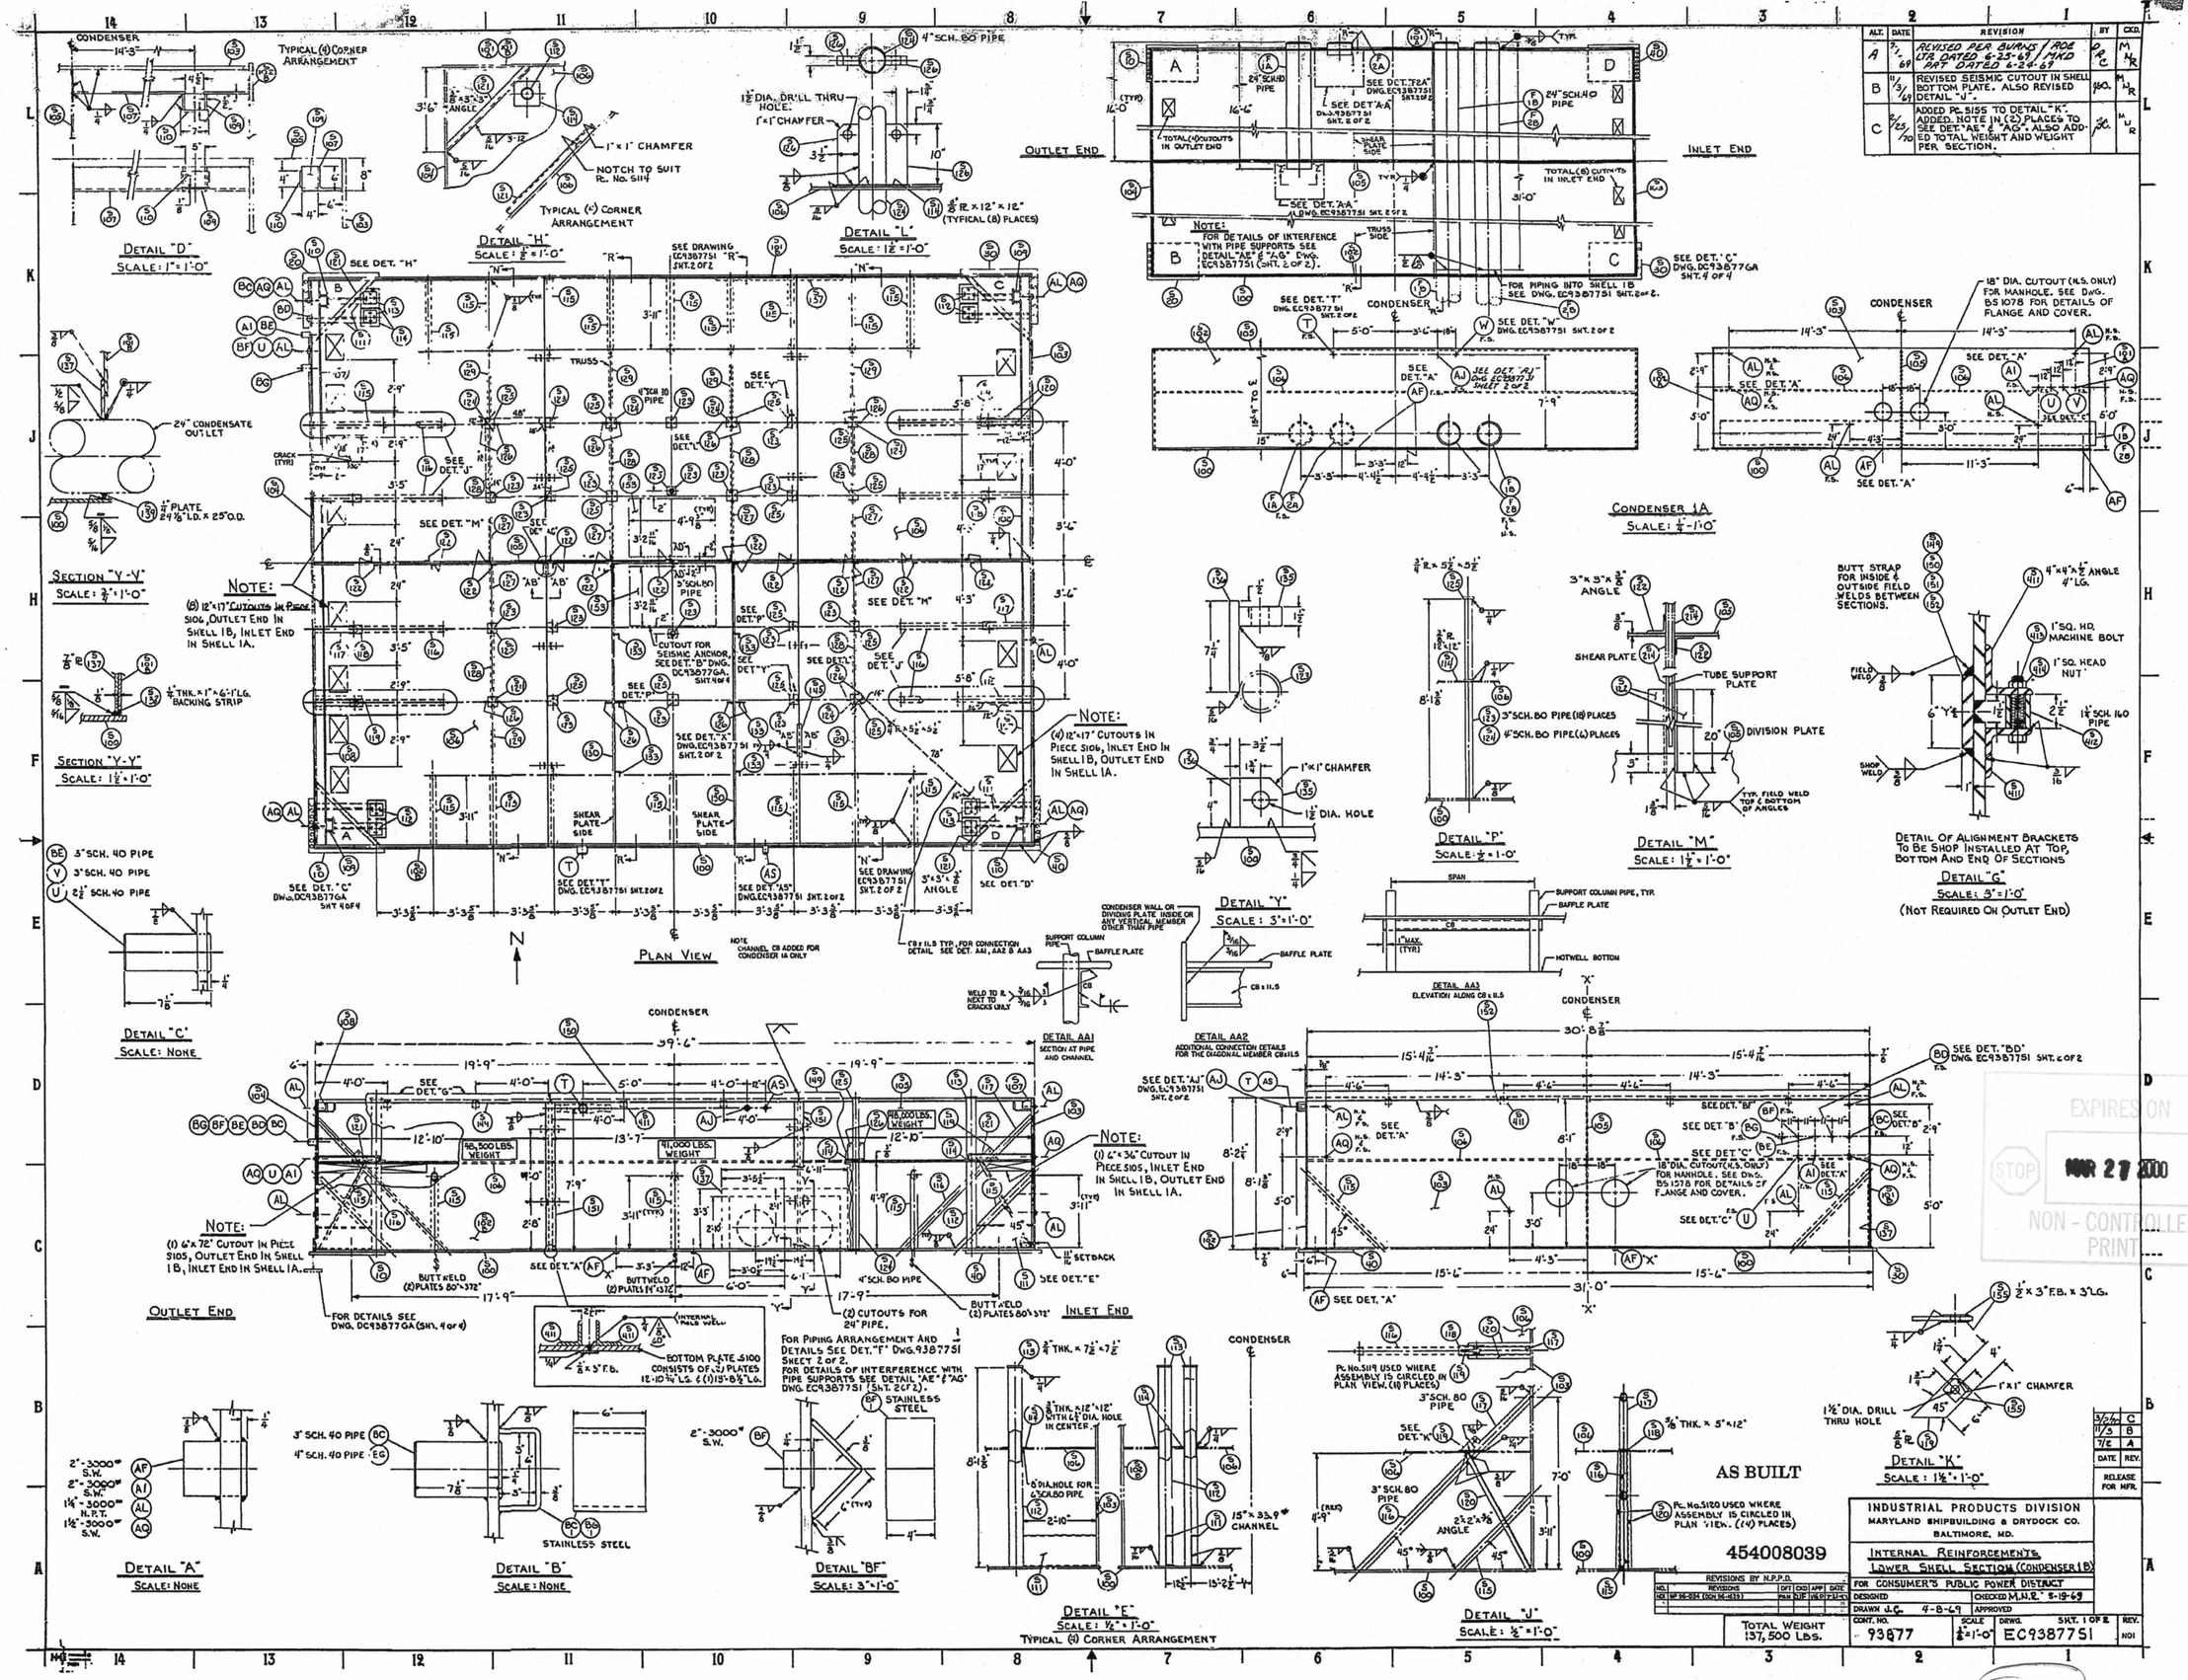

ALT.	DATE	REVISION	BY	CKD.
A	7/1/69	REVISED PER BURNS / ROE LTR DATED 6-25-69 / MKD PRT DATED 6-24-69	DC	MNR
B	11/3/69	REVISED SEISMIC CUTOUT IN SHELL BOTTOM PLATE. ALSO REVISED DETAIL "J".	JSC.	MNR
C	2/25/70	ADDED PC. S155 TO DETAIL "K". ADDED NOTE IN (2) PLACES TO SEE DET. "AE" & "AG". ALSO ADDED TOTAL WEIGHT AND WEIGHT PER SECTION.	JC.	MNR

AS BUILT

454008039

REVISIONS BY N.P.P.D.					
NO.	REVISIONS	DFT	CKD	APP	DATE
NO1	NP 94-034 (DCN 94-1639)	PAM	DJF	11/6/70	7-21-70

TOTAL WEIGHT 137,500 LBS.

INDUSTRIAL PRODUCTS DIVISION
MARYLAND SHIPBUILDING & DRYDOCK CO.
BALTIMORE, MD.

INTERNAL REINFORCEMENTS, LOWER SHELL SECTION (CONDENSER 1B)

FOR CONSUMER'S PUBLIC POWER DISTRICT

DESIGNED		CHECKED M.N.R. 5-19-69	
DRAWN J.C. 4-8-69		APPROVED	
CONT. NO. 93877	SCALE 1/4" = 1'-0"	DRWG. EC9387751	SHT. 1 OF 2 REV. NO1

DATE	REV.
3/26/70	C
11/3	B
7/2	A

RELEASE FOR MFR.

EXPIRES ON
STOP MAR 27 2000 STOP
NON - CONTROLLED PRINT

D-4