FOR INFORMATION ONLY

P10- 1-WLD-D20218

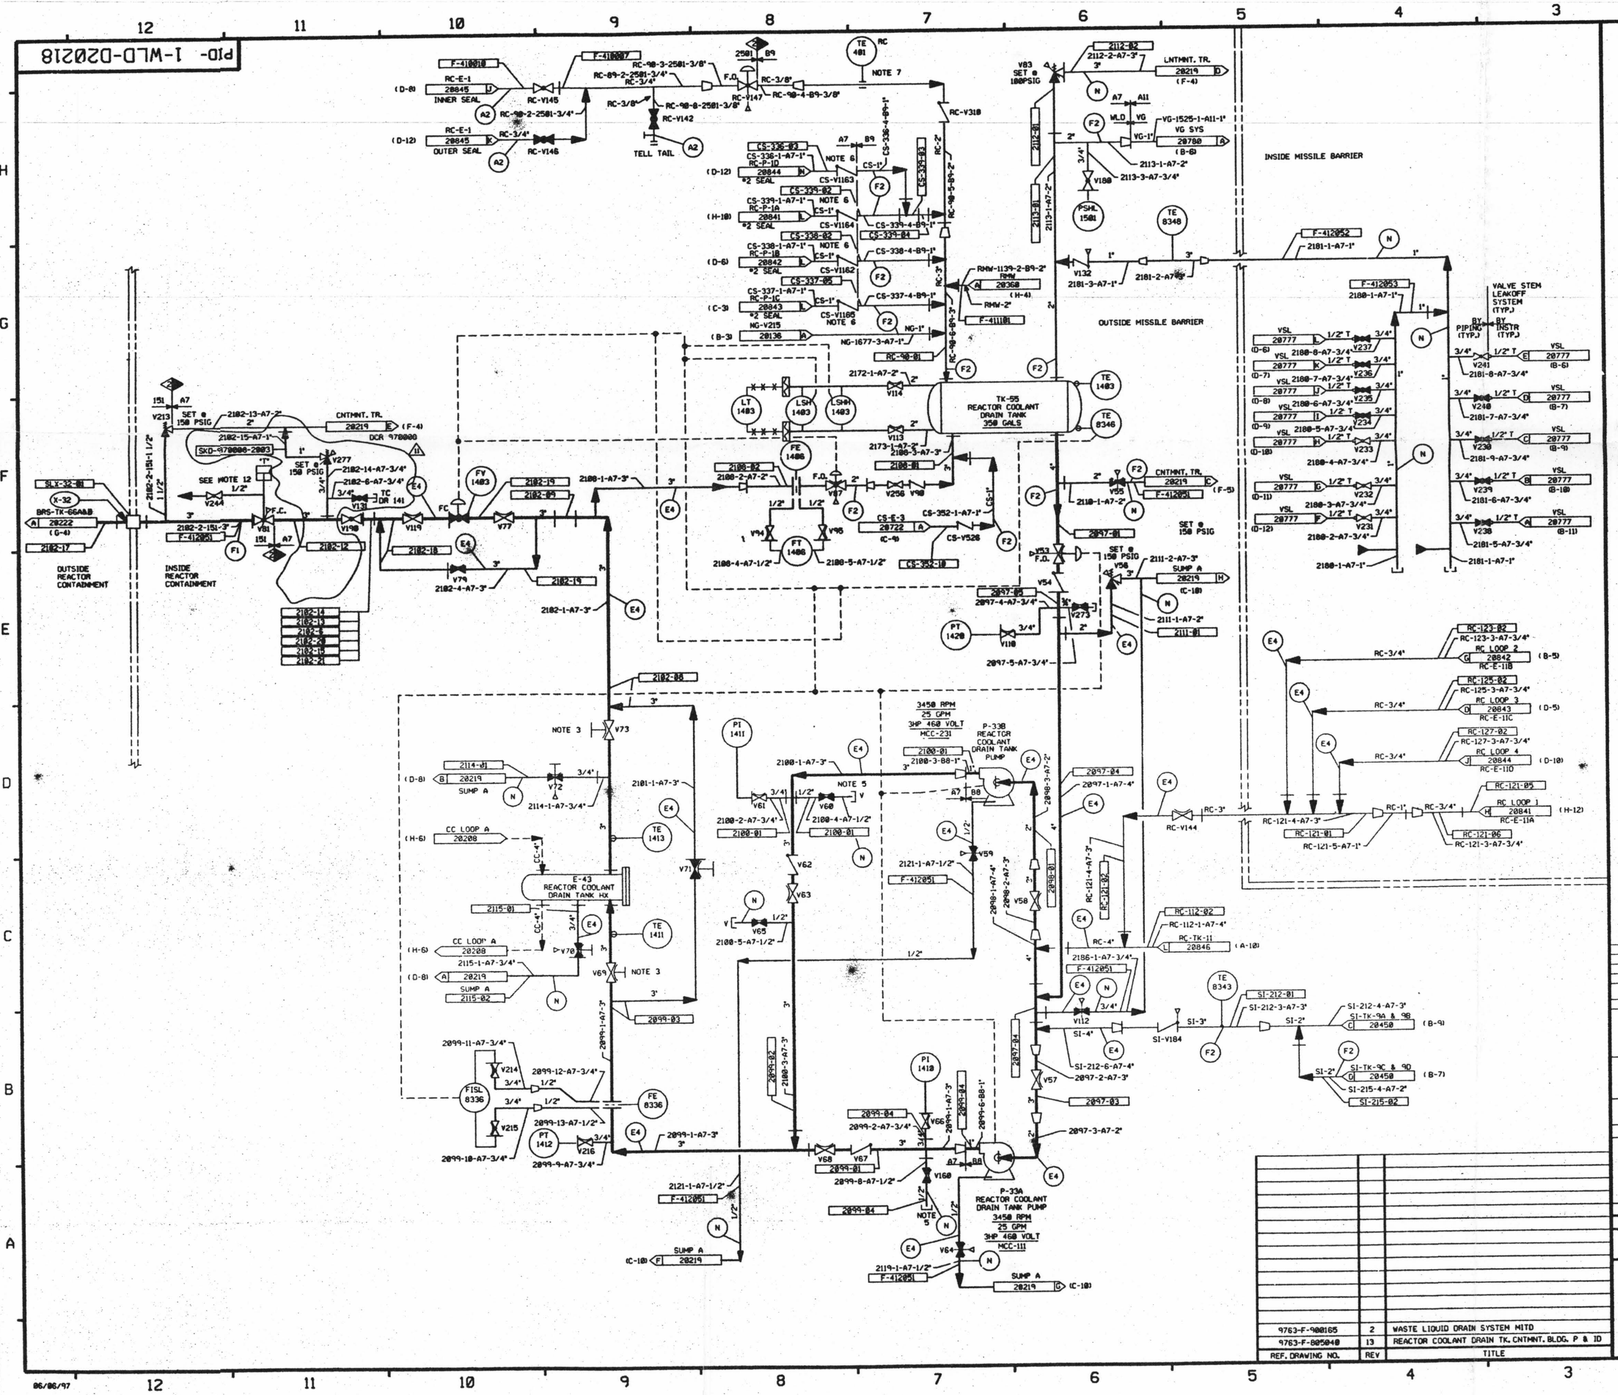

FOR PAID REFERENCE DRAWINGS, SYMBOLS AND ABBREVIATIONS REFER TO DRAWINGS P&ID - LEGEND 1 AND P&ID - LEGEND 2

LEGEND

		DESIGN PRESSURE	TEST PRESSURE	MIN. TEST TEMP F	TEST MEDIUM
	TEST BOUNDARY				
A2	INTEGRITY TEST	2485 PSIG	3186/3292 PSIG	35	WATER
E4	INTEGRITY TEST (IS)	150 PSIG	225/245 PSIG	35	WATER
F1	INTEGRITY TEST	150 PSIG	187.5/199 PSIG	35	WATER
F2	INTEGRITY TEST (IS)	100 PSIG	150/170 PSIG	35	WATER
N	NO TEST REQUIRED				

NOTE: A. REACTOR CONTAINMENT PENETRATION SEAL PLATE ATTACHMENT WELDS ON X-32 SATISFACTORILY TESTED PER WLD-112.
B. VENTS AND DRAINS (ASME CL.2 & 3, NNS) SHALL BE TESTED TO THE LAST ISOLATION VALVE.

NOTES:
1. WORK THIS DRAWING WITH DRAWINGS 20216, & 20219 THRU 20229.
2. ALL LINES, EQUIPMENT, COMPONENTS, AND INSTRUMENTS HAVE SYSTEM PREFIX WLD UNLESS NOTED OTHERWISE.
3. VALVES V69 THRU V73 ARE REACH ROD OPERATED.
4. ALL LINES, EQUIPMENT, COMPONENTS, AND INSTRUMENTS ARE SAFETY CLASS NNS, UNLESS NOTED OTHERWISE.
5. VENTS REFERRING TO THIS NOTE ARE TO BE TERMINATED ABOVE THE ADJACENT CHECK VALVE.
6. LOCATE CHECK VALVES AT LEVEL OF RCDT.
7. "TE" SURFACE MOUNTED AS NOTED.
8. CLEANLINESS CLASS 'C & D'.
9. DELETED
10. △ INDICATES REVISION LEVEL
11. SYSTEM DESCRIPTION IS SD-25
12. REFER TO DRAWING YSL-20774 FOR VALVE LEAKOFFS.

PORTIONS OF THIS DRAWING ARE
NUCLEAR SAFETY RELATED

REV	DATE	DSGN	DRWN	CHKD	COE	SES	DESCRIPTION
11	6/13/97	DWS	—	—	FAC	DWG	INCORP DCR 970000 DCN*00
10	1/31/97	DWS	—	BCS	MPW	AM	INCORP DCR 970005 CA*0
9	11/27/95	MPW	—	BCS	RRC	DMO	INCORP DCR 95-23 CA-6
8	11/13/95	BCS	—	MPW	HWH	RJF	PARTIAL INCORP. DCR 95-23 CA-6
7	6-3-94	MPW	—	DWS	MPW	JLD	INCORP DCR 91-13 CA0 & DCR 93-23 CA 1
6	4-3-92	DWS	—	BCL	DRB	ES	INCORP DCR'S 90-3 CA0
5	9-24-91	MRB	JM	RMC	GPM	JEV	INCORP. MMOD 91-610 CA0 REVISED: NOTE 4 PER ENGINEERING DESIGN STANDARD 37100 SEC 3.8 DELETED NOTE 4 "SJ" SYMBOL DESIGNATION & TEST BOUNDARIES PER LEGEND NOTE B.
4	4/28/88	MRW	RMC	BCL	DWS	RRC	REVISED: DRAIN LINES TO SUMP, CONTINUATION LETTER, REF. COORD AND "F" LOCID PIPING SHOWN IN PHANTOM AND LEGEND NOTE PER 9763-F-908888 AND ANSI B31.1 1977-SEC. 137.1.2E.
3	7/2/87	GPM	JM	PAL	BCL	VWS	REVISED PIPING TO REFLECT AS INSTALLED CONFIG. ADDED: NOTE 12, REFERENCE DRAWING.
2	2/27/87	WDS	TAK	PAL	BCL	VWS	INCORP. WR 87-W00155
1	1/19/87	MAP	TAK	PAL	BCL	VWS	ADDED YSL CONTINUATION FLAGS & REF COORD. AND WR TO 1IL, RELOCATED PIPING FROM V13 YSL REMOVED CAPILLARY FROM PT 1418 (& PI 141) AND RELOCATED TE-1418 PER AS-BUILT CONDITION, PLUGGED DRAIN SHOWN PER WELF ISOMETRIC, ADDED REF COORD TO REF FLANGE NO. & ISO NO., UPDATED REF DWG BLOCK & ADDED NOTES 10 & 11, LINE NO'S & ISO NOS.
0	6/26/86	GD	WEC (ANS)	BCL	JMS	RRC	ISSUED FOR OPERATIONS

REF. DRAWING NO.	REV	TITLE
9763-F-908165	2	WASTE LIQUID DRAIN SYSTEM MITD
9763-F-805848	13	REACTOR COOLANT DRAIN TK. CNTMNT. BLDG. P & ID

North Atlantic Energy Service Corporation

SEABROOK STATION

WASTE PROCESSING LIQUID DRAINS
REACTOR COOLANT SYSTEM

PID- 1-WLD-D20218

D-76