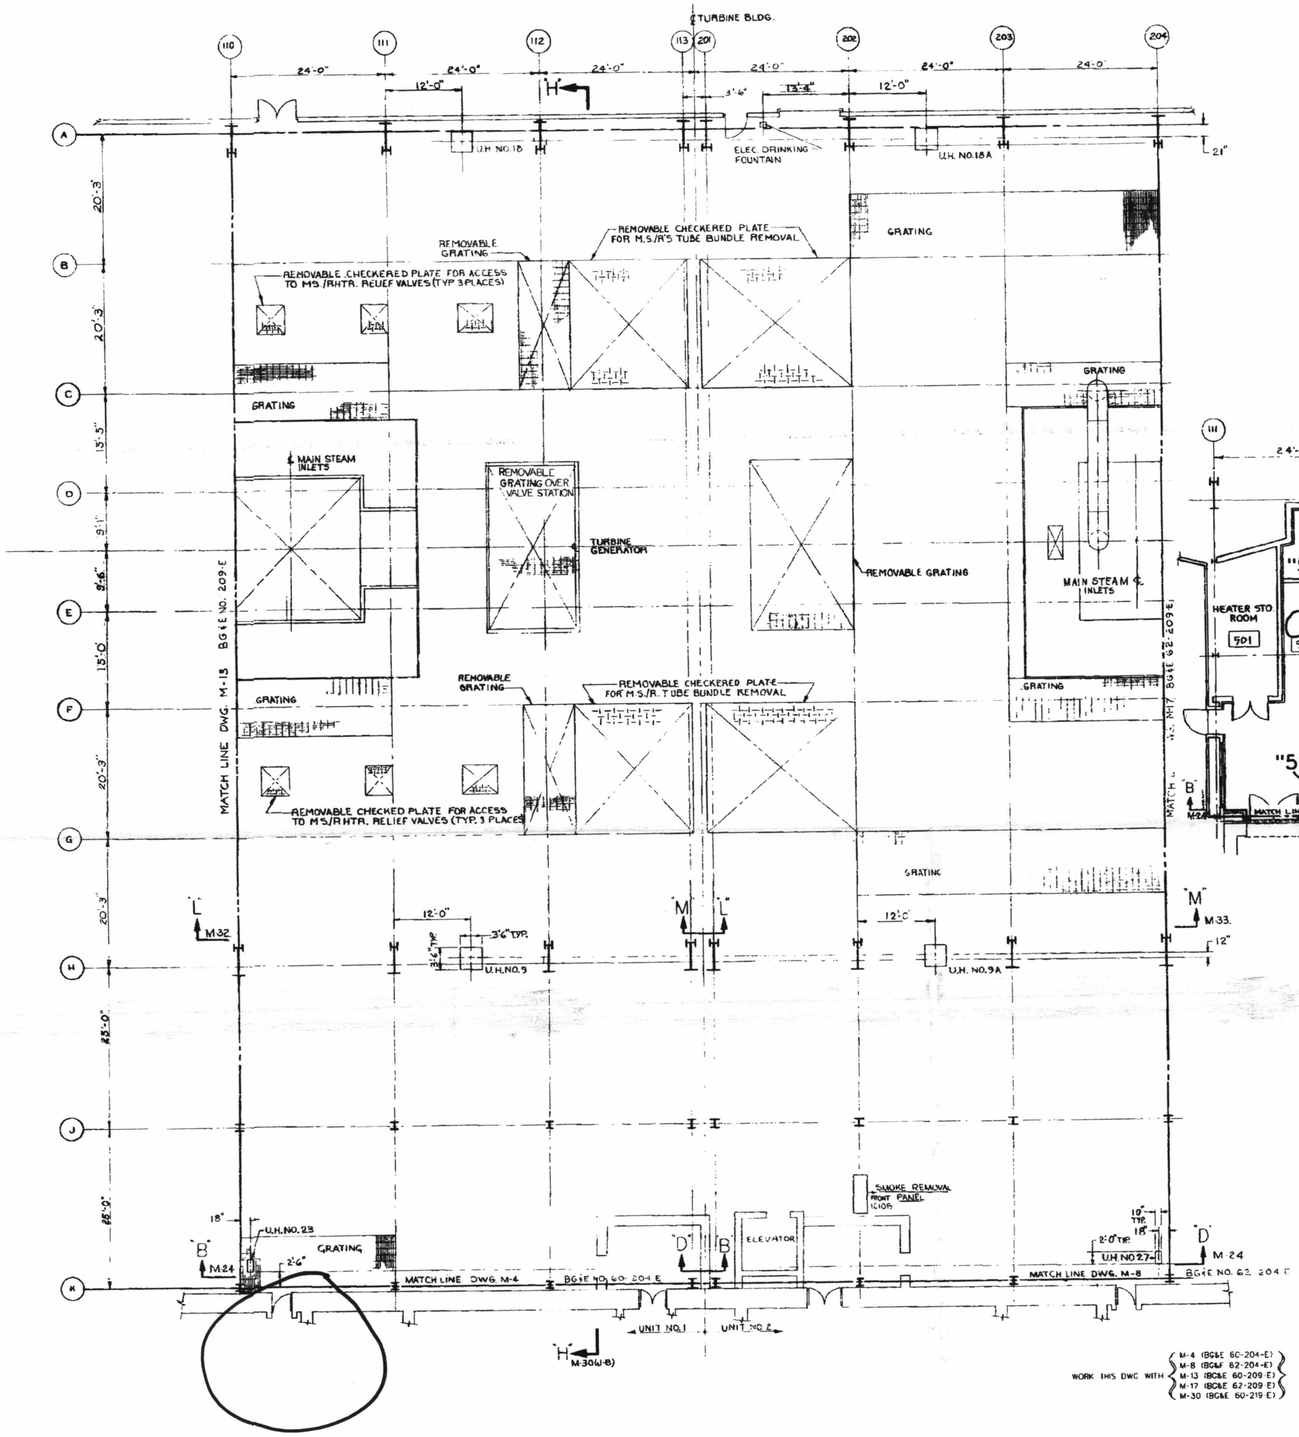

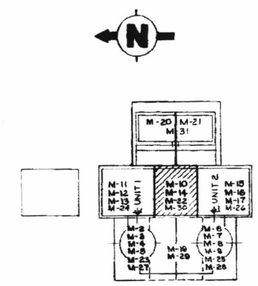

KEY PLAN

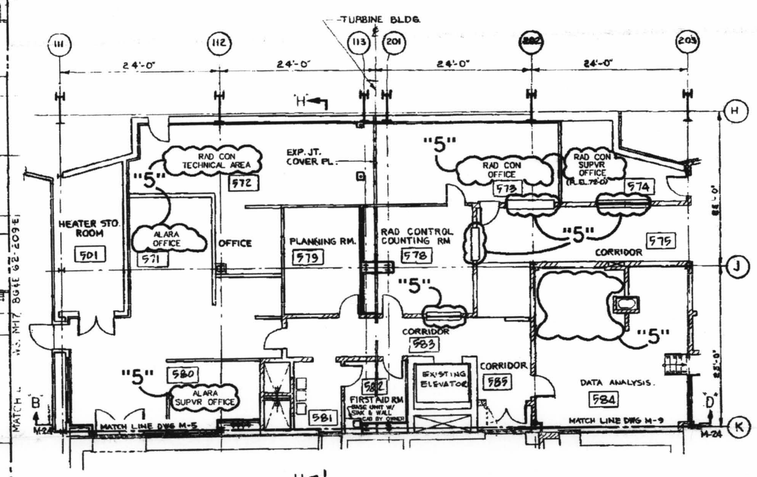

PARTIAL FLOOR PLAN-ACCESS CONTROL AREA
EL 69'-0"

"5"

THIS DRAWING WAS SCANNED FROM BGE DWG. NO. 60214, REV. 4, DATED 11/28/90.

REV	DATE	DESCRIPTION	DWN	DSGN	DE	IR	APPROVED
5	3/26/97	AS BUILT INFO. ONLY ESP ES199701335-000	DTC	—	—	—	

DRAWN DEBBIE C.
DESIGNED
CIVIL ENGR.
ELECT. ENGR.
I & C ENGR.
MECH. ENGR.
J.R.
APPROVED
DATE

EQUIPMENT LOCATION
TURBINE BUILDING
UNIT NO. 182
FLOOR PLAN
EL. 45'-0" & 69'-0"

BALTIMORE GAS AND ELECTRIC COMPANY
NUCLEAR ENGINEERING DEPARTMENT

CALVERT CLIFFS UNIT 182
ELECTRIC PRODUCTION PLANT

SIZE E | CAT. 3

SCALE: NONE | VENDOR DWG. NO. M-22 | REV.

INTER NO. 49243.DGN | DWG. NO. 60214 | 5

D3