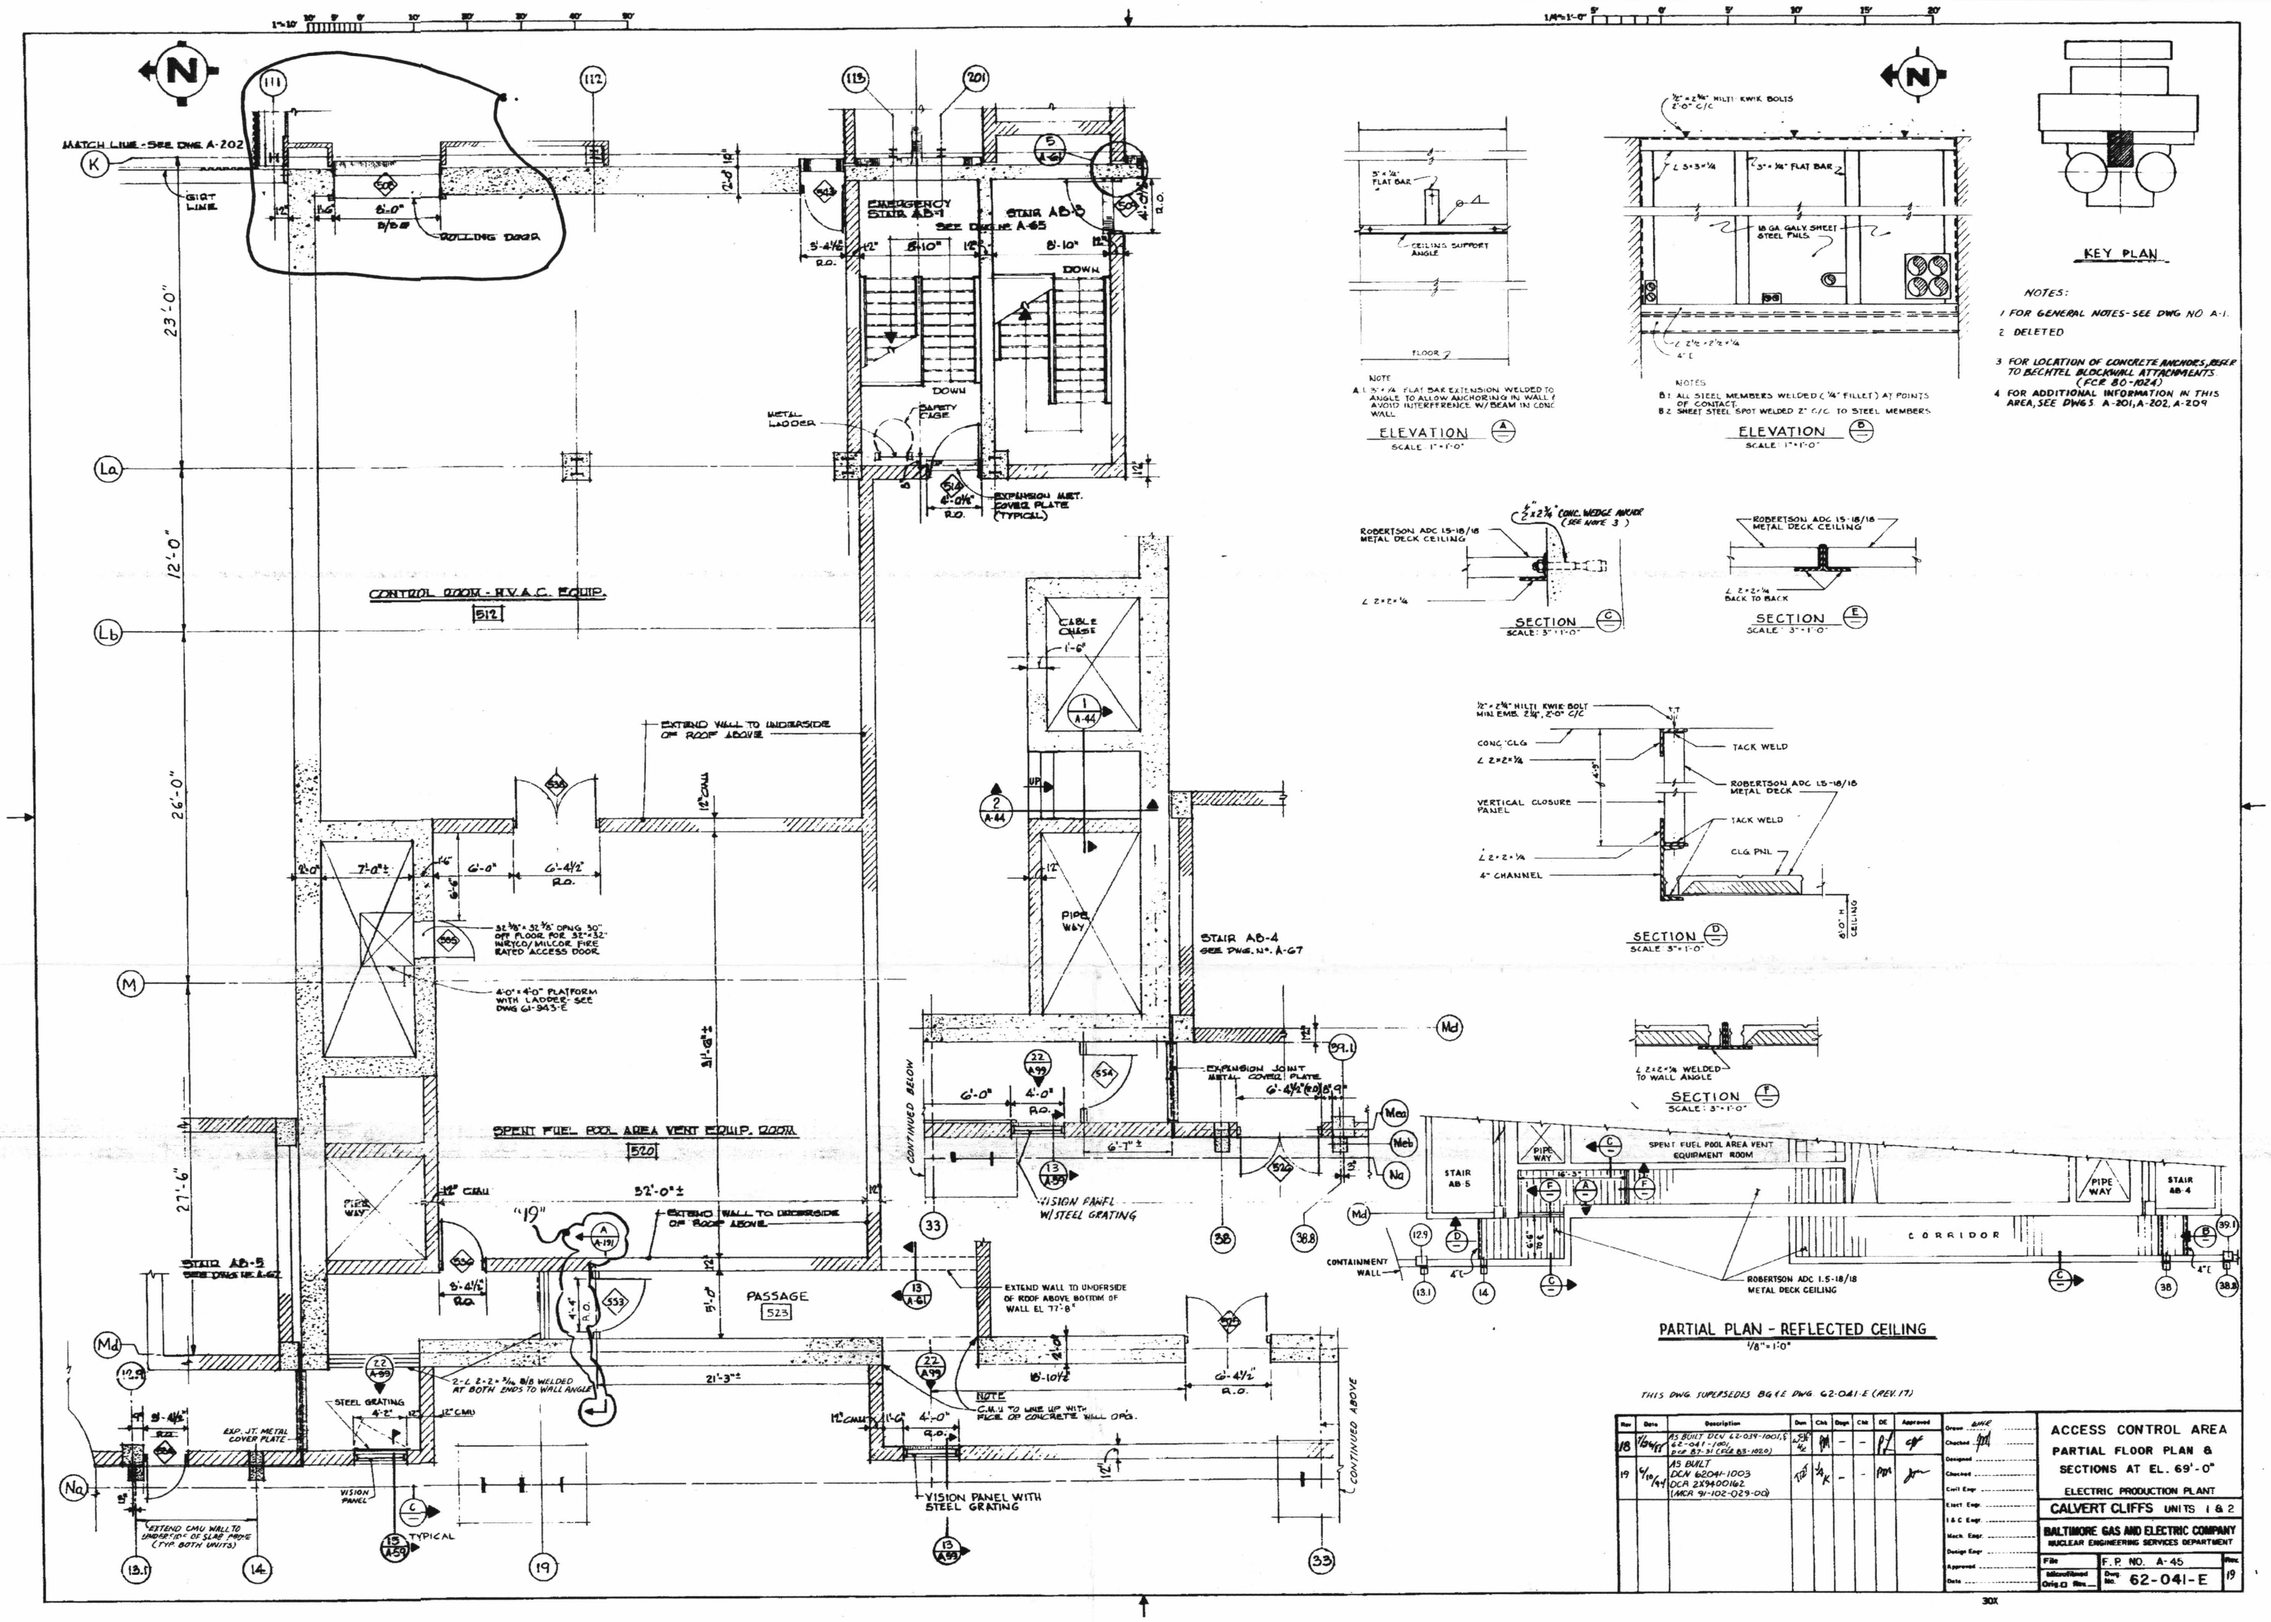

ELEVATION (A)
SCALE: 1"=1'-0"

ELEVATION (B)
SCALE: 1"=1'-0"

KEY PLAN

NOTES:

1 FOR GENERAL NOTES - SEE DWG NO. A-1.

2 DELETED

3 FOR LOCATION OF CONCRETE ANCHORS, REFER TO BECHTEL BLOCKWALL ATTACHMENTS (FCE 80-1024)

4 FOR ADDITIONAL INFORMATION IN THIS AREA, SEE DWGS. A-201, A-202, A-209

SECTION (C)
SCALE: 3"=1'-0"

SECTION (E)
SCALE: 3"=1'-0"

SECTION (D)
SCALE: 3"=1'-0"

SECTION (F)
SCALE: 3"=1'-0"

PARTIAL PLAN - REFLECTED CEILING
1/8"=1'-0"

THIS DWG SUPERSEDES BG&E DWG G2-041-E (REV 17)

No	Date	Description	Des	Chk	Engr	Chk	DE	Approved
18	7/24/91	AS BUILT DCN 62-039-1001, 62-041-1001, PER 87-31 (FCE 85-1020)	SBE 5/2	PM	-	-	PL	GF
19	6/10/94	AS BUILT DCN 62041-1003 DCA 2X9400162 (MCR 91-102-029-00)	TSF	SK	-	-	PM	JM

Drawn MWE
Checked PM
Designed
Checked
Civil Engr.
Elect. Engr.
I & C Engr.
Mech. Engr.
Design Engr.
Approved
Date

ACCESS CONTROL AREA
PARTIAL FLOOR PLAN & SECTIONS AT EL. 69'-0"
ELECTRIC PRODUCTION PLANT
CALVERT CLIFFS UNITS 1 & 2
BALTIMORE GAS AND ELECTRIC COMPANY
NUCLEAR ENGINEERING SERVICES DEPARTMENT

File | F. P. NO. A-45 | Sheet 19
Subordinated | Dwg. No. 62-041-E
Orig. □ Sheet

30X

62:041

D4