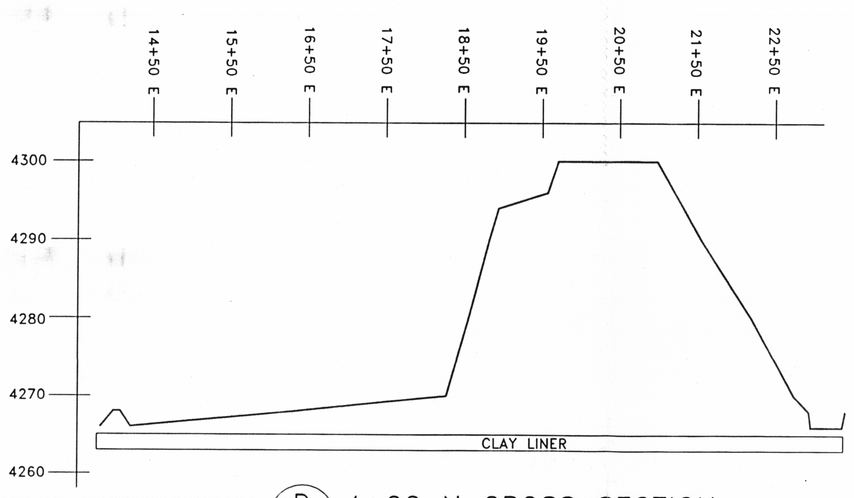

D 0003-02 4+00 N CROSS SECTION
HORIZONTAL SCALE: 1" = 100'
VERTICAL SCALE: 1" = 10'

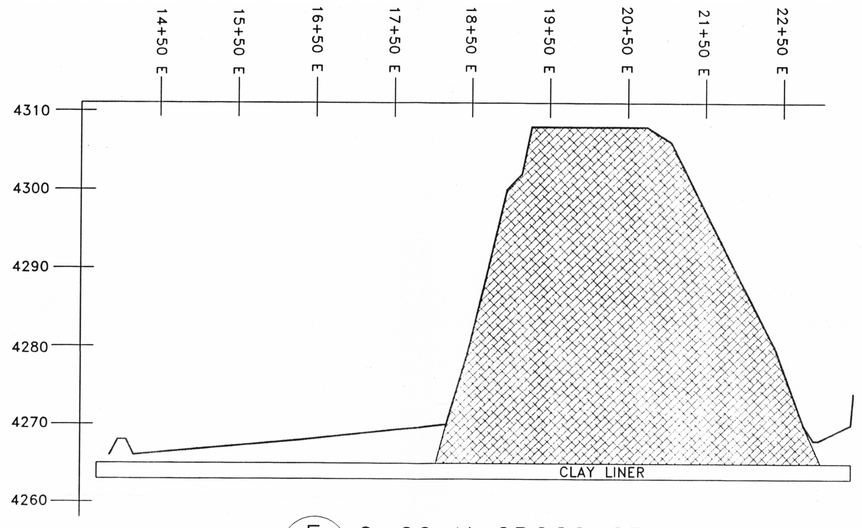

F 0003-02 6+00 N CROSS SECTION
HORIZONTAL SCALE: 1" = 100'
VERTICAL SCALE: 1" = 10'

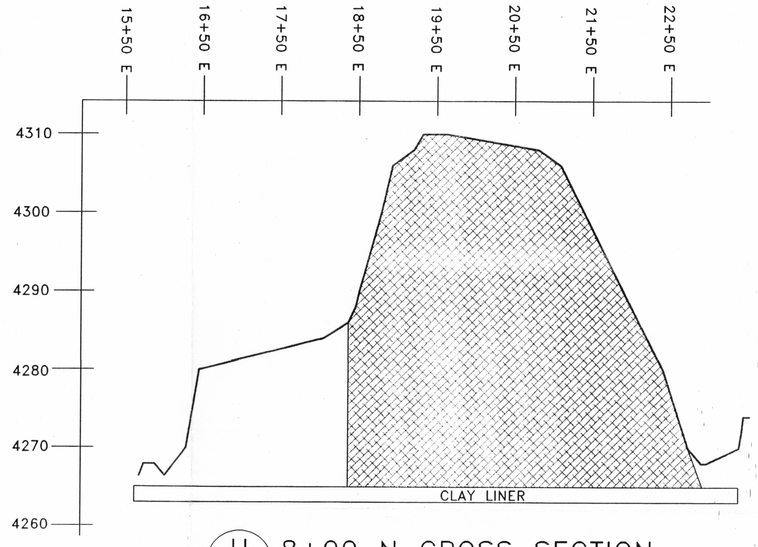

H 0003-02 8+00 N CROSS SECTION
HORIZONTAL SCALE: 1" = 100'
VERTICAL SCALE: 1" = 10'

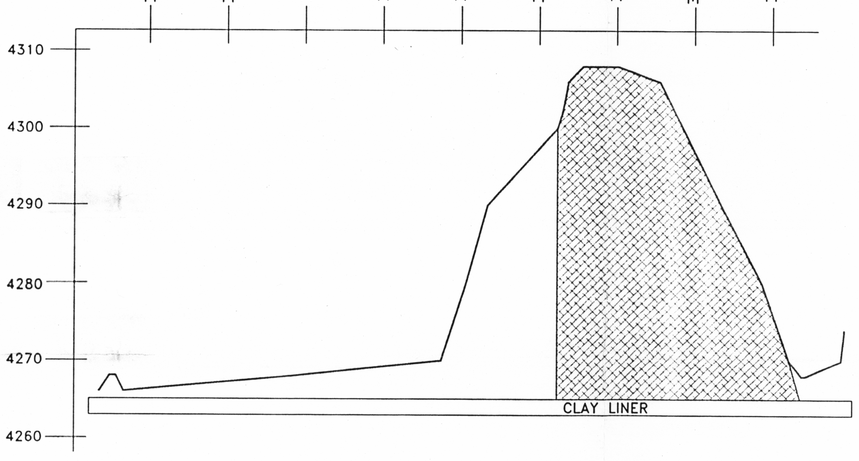

E 0003-02 5+00 N CROSS SECTION
HORIZONTAL SCALE: 1" = 100'
VERTICAL SCALE: 1" = 10'

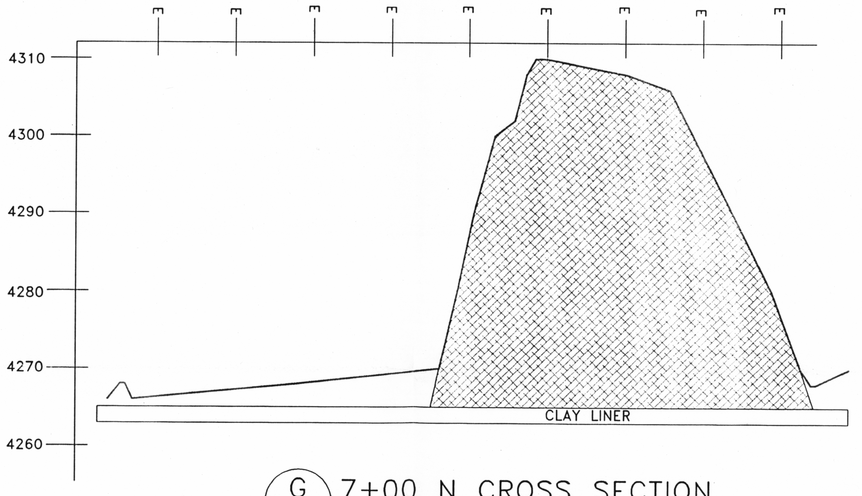

G 0003-02 7+00 N CROSS SECTION
HORIZONTAL SCALE: 1" = 100'
VERTICAL SCALE: 1" = 10'

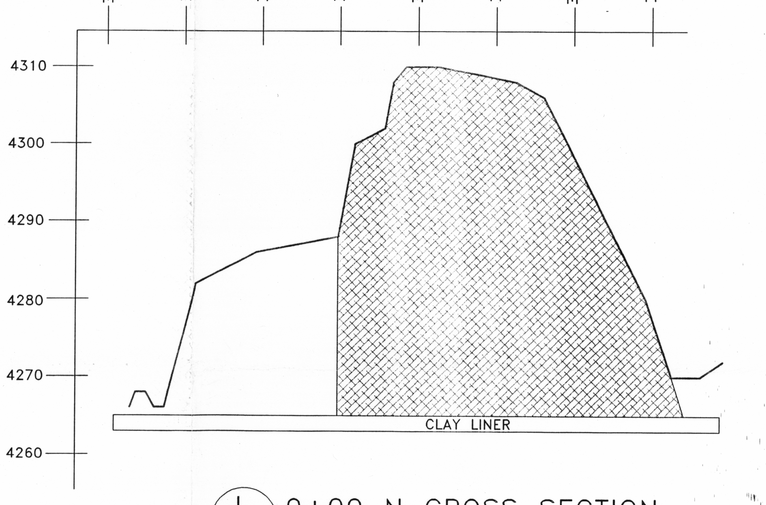

I 0003-02 9+00 N CROSS SECTION
HORIZONTAL SCALE: 1" = 100'
VERTICAL SCALE: 1" = 10'

KEY:

AREAS OF THE EMBANKMENT IN WHICH FINAL COVER HAS BEEN CONSTRUCTED. WASTE IN THESE AREAS IS NOT IN THE OPEN CELL FOOTPRINT OF THE EMBANKMENT

LICENSED PROFESSIONAL ENGINEER
DAVID COMSTOCK, JR.
No. 363849
STATE OF UTAH

DATE	BY	DESCRIPTION OF CHANGE	DATE	BY	DESCRIPTION OF CHANGE

ENVIROCARE OF UTAH, INC.
"THE SAFE ALTERNATIVE"

MADE BY J WEST	11e(2) DISPOSAL CELL	SCALE AS NOTED	DATE 01/31/00
CHECKED BY D COMSTOCK	AS-BUILT DRAWINGS		
APPROVED BY	CROSS SECTIONS	DRAWING NO. 0003-02	REV.
	CLIVE, UTAH		

D-2