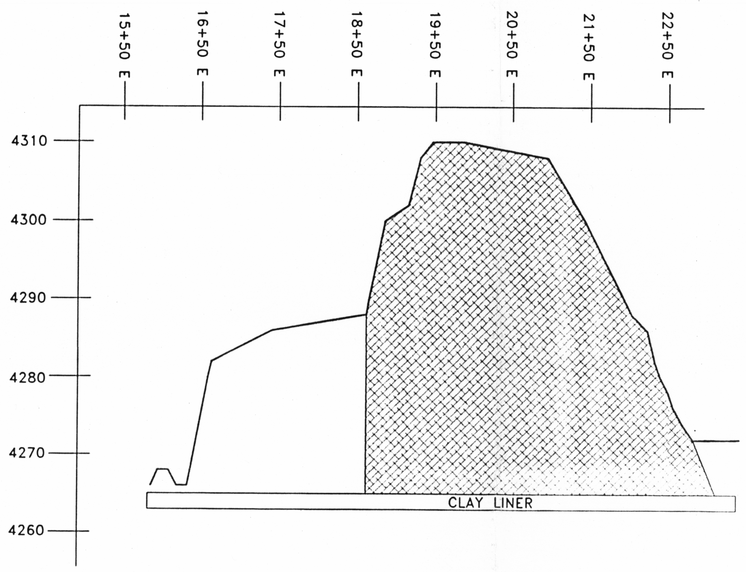

J 0003-03 10+00 N CROSS SECTION
HORIZONTAL SCALE: 1" = 100'
VERTICAL SCALE: 1" = 10'

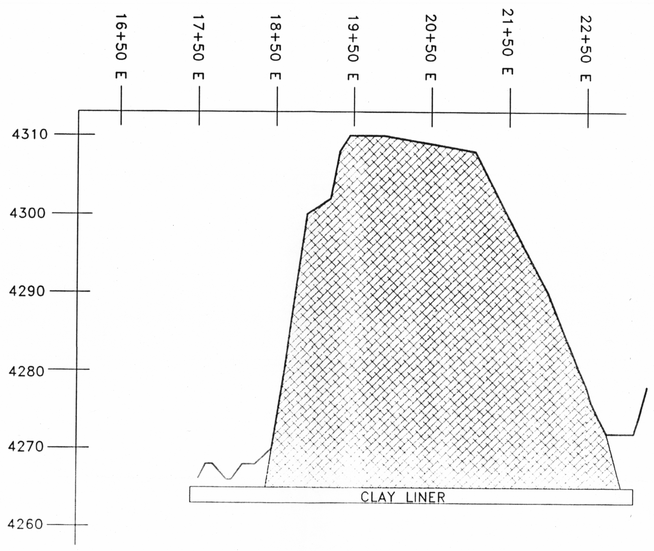

L 0003-03 12+00 N CROSS SECTION
HORIZONTAL SCALE: 1" = 100'
VERTICAL SCALE: 1" = 10'

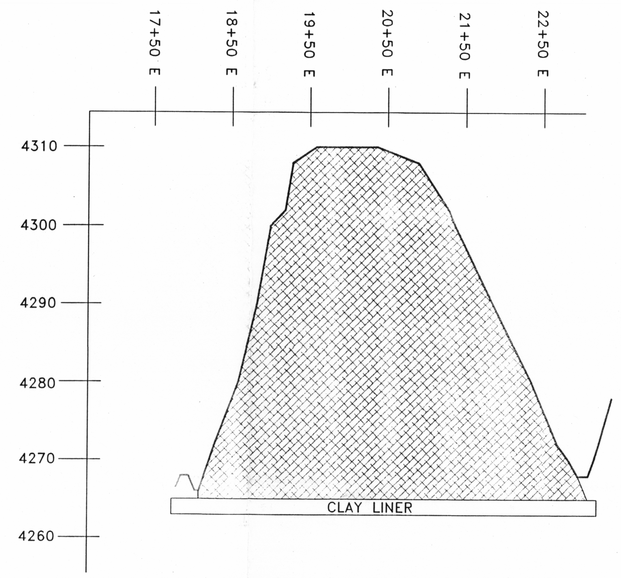

N 0003-03 14+00 N CROSS SECTION
HORIZONTAL SCALE: 1" = 100'
VERTICAL SCALE: 1" = 10'

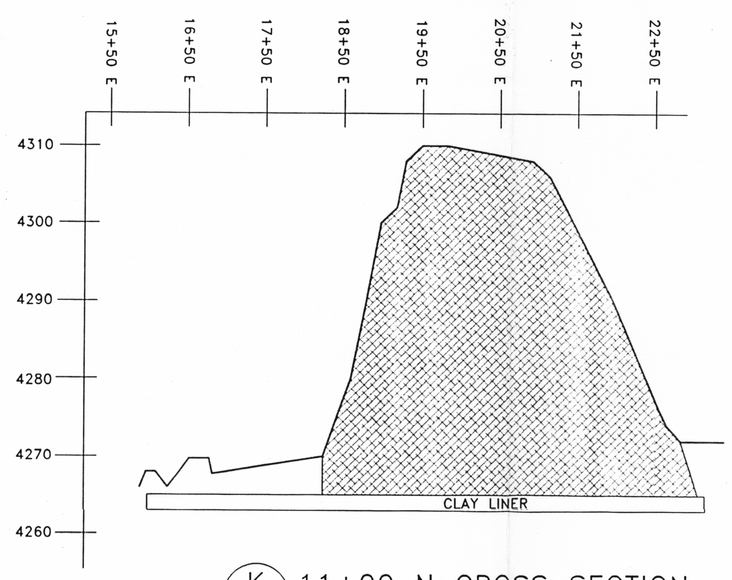

K 0003-03 11+00 N CROSS SECTION
HORIZONTAL SCALE: 1" = 100'
VERTICAL SCALE: 1" = 10'

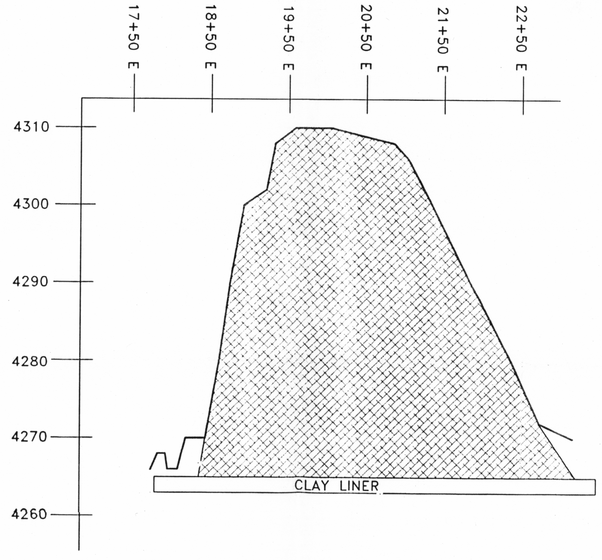

M 0003-03 13+00 N CROSS SECTION
HORIZONTAL SCALE: 1" = 100'
VERTICAL SCALE: 1" = 10'

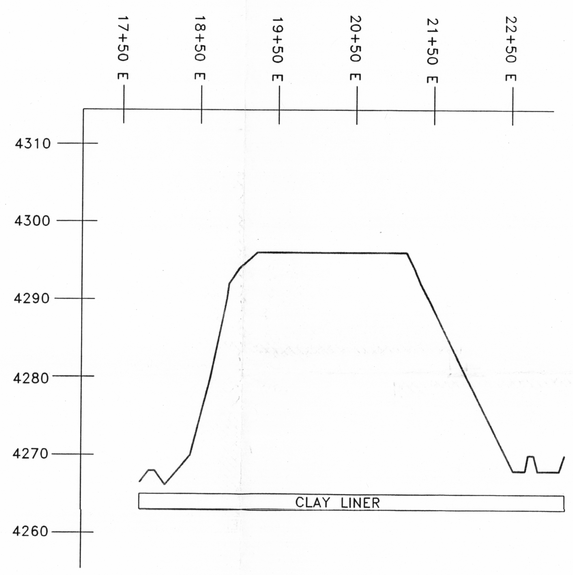

O 0003-03 15+00 N CROSS SECTION
HORIZONTAL SCALE: 1" = 100'
VERTICAL SCALE: 1" = 10'

KEY:

AREAS OF THE EMBANKMENT IN WHICH FINAL COVER HAS BEEN CONSTRUCTED. WASTE IN THESE AREAS IS NOT IN THE OPEN CELL FOOTPRINT OF THE EMBANKMENT

LICENSED PROFESSIONAL ENGINEER
DAVID COMSTOCK, JR.
No. 363847
2/1/00
STATE OF UTAH

DATE	BY	DESCRIPTION OF CHANGE

DATE	BY	DESCRIPTION OF CHANGE

ENVIROCARE OF UTAH, INC.
"THE SAFE ALTERNATIVE"

MADE BY J WEST	11e(2) DISPOSAL CELL	SCALE AS NOTED / DATE 01/31/00
CHECKED BY D COMSTOCK	AS-BUILT DRAWINGS	DRAWING NO. 0003-03 / REV.
APPROVED BY	CROSS SECTIONS	
	CLIVE, UTAH	

D-3