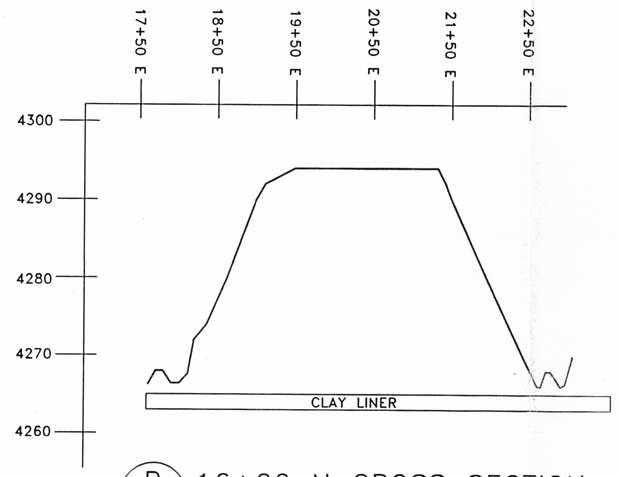

P 0003-04 16+00 N CROSS SECTION
HORIZONTAL SCALE: 1" = 100'
VERTICAL SCALE: 1" = 10'

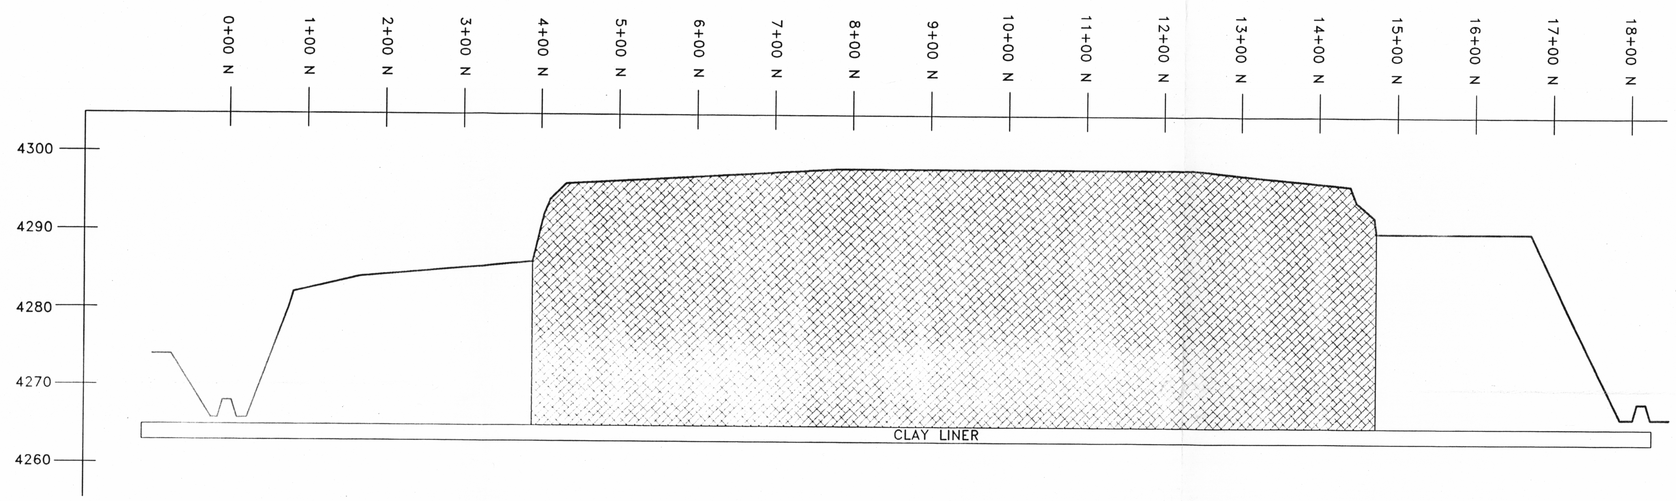

A-A 0003-04 21+50 E CROSS SECTION
HORIZONTAL SCALE: 1" = 100'
VERTICAL SCALE: 1" = 10'

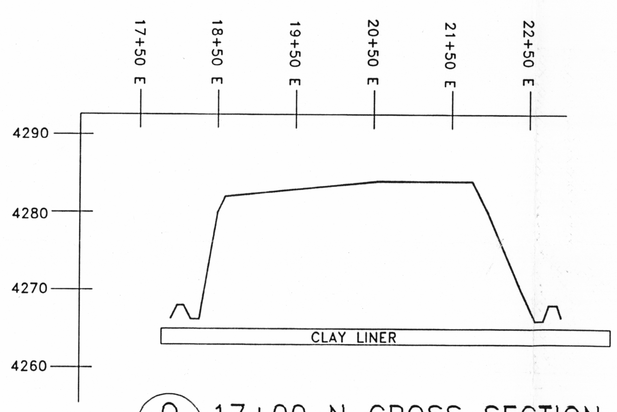

Q 0003-04 17+00 N CROSS SECTION
HORIZONTAL SCALE: 1" = 100'
VERTICAL SCALE: 1" = 10'

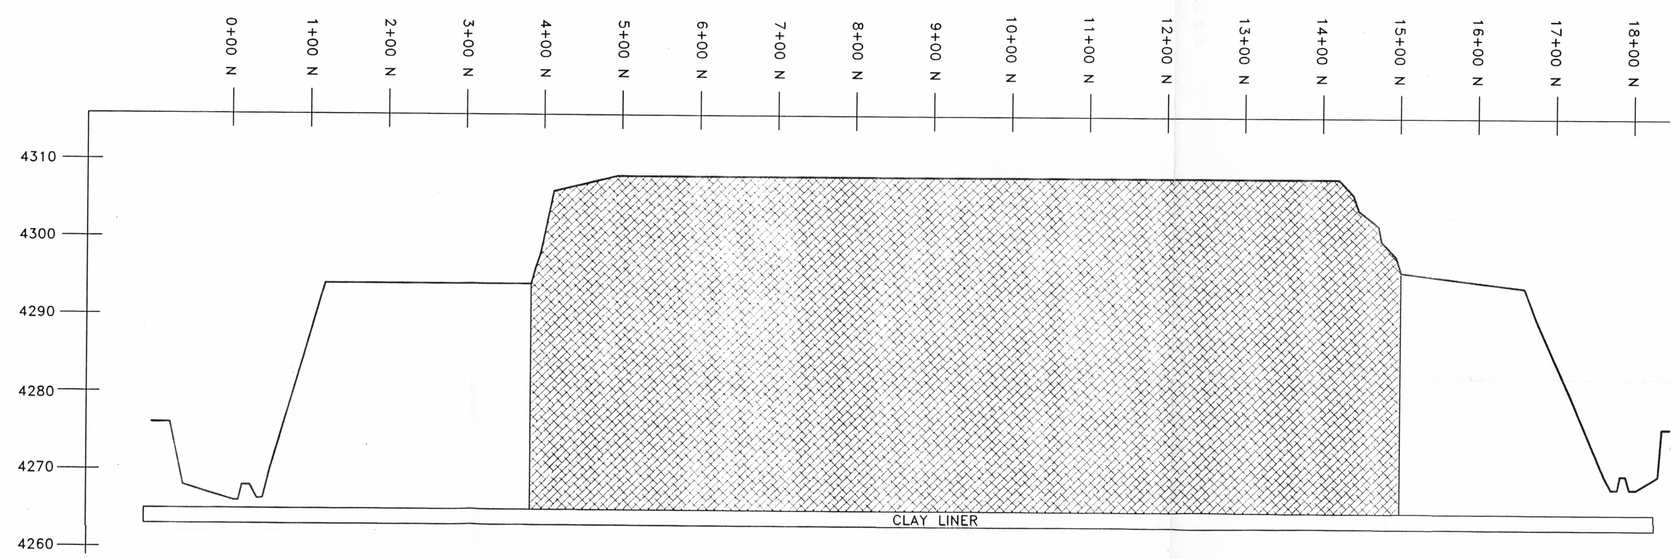

B-B 0003-04 20+50 E CROSS SECTION
HORIZONTAL SCALE: 1" = 100'
VERTICAL SCALE: 1" = 10'

KEY:

AREAS OF THE EMBANKMENT IN WHICH FINAL COVER HAS BEEN CONSTRUCTED. WASTE IN THESE AREAS IS NOT IN THE OPEN CELL FOOTPRINT OF THE EMBANKMENT

LICENSED PROFESSIONAL ENGINEER
DAVID COMSTOCK, JR.
No. 363849
2/1/00
STATE OF UTAH

DATE	BY	DESCRIPTION OF CHANGE	DATE	BY	DESCRIPTION OF CHANGE

ENVIROCARE OF UTAH, INC.
"THE SAFE ALTERNATIVE"

MADE BY: J WEST
CHECKED BY: D COMSTOCK
APPROVED BY:

11e(2) DISPOSAL CELL
AS-BUILT DRAWINGS
CROSS SECTIONS
CLIVE, UTAH

SCALE: AS NOTED
DATE: 01/31/00
DRAWING NO.: 0003-04
REV.:

D-4