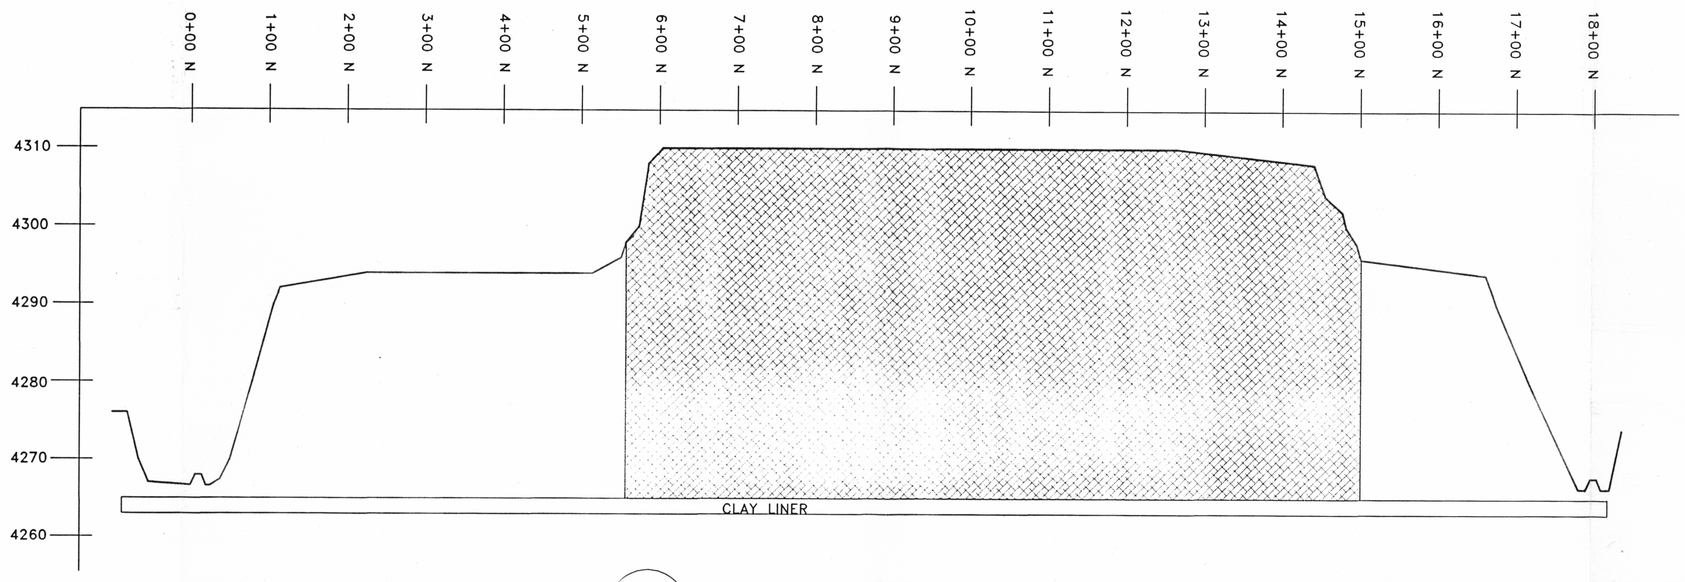

C-C 19+50 E CROSS SECTION
0003-05 HORIZONTAL SCALE: 1" = 100'
VERTICAL SCALE: 1" = 10'

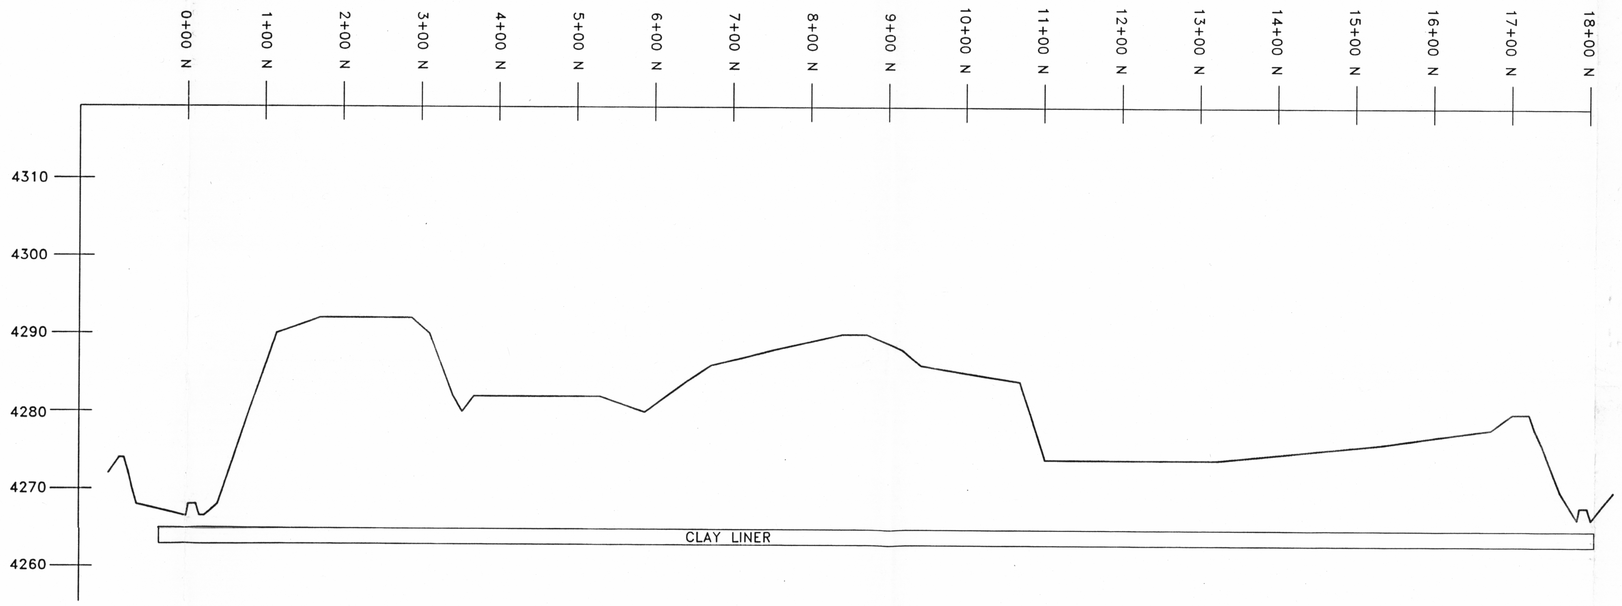

D-D 18+50 E CROSS SECTION
0003-05 HORIZONTAL SCALE: 1" = 100'

KEY:

AREAS OF THE EMBANKMENT IN WHICH FINAL COVER HAS BEEN CONSTRUCTED. WASTE IN THESE AREAS IS NOT IN THE OPEN CELL FOOTPRINT OF THE EMBANKMENT

LICENSED PROFESSIONAL ENGINEER
DAVID COMSTOCK, JR
No. 353849
2/1/00
STATE OF UTAH

DATE	BY	DESCRIPTION OF CHANGE	DATE	BY	DESCRIPTION OF CHANGE

ENVIROCARE OF UTAH, INC.
"THE SAFE ALTERNATIVE"

MADE BY: J WEST	11e(2) DISPOSAL CELL
CHECKED BY: D COMSTOCK	AS-BUILT DRAWINGS
APPROVED BY:	CROSS SECTIONS
	CLIVE, UTAH

SCALE: AS NOTED | DATE: 01/31/00
DRAWING NO.: 0003-05 | REV.: 0

D-5