DRAWING NUMBER

DRAWING NUMBER 3.74-14

DRAWING NUMBER

DRAWING NUMBER 3.74-14

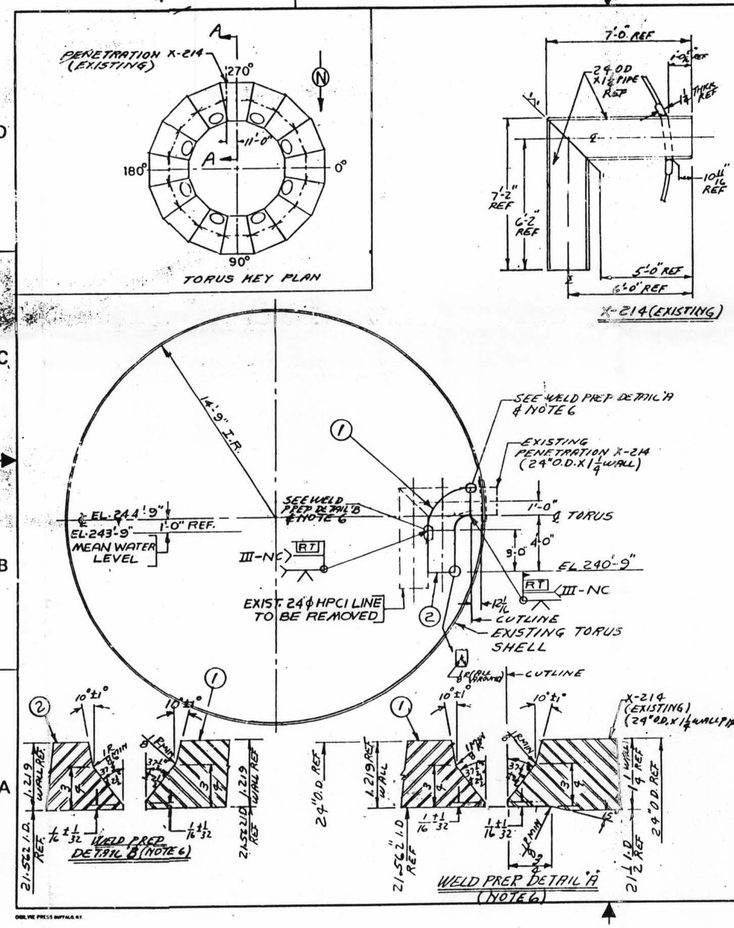

LIST OF MATERIAL

ITEM	IDENT NUMBER	DRAWING NUMBER	DESCRIPTION / MATERIAL	QTY
1			ELBOW: 24" SCH 80 (1.219 WALL) 90° S.R. MAT'L: SA 234	1
2			PIPE: 24 SCH 80 (1.219 WALL) X 3'-0" LONG MATERIAL: SA 333 GRADE 6	1

REFERENCE DRAWINGS
11825-FP-67E
11825-3.74-6

NOTES:

1. QUANTITIES LISTED ARE FOR ONE (1) HPCI LINE AND ONE (1) IS REQUIRED.
2. THE REQUIREMENTS OF THE ASME CODE SECTION III, DIVISION 1, SUBSECTION NC FOR CLASS 2 PIPING SUBASSEMBLIES 1977 EDITION THRU SUMMER 1978 ADDENDA APPLIES TO THIS DRAWING, INCLUDING CODE STAMPING
3. PAINTING SHALL BE BY AN OWNER'S CURRENT APPROVED PAINT SPECIFICATION
4. SHOP DRAWINGS, WELDING AND OTHER FABRICATION & INSTALLATION PROCEDURES ARE TO BE REVIEWED AND APPROVED BY THE OWNER OR OWNER'S AGENT PRIOR TO FABRICATION OR INSTALLATION.
5. THE FOLLOWING SPECIFICATIONS APPLY TO THIS ASSEMBLY:
   OWNER'S SPECIFICATION: OS-2386-3
   SHOP FABRICATION SPECIFICATION: FS-2386-2
6. WELD PREP SHOWN FOR INFORMATION ONLY

REFERENCE DRAWINGS, C.B. & I. CONTRACT NO. 9-857
DRAWING # 31 REV. 10 DETAIL H4

TELEDYNE ENGINEERING SERVICES
ISSUED FOR CONSTRUCTION
TES PROJ. NO. 5324
DATE 11-18-81

FOR INFORMATION ONLY

UNCONTROLLED DRAWING
Copy Date JUN 28 2000
CAUTION — Extended use of this drawing copy may result in its inaccuracy due to subsequent design changes and drawing updates

REV.	DESCRIPTION	DRWN BY	ENG	VERIF	APPR.	DATE
1	ORIGINAL ISSUE					
	AS-BUILT PER MOD # M-81-024					

REVISION BY NYPA

REV	DATE	D.C.O.	ZONE	DESCRIPTION	DRAWN	CHKD	ANAL	ENGR	DWG. CHK
2	9/14/81	2805	—	REVISED NOTE #3 PAINT SPEC					
1	7/24/81	2667	—	REVISED PER TES DWG.					

REVISIONS

UNLESS OTHERWISE SPECIFIED DIMENSIONS ARE IN INCHES TOLERANCES ON FRACTIONS ±1/8 DECIMALS ±.2 ANGLES ±2°
FINISH √32
SCALE NOTED
USED ON/NEXT ASSY

TELEDYNE ENGINEERING SERVICES
WALTHAM, MASS.

TITLE MODIFICATION TO EXISTING 24" HPCI LINE (X-214) FITZPATRICK

PROJ. NO. 2386 DRAWING NO. C-5493 REV. 2

JAMES A. FITZPATRICK NUCLEAR POWER PLANT
POWER AUTHORITY OF THE STATE OF NEW YORK

TITLE: MODIFICATION TO EXISTING 24" HPCI LINE (X-214)
COMPONENT I.D. Nº
VENDOR: TELEDYNE
VENDOR DWG. Nº C-5493
FILE Nº 11825-3.74-14 REV. A

FOR INFORMATION ONLY

D-3