1-NHY-650008




SECTION 'D-D'




HEAD ASSEMBLY

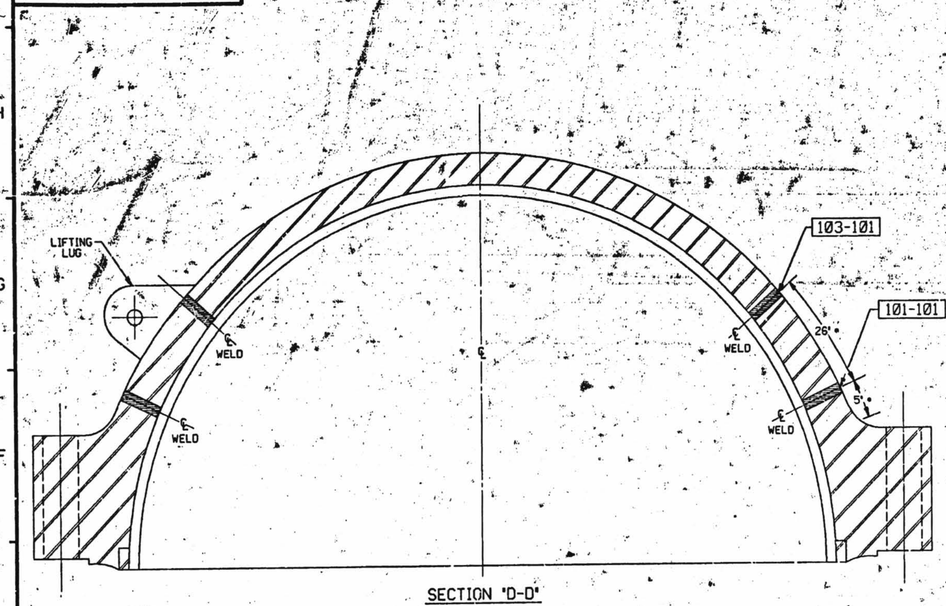


VIEW 'E-E'

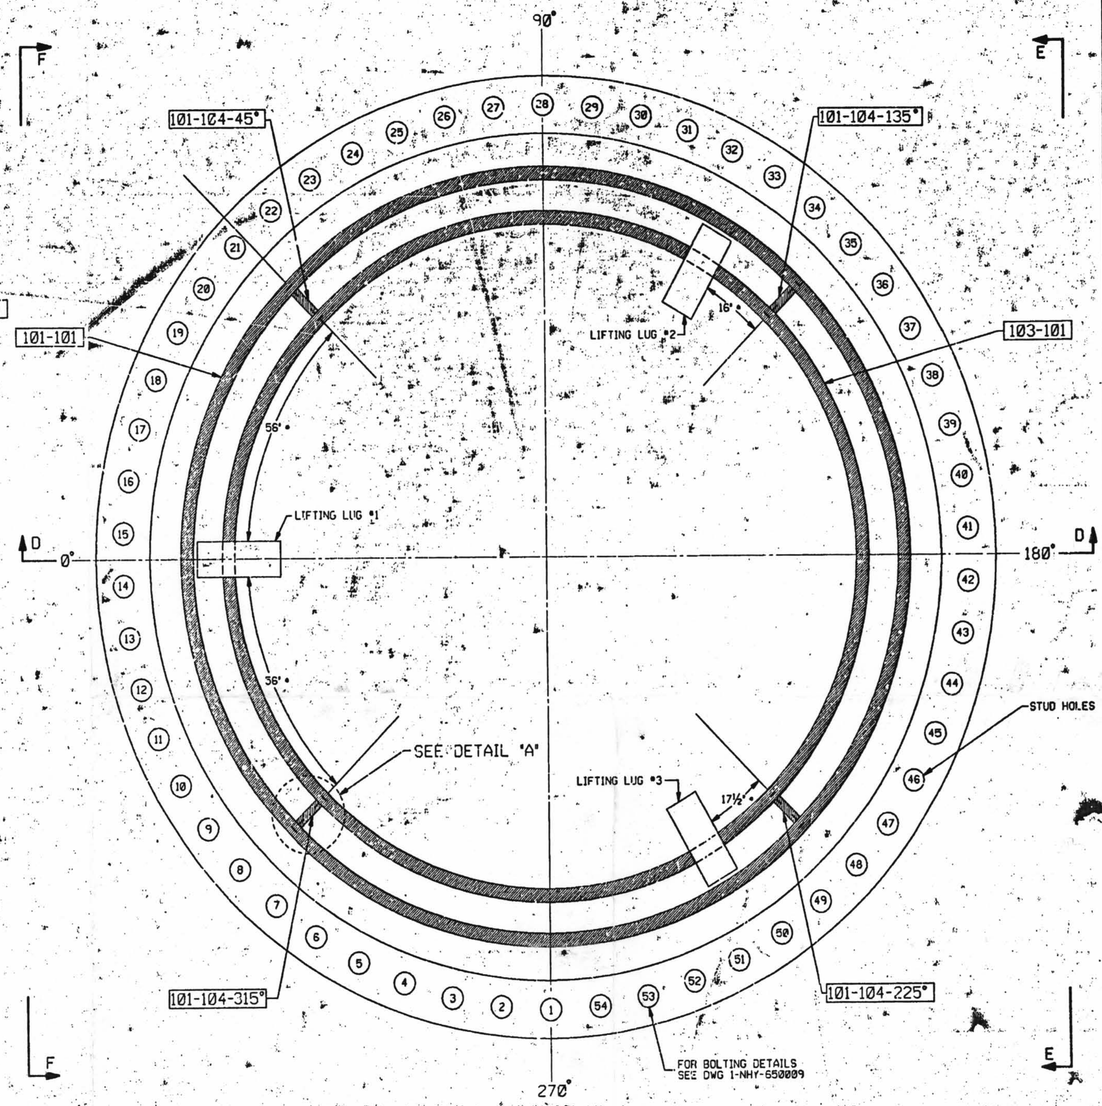


VIEW 'F-F'

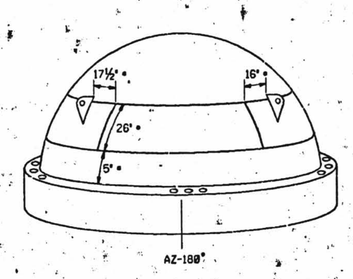


DETAIL 'A'

NOTES:

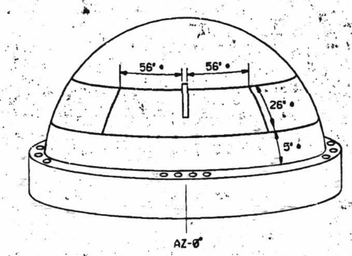1. DRAWING NOT TO SCALE.
2. DIMENSIONS (*) ARE FIELD DIMENSIONS.
3. DISTANCE FROM LIFTING LUG IS MEASUERD FOLLOWNG UPPER WELDED SEAM CENTER.
4. MEASUREMENTS TO BE TAKEN WITH A FLEXIBLE TAPE FOLLOWING CONTOUR OF HEAD ASSEMBLY.
5. WELD IDENTIFICATION NOS. HAVE THE PREFIX 1-SB-RV-.
6. WORK THIS DRAWING WITH 650007, 650008 AND 650010.
7. WESTINGHOUSE SHOP ORDER NSS-105

FOR INFORMATION ONLY
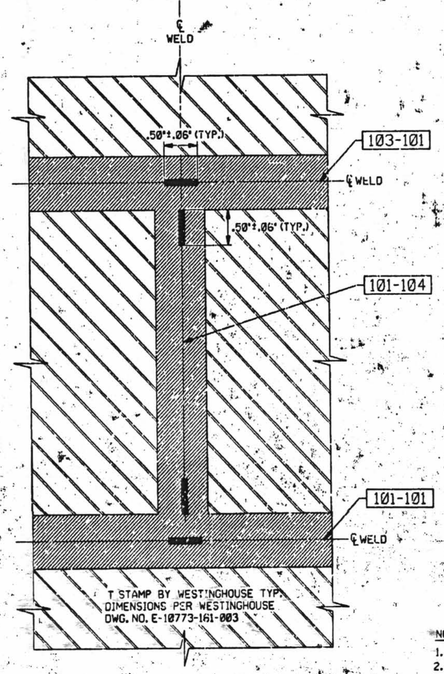
| REV | DATE | DSGN | DRWN | CHKD | CE | LDE | DESCRIPTION |
|---|---|---|---|---|---|---|---|
| 0 | 3/27/79 | MPV | JM | [illegible] | [illegible] | [illegible] | ORIGINAL ISSUE |

New Hampshire Yankee

SEABROOK STATION

REACTOR VESSEL
RC-E-1
ISI EQUIPMENT WELDS

1-NHY-650008

| REF. DRAWING NO. | REV | TITLE |
|---|---|---|
| FP-52666 | 01 | AS-BUILT LOCATION OF WELD SEAMS |

D-9