1-NHY-650009

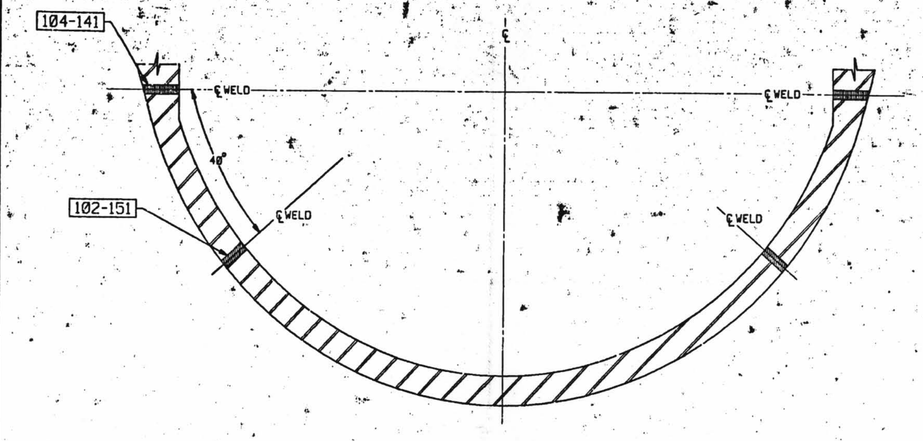

SECTION "G-G"

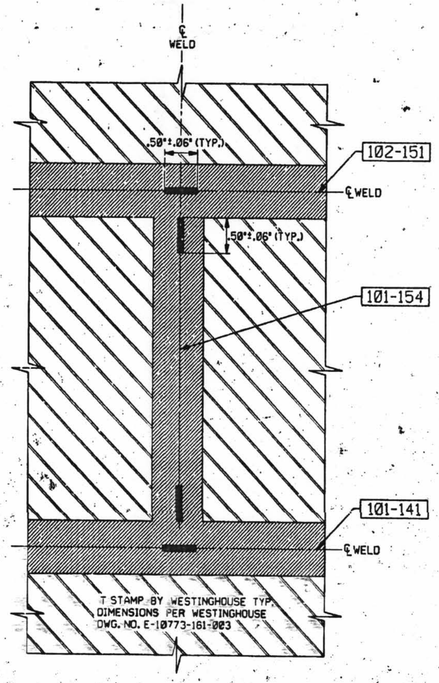

DETAIL "B"

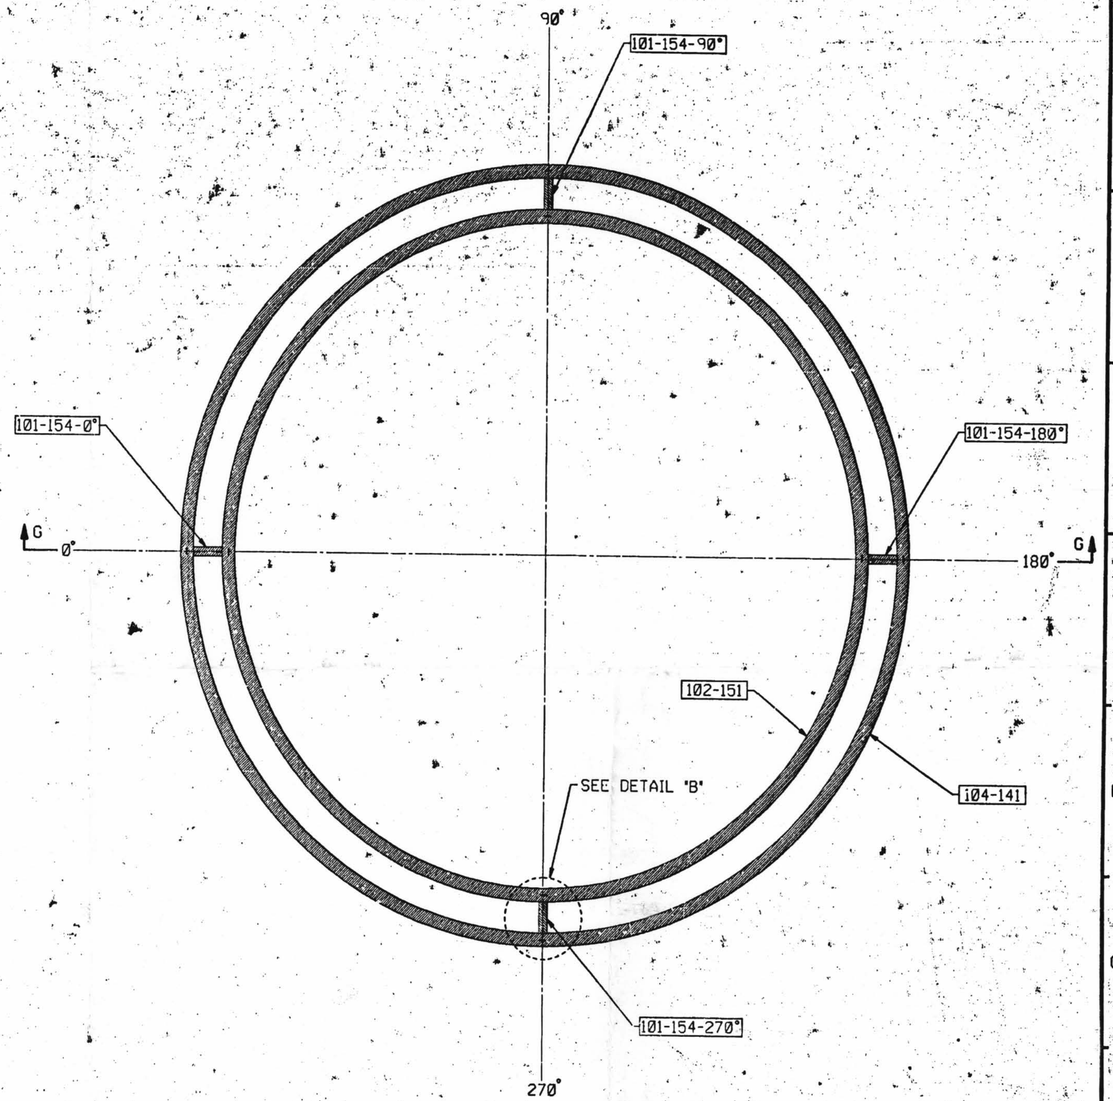

BOTTOM ASSEMBLY
BOTTOM VIEW

FOR INFORMATION ONLY

NOTES:
1. WELD IDENTIFICATION NOS. HAVE THE PREFIX 1-SB-RV-.
2. DRAWING NOT TO SCALE.
3. WORK THIS DRAWING WITH 650007, 650008 AND 650010.
4. WESTINGHOUSE SHOP ORDER NSS-105

REV	DATE	DSGN	DRWN	CHKD	QE	LDE	DESCRIPTION
0	3-27-73	MPW	JM	[illegible]	[illegible]	[illegible]	ORIGINAL ISSUE

New Hampshire Yankee

SEABROOK STATION

REACTOR VESSEL
RC-E-1
ISI EQUIPMENT WELDS

1-NHY-650009

FP-52668 — REF. DRAWING NO.

01 — REV

AS-BUILT LOCATION OF WELD SEAMS — TITLE

D-10