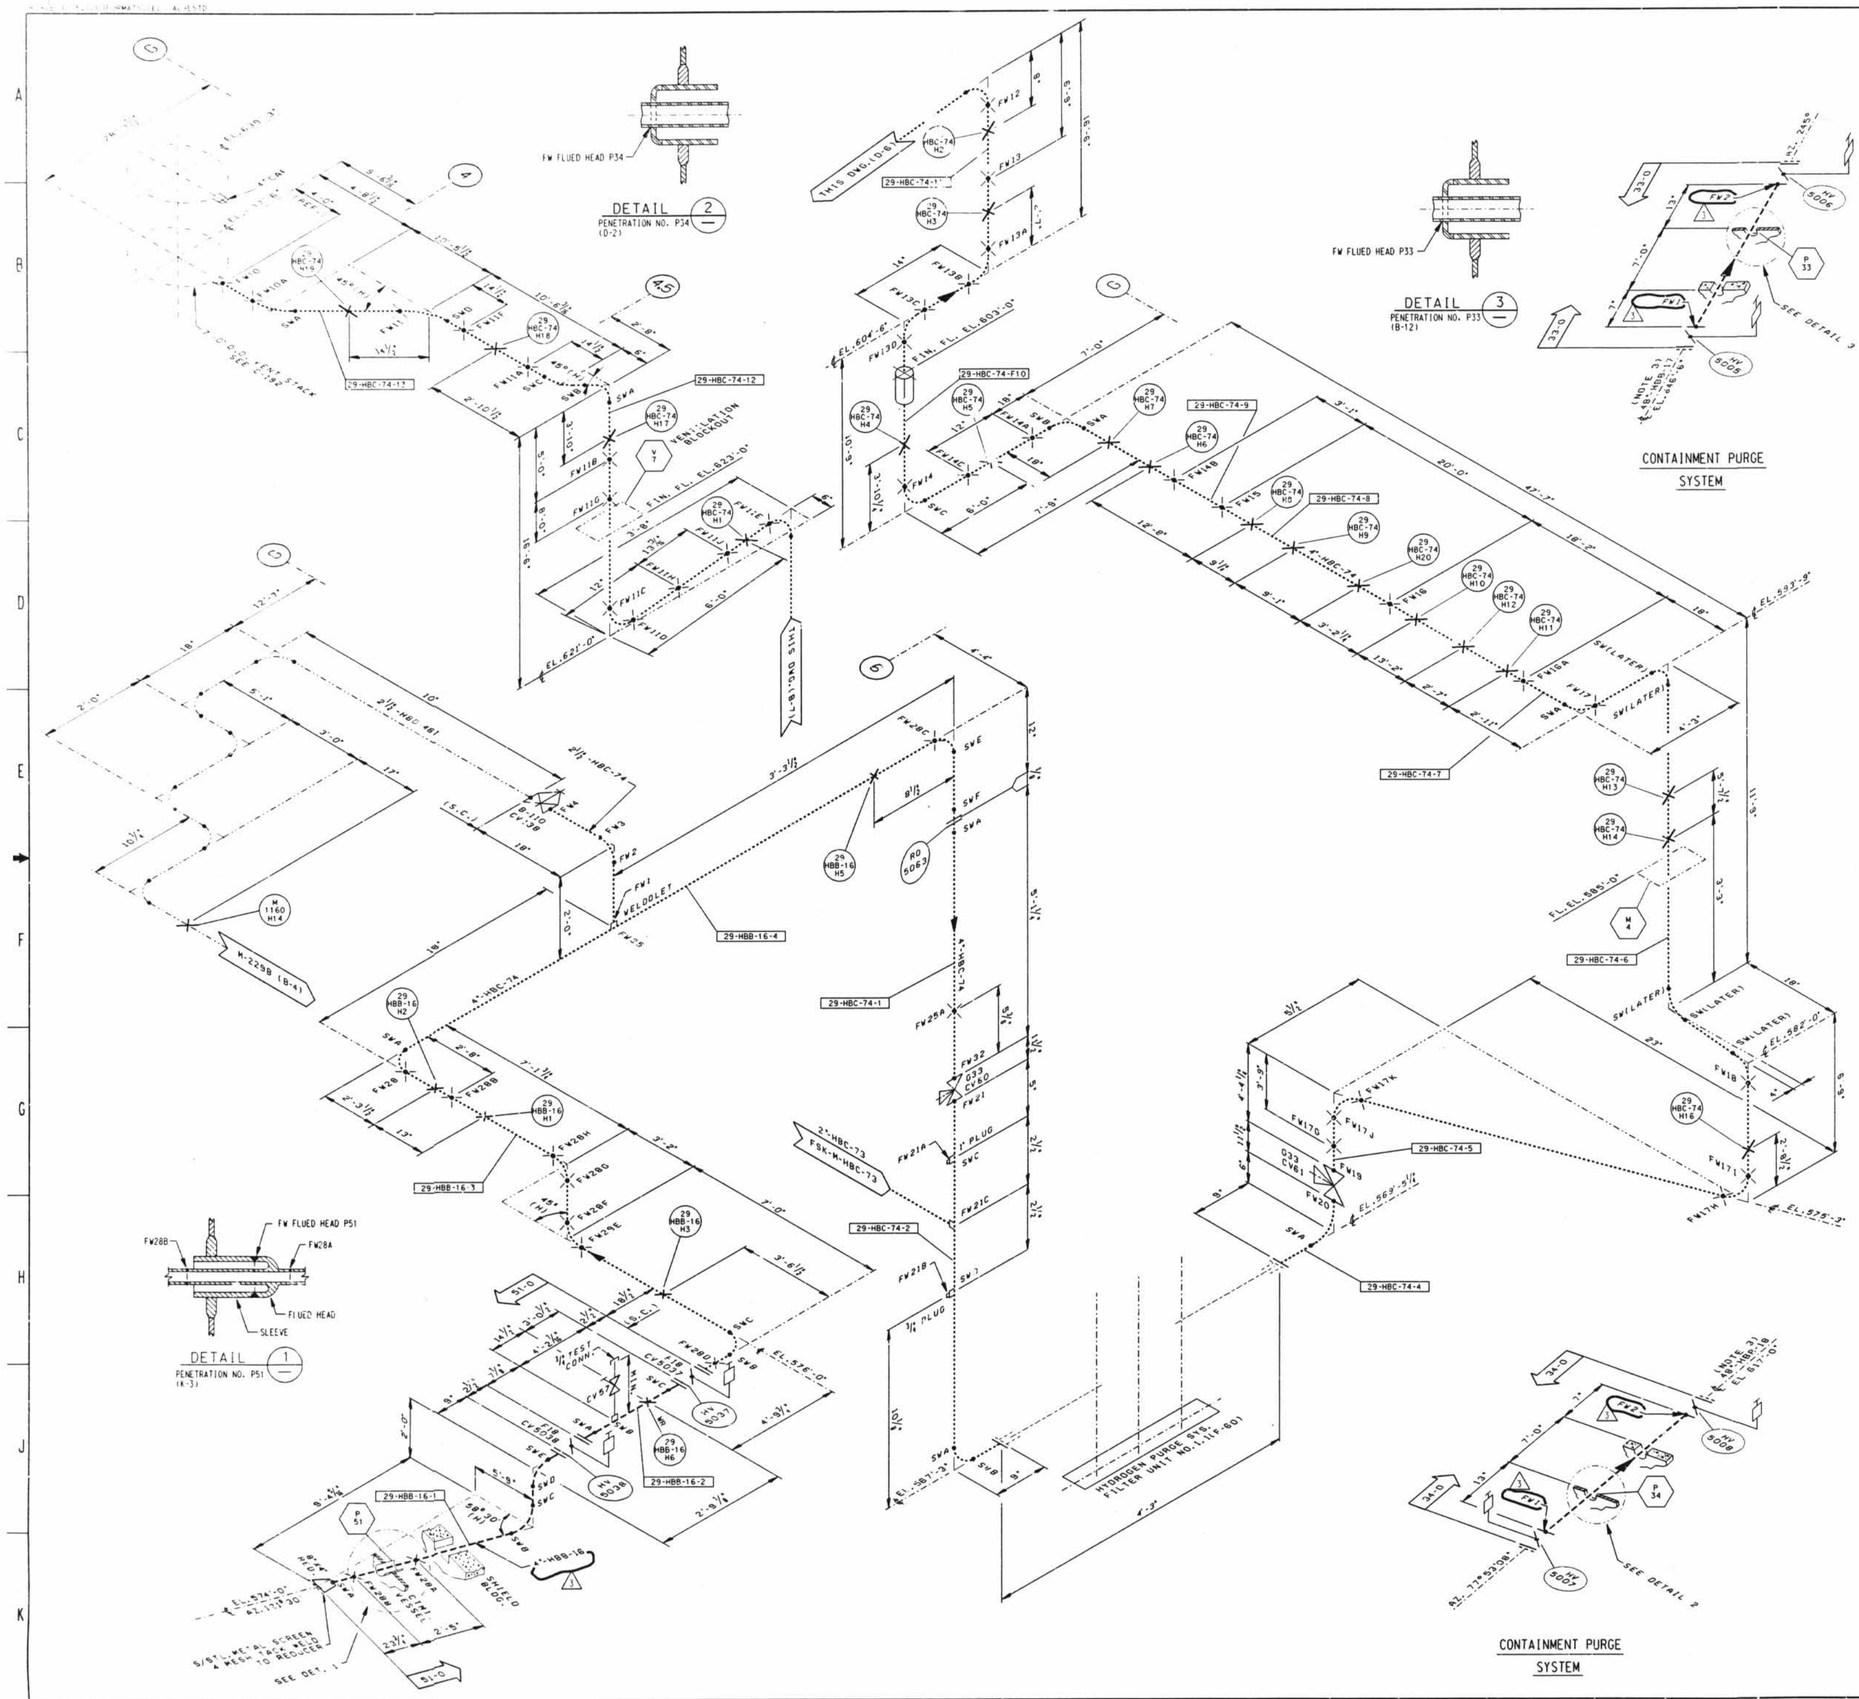

LEGEND

- ASME SECTION XI CLASS 1 PIPING
- ASME SECTION XI CLASS 2 PIPING
- ASME SECTION XI CLASS 3 PIPING
- NON-ISI NUCLEAR CLASS AND HSC CLASS
- PRESSURE BOUNDARY EXTENSION
- REFERENCE & CONTINUITY
- HVAC DUCT
- A — ANCHOR
- CS — CONSTANT SPRING HANGER
- VS — VARIABLE SPRING HANGER
- HS — HYDRAULIC SNUBBER
- MS — MECHANICAL SNUBBER
- N — NON-WELDED SUPPORT ATTACHMENT
- W — WELDED INTEGRAL SUPPORT ATTACHMENT
- R — RIGID SUPPORT
- T — SWAY STRUT
- SW — SHOP WELD
- FW — FIELD WELD
- LW — LONGITUDINAL WELD
- WOL — WELDOLET
- ISI ITEM NUMBER DESIGNATION USED IN THE FIRST 10 YEAR INSERVICE INSPECTION INTERVAL.

NOTES:

1. MULTIPLE SWAY STRUTS, SPRING SUPPORTS OR SNUBBERS IN A SINGLE PIPING SUPPORT ARE SHOWN BY A NUMBER BEFORE THE SUPPORT TYPE. (EXAMPLE: 2NHS - TWO HYDRAULIC TYPE SNUBBERS THAT ARE NOT WELDED INTEGRAL TO THE PIPE).
2. PIPING SYSTEMS ON THIS DRAWING WHICH ARE OUTSIDE OF THE ISI BOUNDARY, ARE SHOWN FOR REFERENCE AND CONTINUITY PURPOSES ONLY. THE CONFIGURATION SHOWN MAY NOT REPRESENT THE ACTUAL AS-BUILT CONDITION.

GENERAL NOTE

DIMENSIONS SHOWN ON THIS DRAWING ARE TO BE USED FOR APPROXIMATE LOCATION ONLY. USE DESIGN DRAWINGS FOR DIMENSIONAL VERIFICATION.

REFERENCE DRAWINGS:

ISID2-029D CONTAINMENT AND PENETRATION ROOMS SHEET 3

ISID2-029E CONTAINMENT AND PENETRATION ROOMS SHEET 4

7749-M-437 CONTAINMENT PURGE SYSTEM SECTIONS AND ELEVATIONS

NO.	DATE	REVISIONS	BY	CH'K	ENGR	ENGR. SUPV.	ENG. MGR.
3	6/27/94	INC. DCN ISIM2-229-6 FOR RFA 94-108	JFS				
2	7/7/93	INC. DCN ISIM2-229-4 FOR RFA 93-0254	"INITIALS ON FILE"				
1	4/9/92	INC. DCN ISIM2-229-2 FOR DCR 91-0011	"INITIALS ON FILE"				
0	9/17/90	ISSUED FOR SECOND 10 YEAR ISI PROGRAM	LPM	TRN RJC	TWB	MGP	ECC

SCALE N.T.S. DESIGNED DRAWN CB DATE

DAVIS-BESSE NUCLEAR POWER STATION
UNIT NO. 1
THE TOLEDO EDISON COMPANY

INSERVICE INSPECTION ISOMETRIC
HYDROGEN DILUTION SYSTEM & MISC. CONTAINMENT PENETRATIONS
AUXILIARY AND CONTAINMENT BUILDINGS

DRAWING NO. ISIM2-229 (SHEET 2) REV. 3

DB 05-09-94 DFN= 1/ISIM/ 2IM2292.DGN

LEVELS 1234567890123456789012345678901234567890123456789012345678901234567890123456789012

14 34X44 SIZE PSC= 101

I CERTIFY THAT THE IMAGE CONTAINED ON THIS FRAME WAS MADE IN THE NORMAL AND REGULAR COURSE OF BUSINESS, ON THE DATE STATED BELOW AND THAT IT IS AN ACCURATE REPRODUCTION OF THE RECORD OF SUBMITTED TO NUCLEAR RECORDS MANAGEMENT.

6-27-94 OPERATOR 30X

D-6