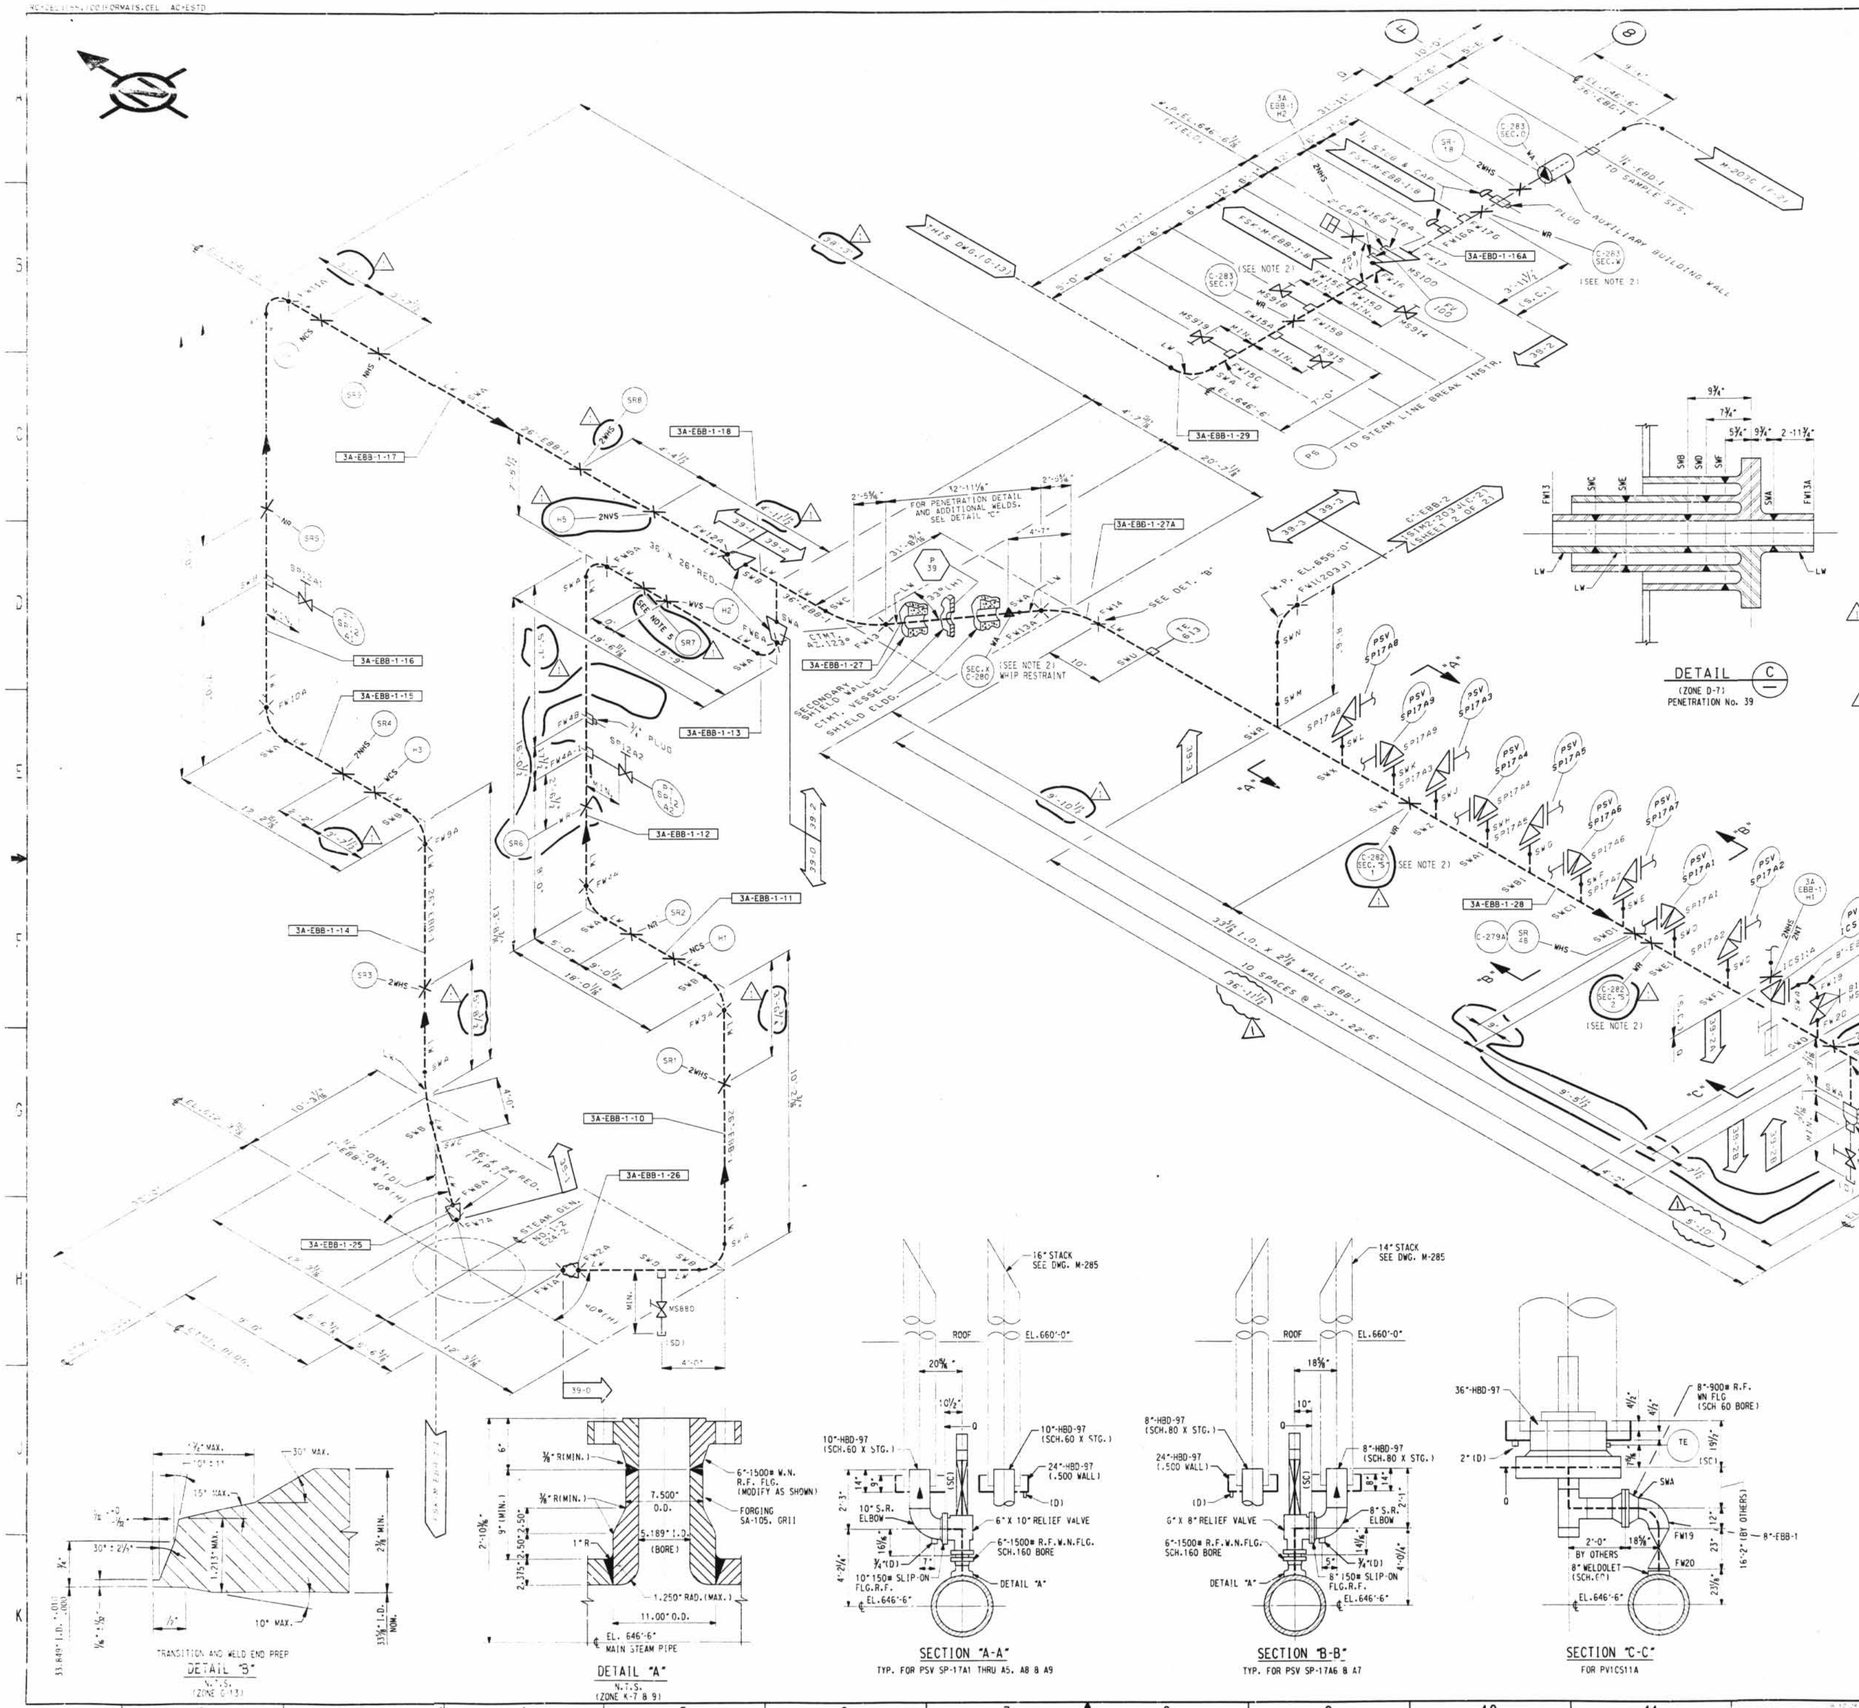

LEGEND

- ASME SECTION XI CLASS 1 PIPING
- ASME SECTION XI CLASS 2 PIPING
- ASME SECTION XI CLASS 3 PIPING
- NON-ISI NUCLEAR CLASS AND HSC CLASS
- PRESSURE BOUNDARY EXTENSION
- REFERENCE & CONTINUITY
- HVAC DUCT

A	ANCHOR
CS	CONSTANT SPRING HANGER
VS	VARIABLE SPRING HANGER
HS	HYDRAULIC SNUBBER
MS	MECHANICAL SNUBBER
N	NON-WELDED SUPPORT ATTACHMENT
W	WELDED INTEGRAL SUPPORT ATTACHMENT
R	RIGID SUPPORT
T	SWAY STRUT
SW	SHOP WELD
FW	FIELD WELD
LW	LONGITUDINAL WELD
WOL	WELDOLET

ISI ITEM NUMBER DESIGNATION USED IN THE FIRST 10 YEAR INSERVICE INSPECTION INTERVAL.

NOTES:

1. MULTIPLE SWAY STRUTS, SPRING SUPPORTS OR SNUBBERS IN A SINGLE PIPING SUPPORT ARE SHOWN BY A NUMBER BEFORE THE SUPPORT TYPE. (EXAMPLE: 2HS - TWO HYDRAULIC TYPE SNUBBERS THAT ARE NOT WELDED INTEGRAL TO THE PIPE).
2. FOR SUPPORT DETAILS SEE REFERENCED CIVIL DRAWINGS.
3. BRANCH CONNECTION CONFIGURATION SAME AS SHOWN ON DRAWING 203A TYPICAL.
4. PIPING SYSTEMS ON THIS DRAWING WHICH ARE OUTSIDE OF THE ISI BOUNDARY, ARE SHOWN FOR REFERENCE AND CONTINUITY PURPOSES ONLY. THE CONFIGURATION SHOWN MAY NOT REPRESENT THE ACTUAL AS-BUILT CONDITION.
5. SR7 IS NOT WITHIN THE SCOPE OF THE ISI PROGRAM. THE SR7 BUILDING STRUCTURE IS NOT ATTACHED TO THE PIPE DUE TO THE REMOVAL OF THE SR7 HYDRAULIC SNUBBER VIA. MOD 90-0013.

GENERAL NOTE

DIMENSIONS SHOWN ON THIS DRAWING ARE TO BE USED FOR APPROXIMATE LOCATION ONLY. USE DESIGN DRAWINGS FOR DIMENSIONAL VERIFICATION.

REFERENCE DRAWINGS:

ISI2-003A	MAIN STEAM AND REHEAT STEAM, SHEET 1
ISI2-007A	STEAM GENERATOR SECONDARY SYSTEM
7749-C-607	CONTAINMENT INTERNAL STRUCTURES, MAIN STEAM LINE SEISMIC RESTRAINTS ELEVATION & DETAILS, SHEET 1 OF 8
7749-C-280	AUXILIARY BUILDING MAIN STEAM LINE RESTRAINTS DETAILS SHEET 2
7749-C-775	MAIN STEAM ISOLATION & ATMOS. VENT VALVES HANGERS & RESTRAINTS

DETAIL "B"
N.T.S.
(ZONE G-13)

DETAIL "A"
N.T.S.
(ZONE K-7 & 9)

SECTION "A-A"
TYP. FOR PSV SP-17A1 THRU A5, A8 & A9

SECTION "B-B"
TYP. FOR PSV SP-17A6 & A7

SECTION "C-C"
FOR PVICS11A

1	INC DCN, SIM2-203B-1-2 & 3 REF. DCR 91-0011, DEN UPDATE CORRECT DIM FOR SR-19 LOCATION, SOV. PER HL-2039 & ADD 2"X1" SOV. BACK 10'-7" PER M-2039. VERIFIED		
0	ISSUED FOR SECOND 10 YEAR ISI PROGRAM	LPM	TRN TWB MGF RJC

N.T.S. — CB

DAVIS-BESSE NUCLEAR POWER STATION
UNIT NO. 1 Q

INSERVICE INSPECTION ISOMETRIC
MAIN STEAM SYSTEM

CONTAINMENT BUILDING STEAM GENERATOR 1-2

ISIM2-203B 1

D-96

I CERTIFY THAT THE IMAGE CONTAINED ON THIS FRAME WAS MADE IN THE NORMAL AND REGULAR COURSE OF BUSINESS, ON THE DATE STATED BELOW AND THAT IT IS AN ACCURATE REPRODUCTION OF THE RECORD(S) SUBMITTED TO NUCLEAR RECORDS MANAGEMENT.
DATE 6-10-92 OPERATOR 30X