RC-CEL:155:1001FORMATS.CEL AC-E7749

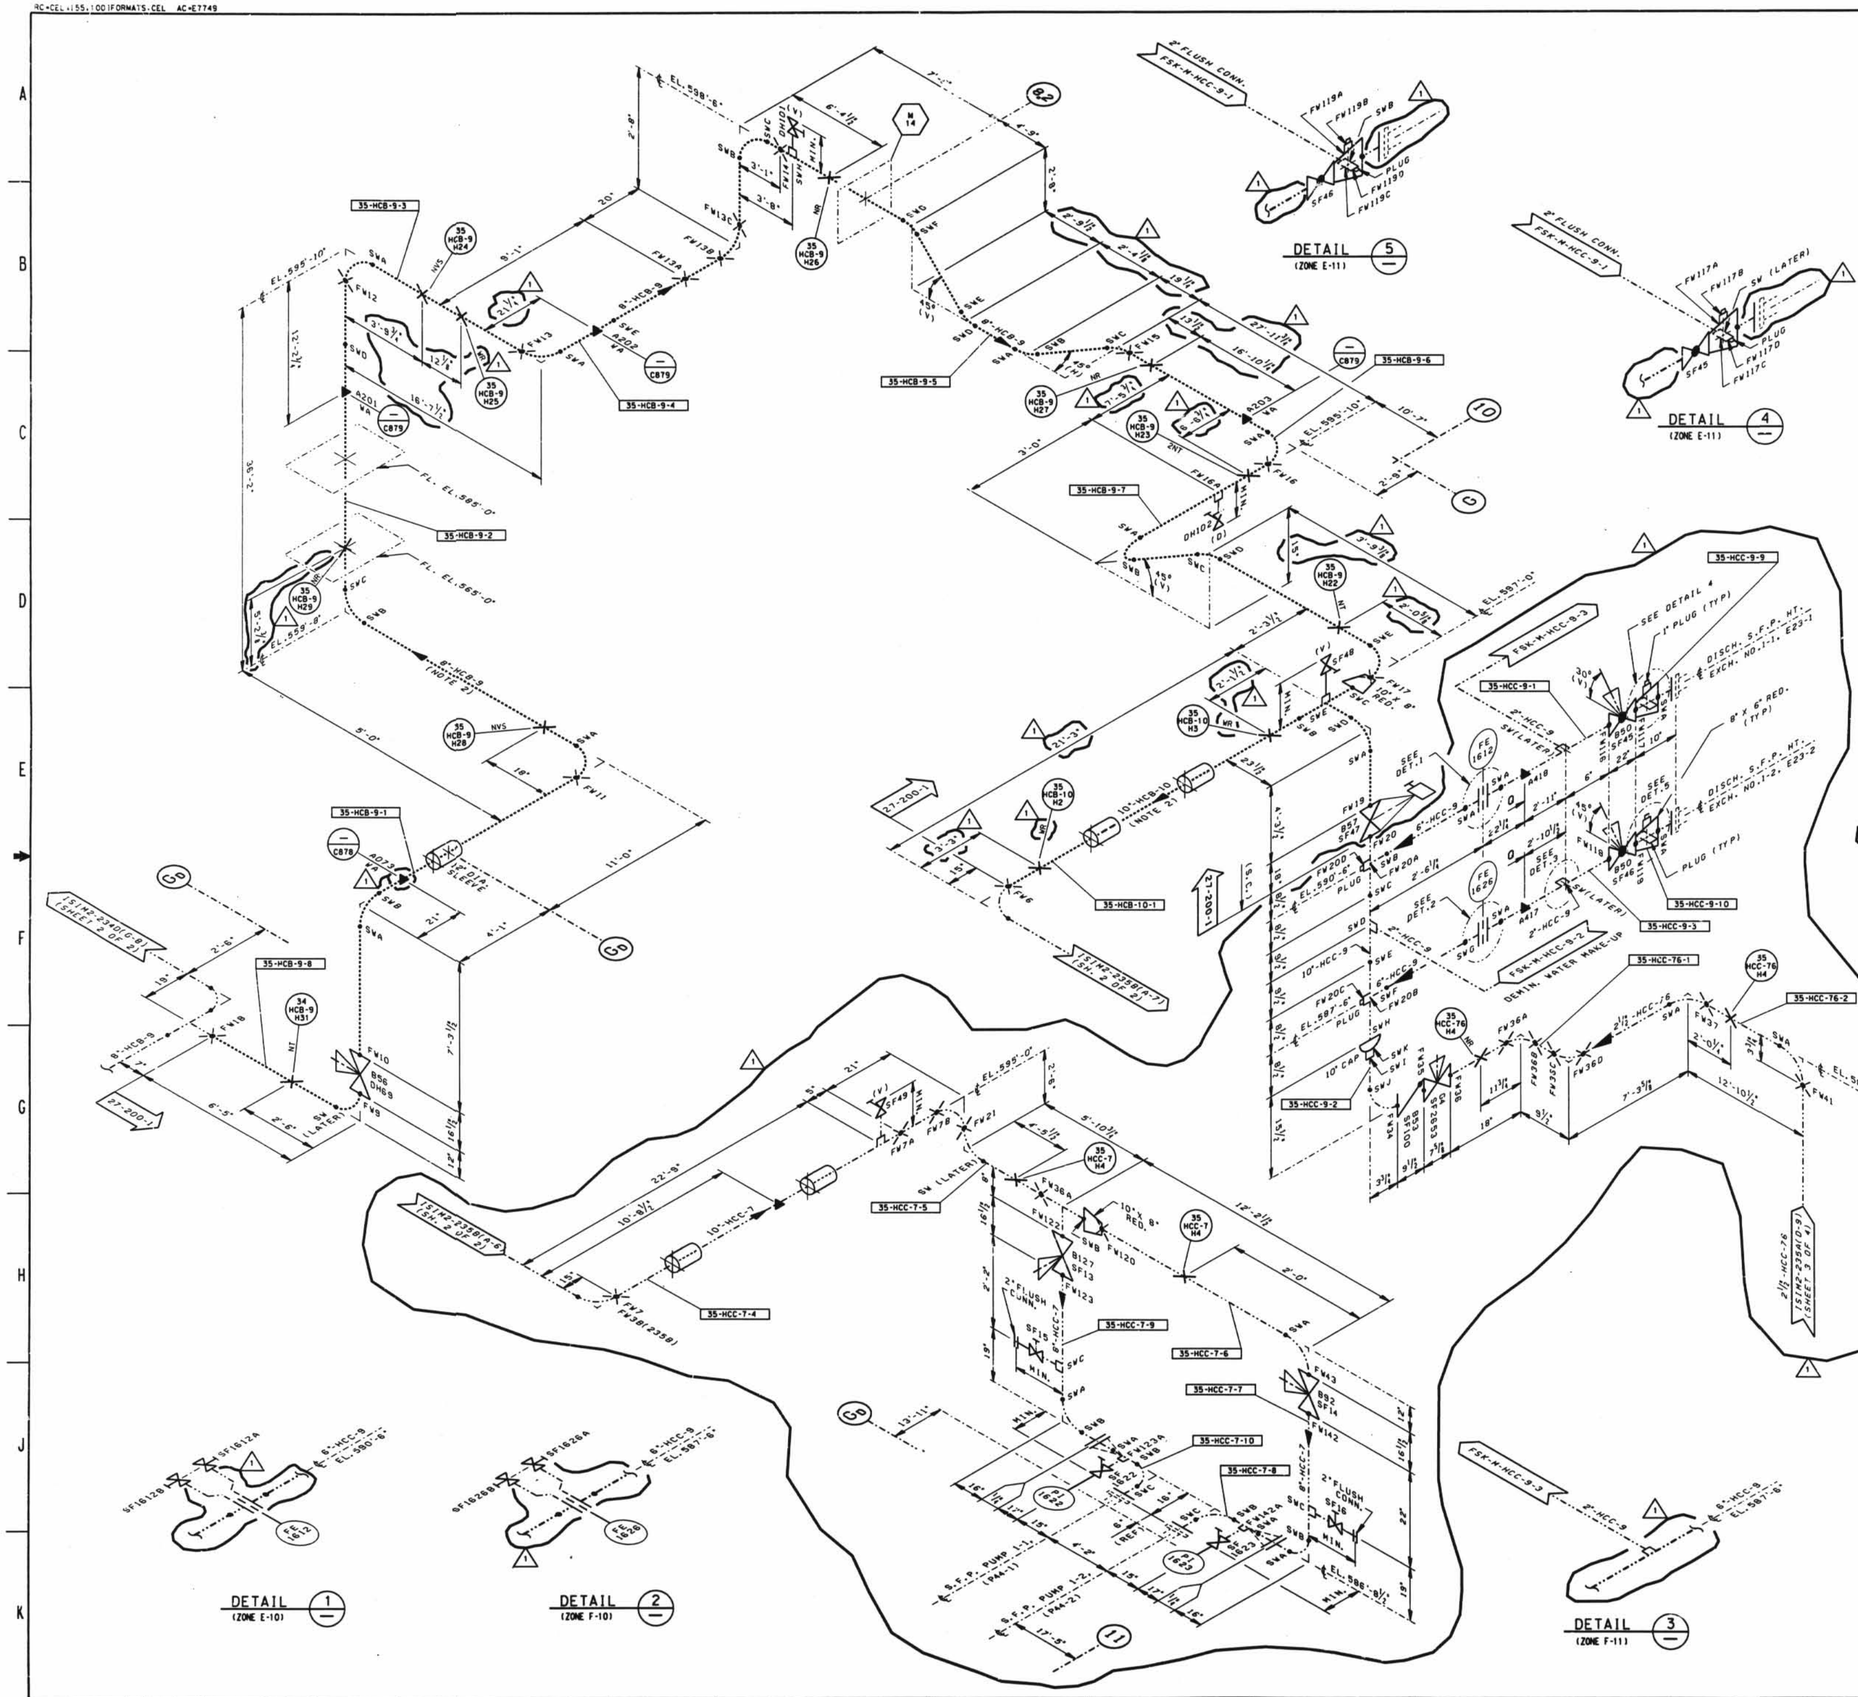

LEGEND

- ASME SECTION XI CLASS 1 PIPING
- ASME SECTION XI CLASS 2 PIPING
- ASME SECTION XI CLASS 3 PIPING
- NON-ISI NUCLEAR CLASS AND HSC CLASS
- PRESSURE BOUNDARY EXTENSION
- REFERENCE & CONTINUITY
- D — D — HVAC DUCT
- A — ANCHOR
- CS — CONSTANT SPRING HANGER
- VS — VARIABLE SPRING HANGER
- HS — HYDRAULIC SNUBBER
- MS — MECHANICAL SNUBBER
- N — NON-WELDED SUPPORT ATTACHMENT
- W — WELDED INTEGRAL SUPPORT ATTACHMENT
- R — RIGID SUPPORT
- T — SWAY STRUT
- SW — SHOP WELD
- FW — FIELD WELD
- LW — LONGITUDINAL WELD
- WOL — WELDOLET
- ISI ITEM NUMBER DESIGNATION USED IN THE FIRST 10 YEAR INSERVICE INSPECTION INTERVAL.

NOTES:

1. MULTIPLE SWAY STRUTS, SPRING SUPPORTS OR SNUBBERS IN A SINGLE PIPING SUPPORT ARE SHOWN BY A NUMBER BEFORE THE SUPPORT TYPE. (EXAMPLE: 2MHS - TWO HYDRAULIC TYPE SNUBBERS THAT ARE NOT WELDED INTEGRAL TO THE PIPE).
2. THE SPENT FUEL POOL COOLING LINE 8"-HCB-9 & 10"-HCB-10 WELDS AND SUPPORTS ARE EXEMPT FROM INSERVICE EXAMINATION REQUIREMENTS PER IWD 1220. THE WELDS AND SUPPORTS SHOWN MAY NOT REPRESENT THE ACTUAL AS-BUILT CONDITION.
3. PIPING SYSTEMS ON THIS DRAWING WHICH ARE OUTSIDE OF THE ISI BOUNDARY, ARE SHOWN FOR REFERENCE AND CONTINUITY PURPOSES ONLY. THE CONFIGURATION SHOWN MAY NOT REPRESENT THE ACTUAL AS-BUILT CONDITION.

GENERAL NOTE:

DIMENSIONS SHOWN ON THIS DRAWING ARE TO BE USED FOR APPROXIMATE LOCATION ONLY. USE DESIGN DRAWINGS FOR DIMENSIONAL VERIFICATION.

REFERENCE DRAWINGS:

ISI02-033A HIGH PRESSURE INJECTION
ISI02-035 SPENT FUEL POOL COOLING SYSTEM

NO.	DATE	REVISIONS	BY	CH'K	ENGR	ENGR SUPV	ENG MGR
1		INC. DCN'S ISIM2-235A-1 & 2 FOR DCR 91-0011	JAD				
0	9-17-90	ISSUED FOR SECOND 10 YEAR ISI PROGRAM	"INITIALS ON FILE"				

SCALE N.T.S. DESIGNED DRAWN CB DATE

DAVIS-BESSE NUCLEAR POWER STATION
UNIT NO. 1 Q
THE TOLEDO EDISON COMPANY

INSERVICE INSPECTION ISOMETRIC
SPENT FUEL POOL COOLING SYSTEM
AUXILIARY BUILDING-AREA 7

DRAWING NO. ISIM2-235A (SHEET 1) REV. 1

DB 01-04-92 DFN= 1:\ISIM-2\IM235A1.DGN

14 24X44 E SIZE

D-44