RC=CEL:155.100|FORMATS.CEL AC=E7749

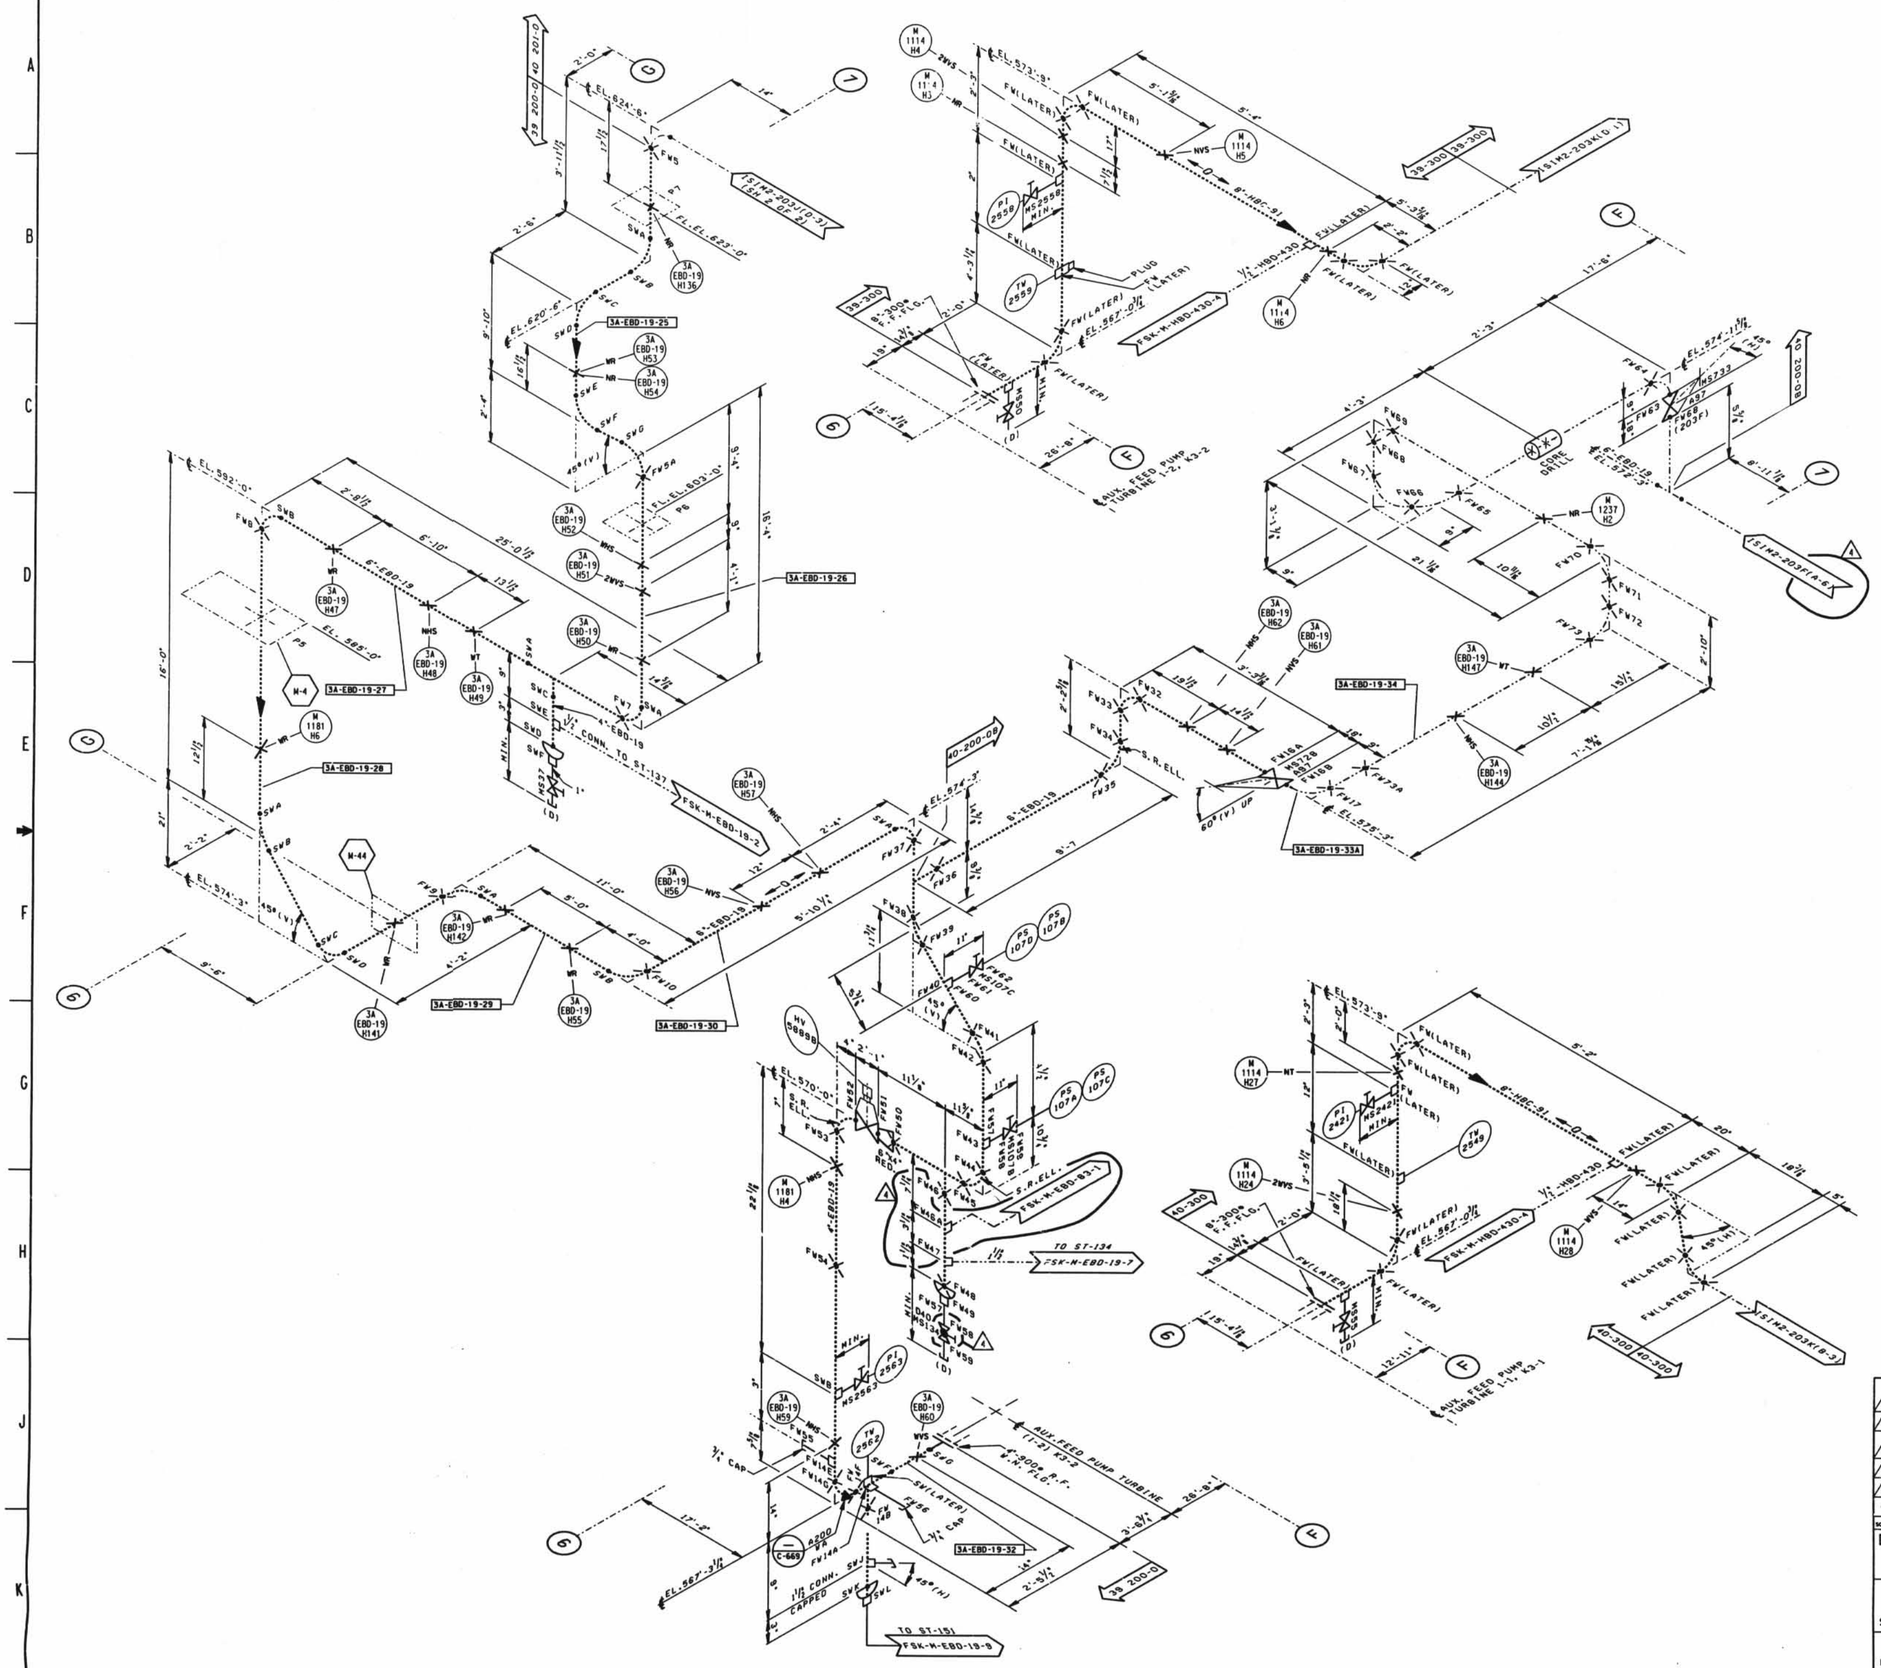

LEGEND

- ASME SECTION XI CLASS 1 PIPING
- ASME SECTION XI CLASS 2 PIPING
- ASME SECTION XI CLASS 3 PIPING
- NON-ISI NUCLEAR CLASS AND HSC CLASS
- PRESSURE BOUNDARY EXTENSION
- REFERENCE & CONTINUITY
- D — D — HVAC DUCT

A	ANCHOR
CS	CONSTANT SPRING HANGER
VS	VARIABLE SPRING HANGER
HS	HYDRAULIC SNUBBER
MS	MECHANICAL SNUBBER
N	NON-WELDED SUPPORT ATTACHMENT
W	WELDED INTEGRAL SUPPORT ATTACHMENT
R	RIGID SUPPORT
T	SWAY STRUT
SW	SHOP WELD
FW	FIELD WELD
LW	LONGITUDINAL WELD
WOL	WELDOLET

ISI ITEM NUMBER DESIGNATION USED IN THE FIRST 10 YEAR INSERVICE INSPECTION INTERVAL.

NOTES:

1. MULTIPLE SWAY STRUTS, SPRING SUPPORTS OR SNUBBERS IN A SINGLE PIPING SUPPORT ARE SHOWN BY A NUMBER BEFORE THE SUPPORT TYPE. (EXAMPLE: 2HHS - TWO HYDRAULIC TYPE SNUBBERS THAT ARE NOT WELDED INTEGRAL TO THE PIPE).
2. THERE ARE NO SPOOL NUMBERS FOR LINE 8"-HBC-91.
3. SUPPORT NUMBERS AND LOCATIONS FOR THIS DRAWING ARE DERIVED FROM DRAWINGS 12501-HL-203H (SUPPLY TO AFPT 1-2) AND 12501-HL-1114, SHEET 1 (AFPT EXHAUST).
4. THE SUPPORTS ON THE MAINSTEAM AUX. FEED PUMP SUPPLY LINE 4"-EBD-19, 6"-EBD-19, AND 8"-EBD-91 ARE WITHIN THE ISI EXAMINATION BOUNDARY. THE PIPING WELDS IN THESE LINES ARE SHOWN FOR REFERENCE PURPOSES ONLY. THESE WELDS MAY NOT BE REPRESENTED IN THE ACTUAL AS-BUILT CONDITION.
5. PIPING SYSTEMS ON THIS DRAWING WHICH ARE OUTSIDE OF THE ISI BOUNDARY, ARE SHOWN FOR REFERENCE AND CONTINUITY PURPOSES ONLY. THE CONFIGURATION SHOWN MAY NOT REPRESENT THE ACTUAL AS-BUILT CONDITION.

REFERENCE DRAWINGS:

ISI02-003C MAIN STEAM AND REHEAT STEAM SYSTEM SHEET 3

GENERAL NOTE:

DIMENSIONS SHOWN ON THIS DRAWING ARE TO BE USED FOR APPROXIMATE LOCATION ONLY. USE DESIGN DRAWINGS FOR DIMENSIONAL VERIFICATION.

NO.	DATE	REVISIONS	BY	CH'K	ENGR.	ENGR. SUPV.	ENG. MGR.
4	5/12/98	INC DCN ISIM2-203H-8 PER MOD 95-0060 SUP. 0 & DEN. UPDATE ZONE CORD. FOR CONT. TO ISIM2-203F (ZONE D-12)	SBW	DVK			
3	02/23/96	INC DCN ISIM2-203H-6 PER DCR 94-2486	*INITIALS ON FILE*				
2	5/11/92	INC D 5 ISIM2-203H-5 FOR MOD 92-002, SUP.0 AND ISIM2-203H-4 FOR MOD 87-1273 SUP. 0	*INITIALS ON FILE*				
1	8/21/92	INC DCN ISIM2-203H-2 FOR DCR 91-0011	*INITIALS ON FILE*				
0	9/1/90	ISSUED FOR SECOND 10 YEAR ISI PROGRAM	*INITIALS ON FILE*				

SCALE N.T.S. DESIGNED DRAWN CB DATE

DAVIS-BESSE NUCLEAR POWER STATION
UNIT NO. 1
THE TOLEDO EDISON COMPANY

INSERVICE INSPECTION ISOMETRIC
MAIN STEAM SYSTEM
SUPPLY TO AUX. FEED PUMP TURBINE NO.1-2 & EXHAUST

DRAWING NO. ISIM2-203H REV. 4

SIZE D

08-17-18-96 DFN=f:\ISIM\2IN203H.DGN LEVELS 1234567890123456789012345678901234567890123456789012345678901234567890

D-99

I CERTIFY THAT THE IMAGE CONTAINED ON THIS FRAME WAS MADE IN THE NORMAL COURSE OF BUSINESS AND THAT IT IS AN ACCURATE REPRODUCTION OF THE RECORD(S) SUBMITTED TO RICOH'S RECORDS MANAGEMENT.
DATE 8.14.96 OPERATOR Bert, Willie BOX