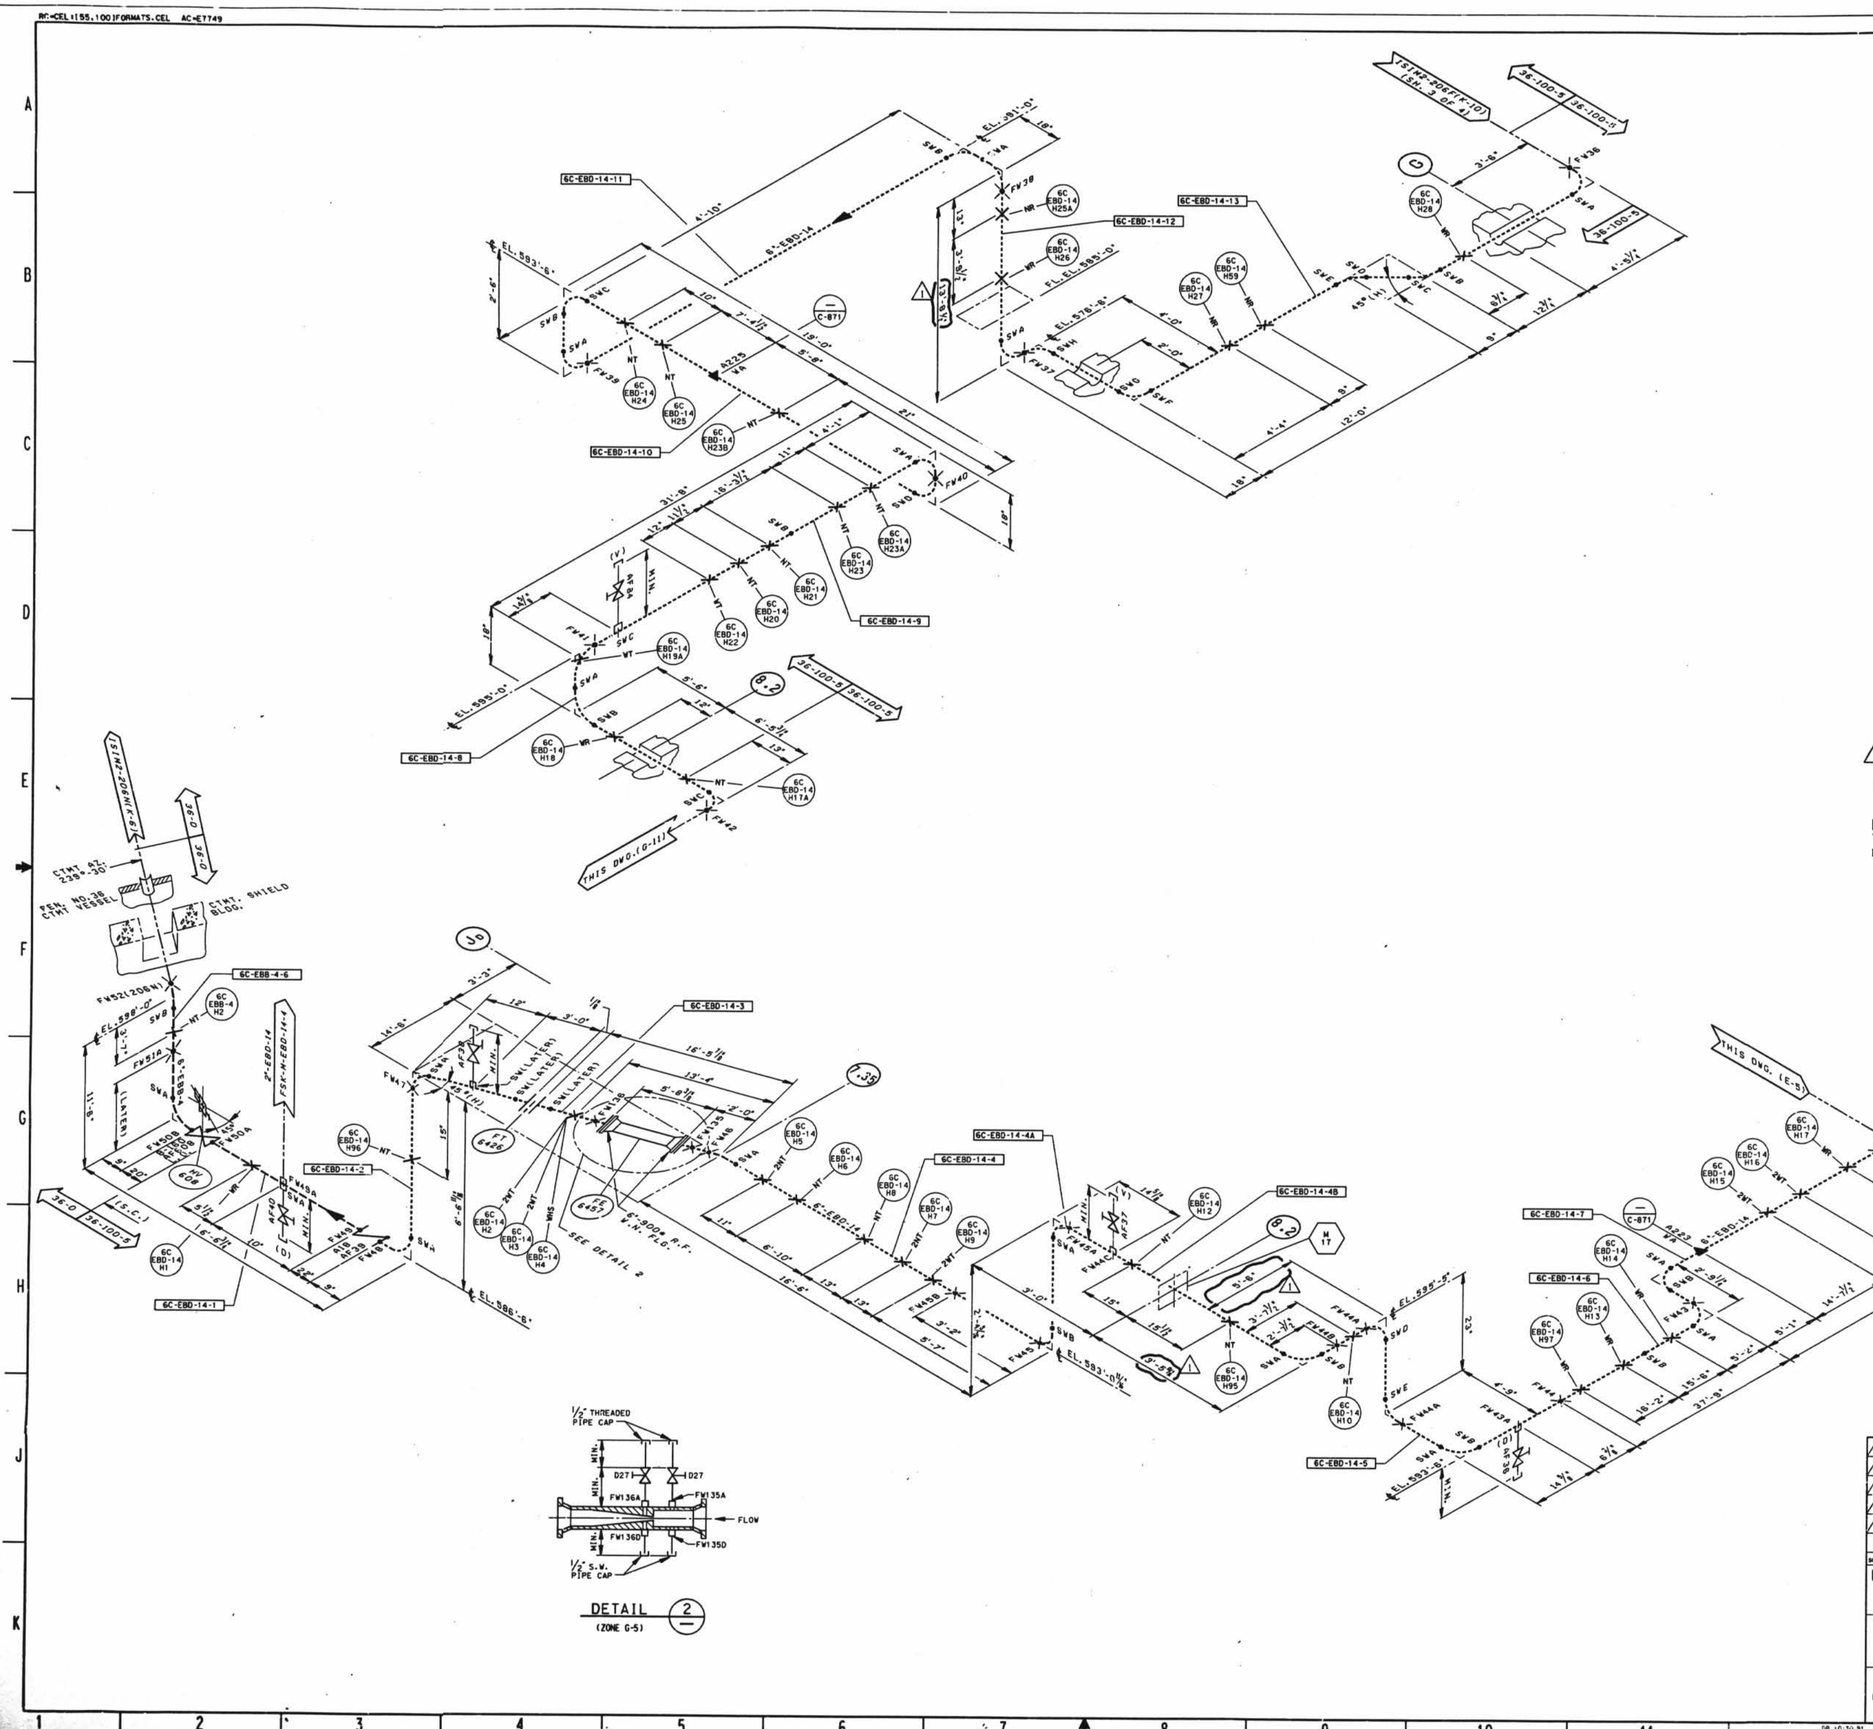

LEGEND

- ASME SECTION XI CLASS 1 PIPING
- ASME SECTION XI CLASS 2 PIPING
- ASME SECTION XI CLASS 3 PIPING
- NON-ISI NUCLEAR CLASS AND HSC CLASS
- PRESSURE BOUNDARY EXTENSION
- REFERENCE & CONTINUITY
- —D—D— HVAC DUCT
- A ANCHOR
- CS CONSTANT SPRING HANGER
- VS VARIABLE SPRING HANGER
- HS HYDRAULIC SNUBBER
- MS MECHANICAL SNUBBER
- N NON-WELDED SUPPORT ATTACHMENT
- W WELDED INTEGRAL SUPPORT ATTACHMENT
- R RIGID SUPPORT
- T SWAY STRUT
- SW SHOP WELD
- FW FIELD WELD
- LW LONGITUDINAL WELD
- WOL WELDOLET
- ISI ITEM NUMBER DESIGNATION USED IN THE FIRST 10 YEAR INSERVICE INSPECTION INTERVAL.

NOTES:

1. MULTIPLE SWAY STRUTS, SPRING SUPPORTS OR SNUBBERS IN A SINGLE PIPING SUPPORT ARE SHOWN BY A NUMBER BEFORE THE SUPPORT TYPE. (EXAMPLE: 2NHS - TWO HYDRAULIC TYPE SNUBBERS THAT ARE NOT WELDED INTEGRAL TO THE PIPE).
2. THE SUPPORTS ON THE AUXILIARY FEED PUMP DISCHARGE LINE 6"-EBD-14 ARE WITHIN THE ISI EXAMINATION BOUNDARY. THE PIPING WELDS IN THIS LINE ARE SHOWN FOR REFERENCE PURPOSES ONLY. THESE WELDS MAY NOT BE REPRESENTED IN THE ACTUAL AS-BUILT CONDITION.

GENERAL NOTE

DIMENSIONS SHOWN ON THIS DRAWING ARE TO BE USED FOR APPROXIMATE LOCATION ONLY. USE DESIGN DRAWINGS FOR DIMENSIONAL VERIFICATION.

REFERENCE DRAWINGS:

ISI02-007B STEAM GENERATOR SECONDARY SYSTEM

NO.	DATE	REVISIONS	BY	CH'K	ENGR.	ENGR. SUPV.	ENG. MGR.
1	4/14/94	INC. DCN ISIM2-20GF-2 FOR DCR 91-0011	JFS				
0	9/17/90	ISSUED FOR SECOND 10 YEAR ISI PROGRAM	DJR	TRN RJC	TWB	MCP	ECC

SCALE N.T.S. DESIGNED DRAWN CB DATE

DAVIS-BESSE NUCLEAR POWER STATION
UNIT NO. 1
THE TOLEDO EDISON COMPANY

Q

INSERVICE INSPECTION ISOMETRIC
AUXILIARY FEEDWATER SYSTEM
AUX. FEED PUMP DISCH. TO STEAM GENERATORS

DRAWING NO. ISIM2-206F (SHEET 2) REV. 1

D-104

DB 10-30-91 DFN= 1/ISIM/2IM2D6F2 .DCN

14 34X44 E SIZE

I CERTIFY THAT THE IMAGE CONTAINED ON THIS FRAME HAS BEEN IN THE NORMAL AND REGULAR COURSE OF BUSINESS, ON THE DATE STATED BELOW AND THAT IT IS AN ACCURATE REPRODUCTION OF THE RECORD(S) SUBMITTED TO NUCLEAR RECORDS MANAGEMENT.

DATE 12-12-91 OPERATOR [signature] 30X