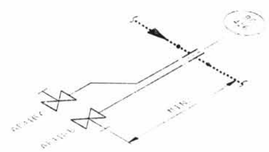

DETAIL 1
(ZONE F-3)

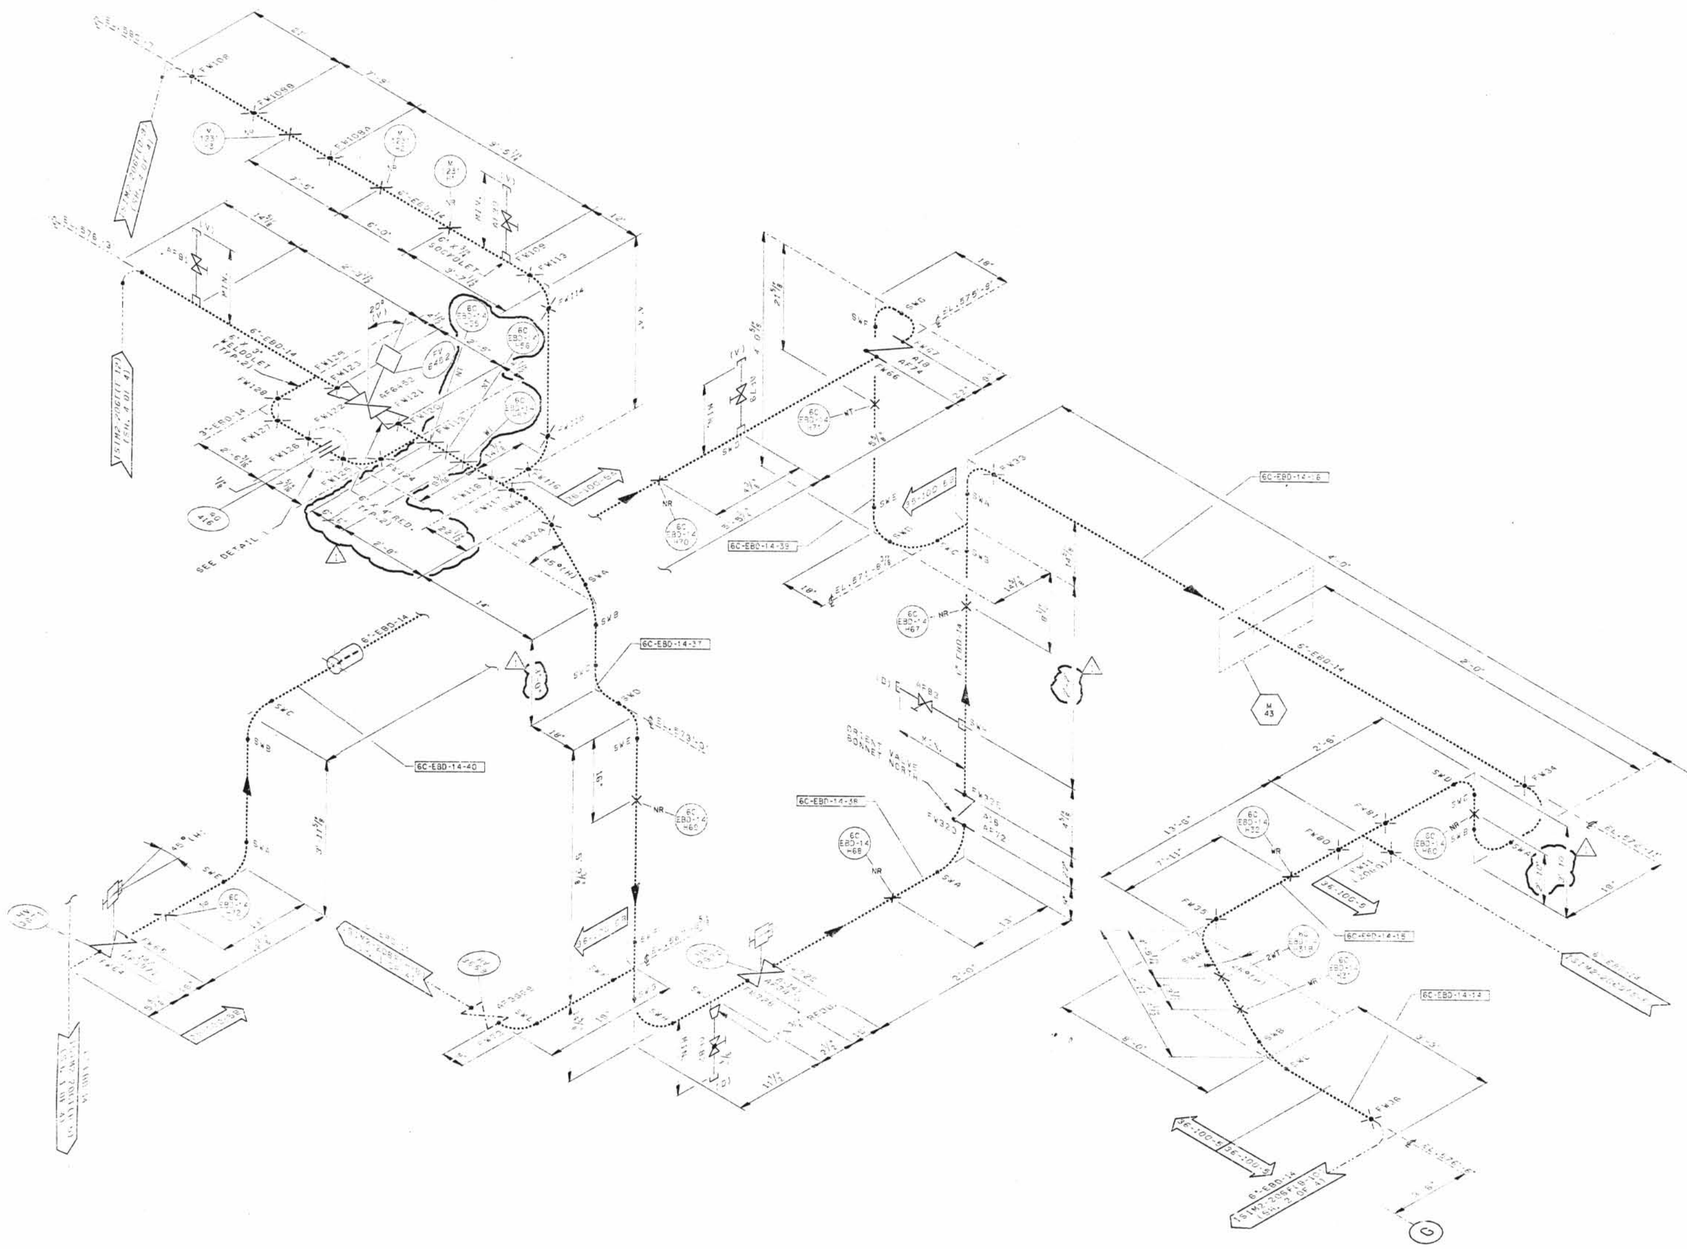

LEGEND

- ASME SECTION XI CLASS 1 PIPING
- ASME SECTION XI CLASS 2 PIPING
- ASME SECTION XI CLASS 3 PIPING
- NON-ISI NUCLEAR CLASS AND HSC CLASS
- PRESSURE BOUNDARY EXTENSION
- REFERENCE & CONTINUITY
- D—D HVAC DUCT
- A ANCHOR
- CS CONSTANT SPRING HANGER
- VS VARIABLE SPRING HANGER
- HS HYDRAULIC SNUBBER
- MS MECHANICAL SNUBBER
- N NON-WELDED SUPPORT ATTACHMENT
- W WELDED INTEGRAL SUPPORT ATTACHMENT
- R RIGID SUPPORT
- T SWAY STRUT
- SW SHOP WELD
- FW FIELD WELD
- LW LONGITUDINAL WELD
- WOL WELDOLET
- ISI ITEM NUMBER DESIGNATION USED IN THE FIRST 10 YEAR INSERVICE INSPECTION INTERVAL.

NOTES:

1. MULTIPLE SWAY STRUTS, SPRING SUPPORTS OR SNUBBERS IN A SINGLE PIPING SUPPORT ARE SHOWN BY A NUMBER BEFORE THE SUPPORT TYPE. (EXAMPLE: 2SW6 - TWO HYDRAULIC SNUBBERS THAT ARE NOT WELDED INTEGRAL TO THE PIPE).
2. THE SUPPORTS ON THE AUXILIARY FEED PUMP DISCHARGE LINE 6"-EBD-14 ARE WITHIN THE ISI EXAMINATION BOUNDARY. THE PIPING WELDS IN THIS LINE ARE SHOWN FOR REFERENCE PURPOSES ONLY. THESE WELDS MAY NOT BE REPRESENTED IN THE ACTUAL AS-BUILT CONDITION.
3. DIMENSIONS SHOWN ON THIS DRAWING ARE TO BE USED FOR APPROXIMATE LOCATION ONLY. USE DESIGN DRAWINGS FOR DIMENSIONAL VERIFICATION.

REFERENCE DRAWINGS:

ISID2-0060 AUXILIARY FEEDWATER SYSTEM
ISID2-0078 STEAM GENERATOR SECONDARY SYSTEM

1		INCORPORATED ISIM2-CONT-3 (FOR DCR [illegible]) & GENERAL UPDATE (ADD SUPPORTS TO HSS-[illegible] & MOD ZONE F-[illegible] SUPPORT DIM. VERIFICATION & [illegible] COMMENT
0	[illegible]	ISSUED FOR SECOND 10 YEAR [illegible] PROGRAM
No.	DATE	REVISION

DAVIS-BESSE NUCLEAR POWER STATION
UNIT NO. 1

INSERVICE INSPECTION ISOMETRIC
AUXILIARY FEEDWATER SYSTEM
AUX. FEED PUMP DISCH. TO STEAM GENERATORS

ISIM2-206F
SHEET 3

D-105

I CERTIFY THAT THE IMAGE CONTAINED ON THIS FRAME WAS MADE IN THE NORMAL AND REGULAR COURSE OF BUSINESS, ON THE DATE STATED BELOW AND THAT IT IS AN ACCURATE REPRODUCTION OF THE RECORD SUBMITTED TO TOLEDO EDISON COMPANY.
2-5-92 Dwight Wall 30X