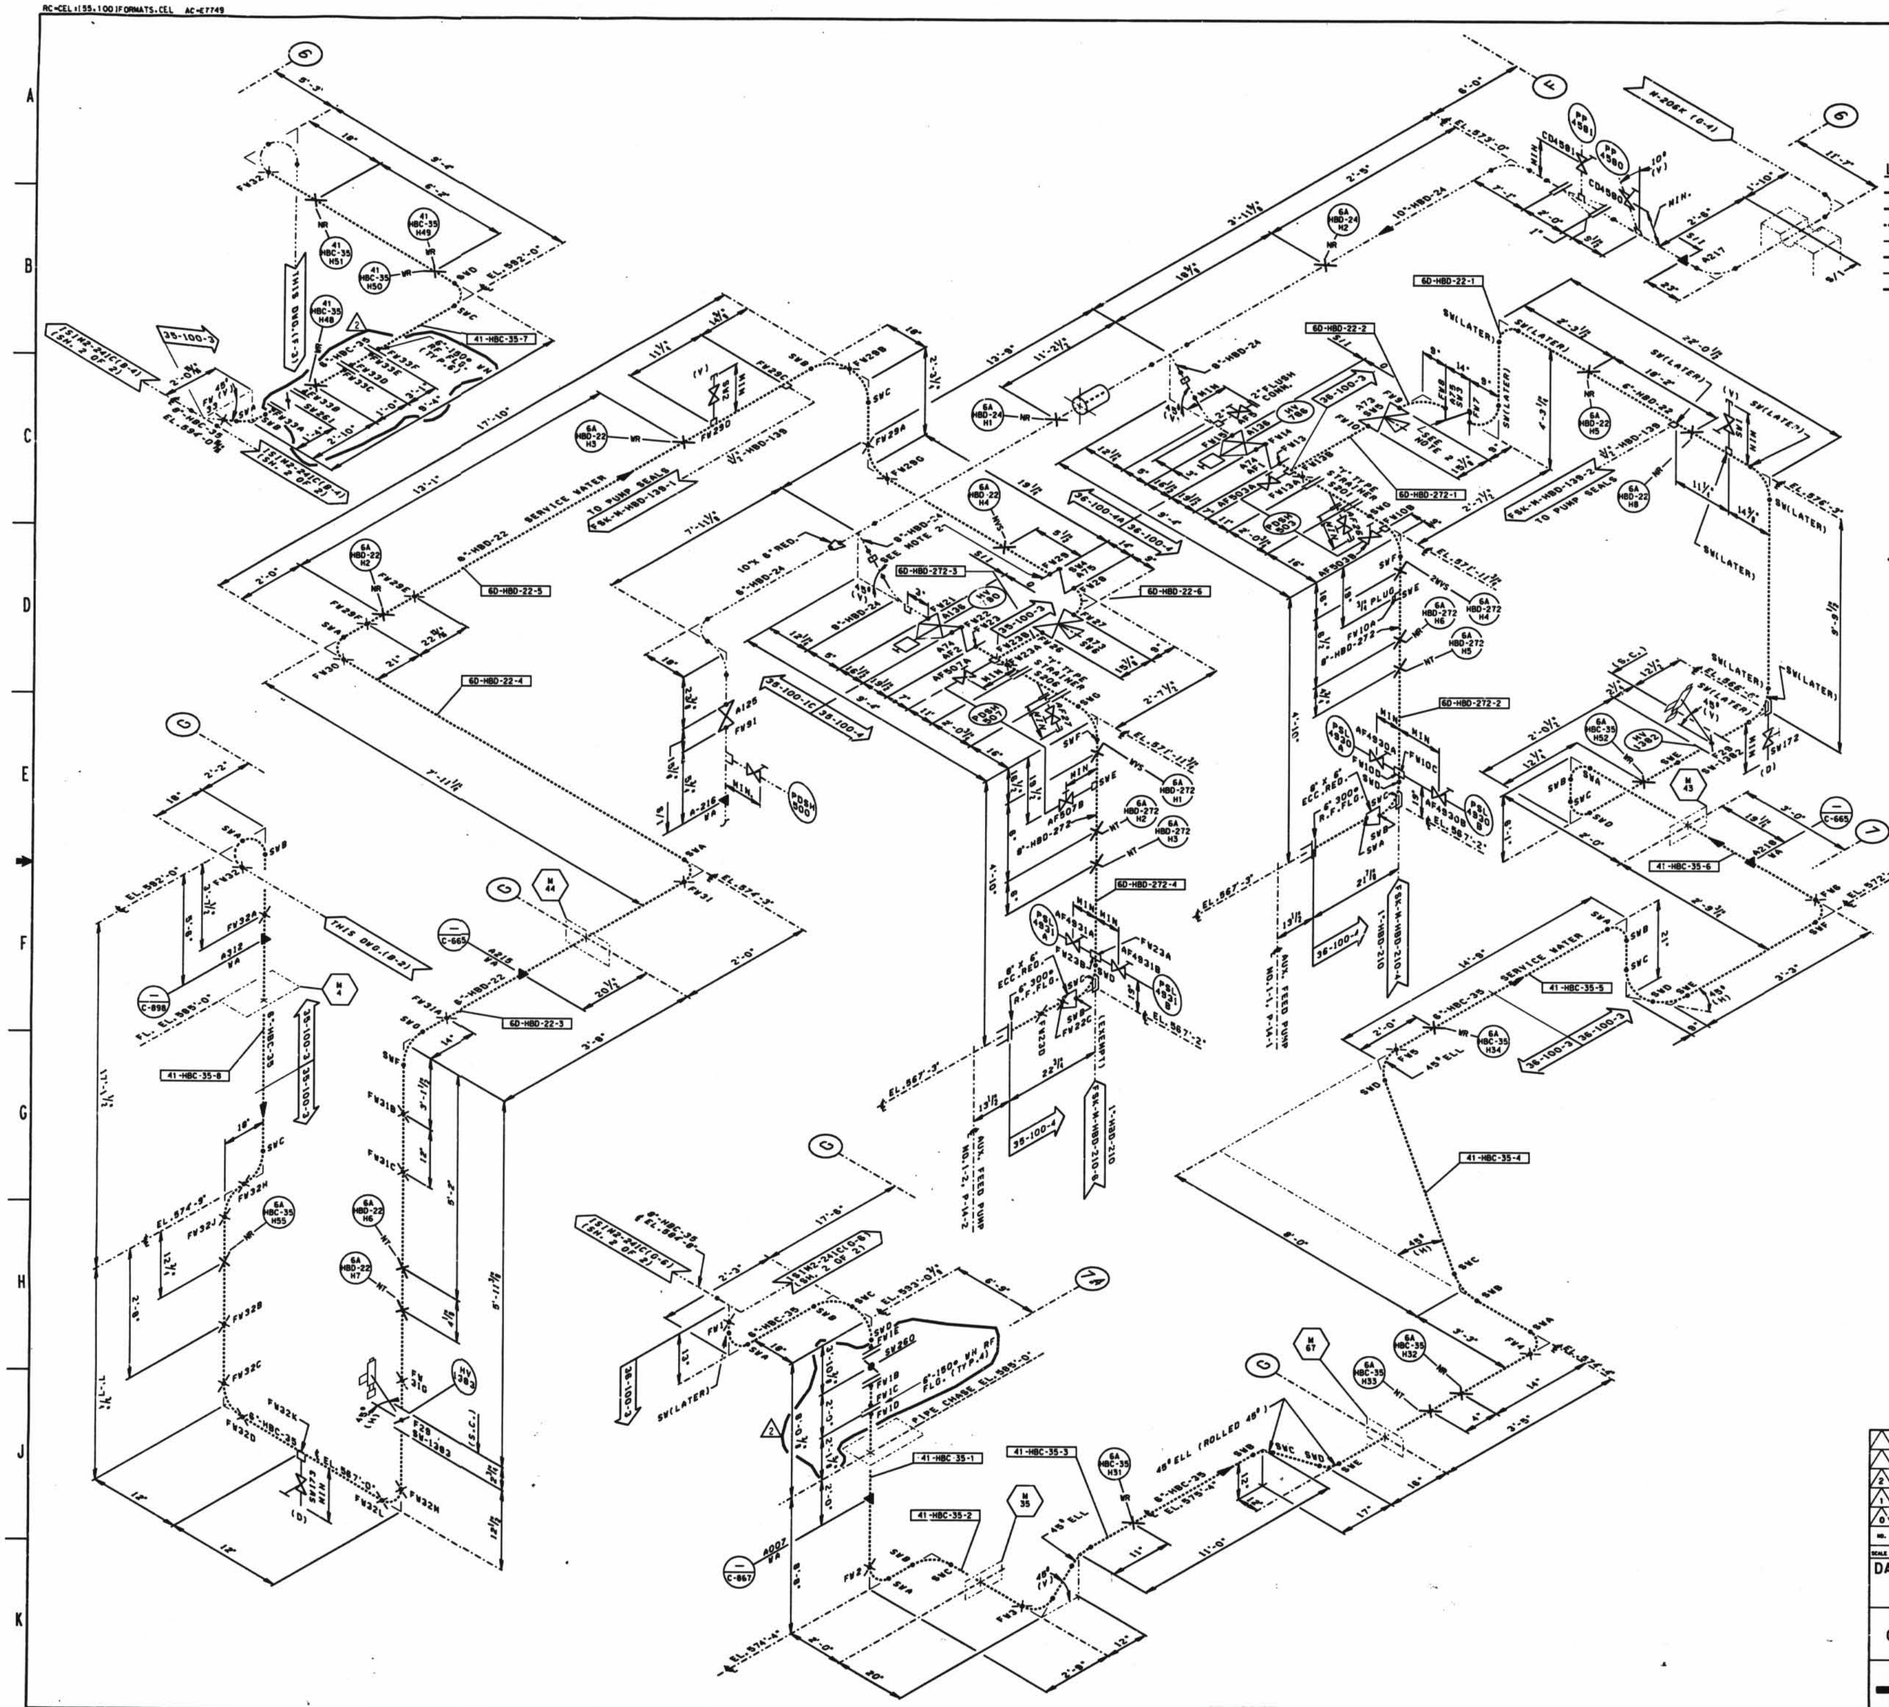

LEGEND

- ASME SECTION XI CLASS 1 PIPING
- ASME SECTION XI CLASS 2 PIPING
- ASME SECTION XI CLASS 3 PIPING
- NON-ISI NUCLEAR CLASS AND HSC CLASS
- PRESSURE BOUNDARY EXTENSION
- REFERENCE & CONTINUITY
- HVAC DUCT

A	ANCHOR
CS	CONSTANT SPRING HANGER
VS	VARIABLE SPRING HANGER
HS	HYDRAULIC SNUBBER
MS	MECHANICAL SNUBBER
N	NON-WELDED SUPPORT ATTACHMENT
W	WELDED INTEGRAL SUPPORT ATTACHMENT
R	RIGID SUPPORT
T	SWAY STRUT
SW	SHOP WELD
FW	FIELD WELD
LW	LONGITUDINAL WELD
WOL	WELDOLET
⇦	ISI ITEM NUMBER DESIGNATION USED IN THE FIRST 10 YEAR INSERVICE INSPECTION INTERVAL.

NOTES:

1. MULTIPLE SWAY STRUTS, SPRING SUPPORTS OR SNUBBERS IN A SINGLE PIPING SUPPORT ARE SHOWN BY A NUMBER BEFORE THE SUPPORT TYPE. (EXAMPLE: 2HHS - TWO HYDRAULIC TYPE SNUBBERS THAT ARE NOT WELDED INTEGRAL TO THE PIPE).
2. VALVE INTERNALS REMOVED FROM VALVES A75 (SW3 AND SW4).V SEE FCR 80-252 REV.A SUPP.1.
3. THE SUPPORTS ON THE AUXILIARY & STARTUP FEED PUMP SUCTION LINES 6"-HBC-35, 6"-HBD-22, & 8"-HBD-272 ARE WITHIN THE ISI EXAMINATION BOUNDARY. THE PIPING WELDS IN THESE LINES ARE SHOWN FOR REFERENCE PURPOSES ONLY. THESE WELDS MAY NOT BE REPRESENTED IN THE ACTUAL AS-BUILT CONDITION.
4. PIPING SYSTEMS ON THIS DRAWING WHICH ARE OUTSIDE OF THE ISI BOUNDARY, ARE SHOWN FOR REFERENCE & CONTINUITY PURPOSES ONLY. THE CONFIGURATION SHOWN MAY NOT REPRESENT THE ACTUAL AS-BUILT CONDITION.
5. DIMENSIONS SHOWN ON THIS DRAWING ARE TO BE USED FOR APPROXIMATE LOCATION ONLY. USE DESIGN DRAWINGS FOR DIMENSIONAL VERIFICATION.

REFERENCE DRAWINGS:

ISID2-006D AUXILIARY FEEDWATER SYSTEM
ISID2-041C SERVICE WATER SYSTEM FOR CONTAINMENT AIR COOLERS

NO.	DATE	REVISIONS	BY	CK'D	ENGR.	ENGR. SUPV.	ENG. MGR.
2	3/30/92	INC DCN ISIM2-206G-1 PER MOD 90-0059 SUP.0	DVK				
1	12-16-91	INC DCN ISIM2-206G-2 FOR DCR 91-0011	"INITIALS ON FILE"				
0	9-17-90	ISSUED FOR SECOND 10 YEAR ISI PROGRAM	"INITIALS ON FILE"				

SCALE N.T.S. DESIGNED DRAWN CB DATE

DAVIS-BESSE NUCLEAR POWER STATION
UNIT NO. 1
THE TOLEDO EDISON COMPANY

Q

INSERVICE INSPECTION ISOMETRIC
CONDENSATE & SERVICE WATER SYSTEMS
AUX. & START-UP FEED PUMPS SUCTION & RECIRC.

DRAWING NO. ISIM2-206G REV. 2

D-108