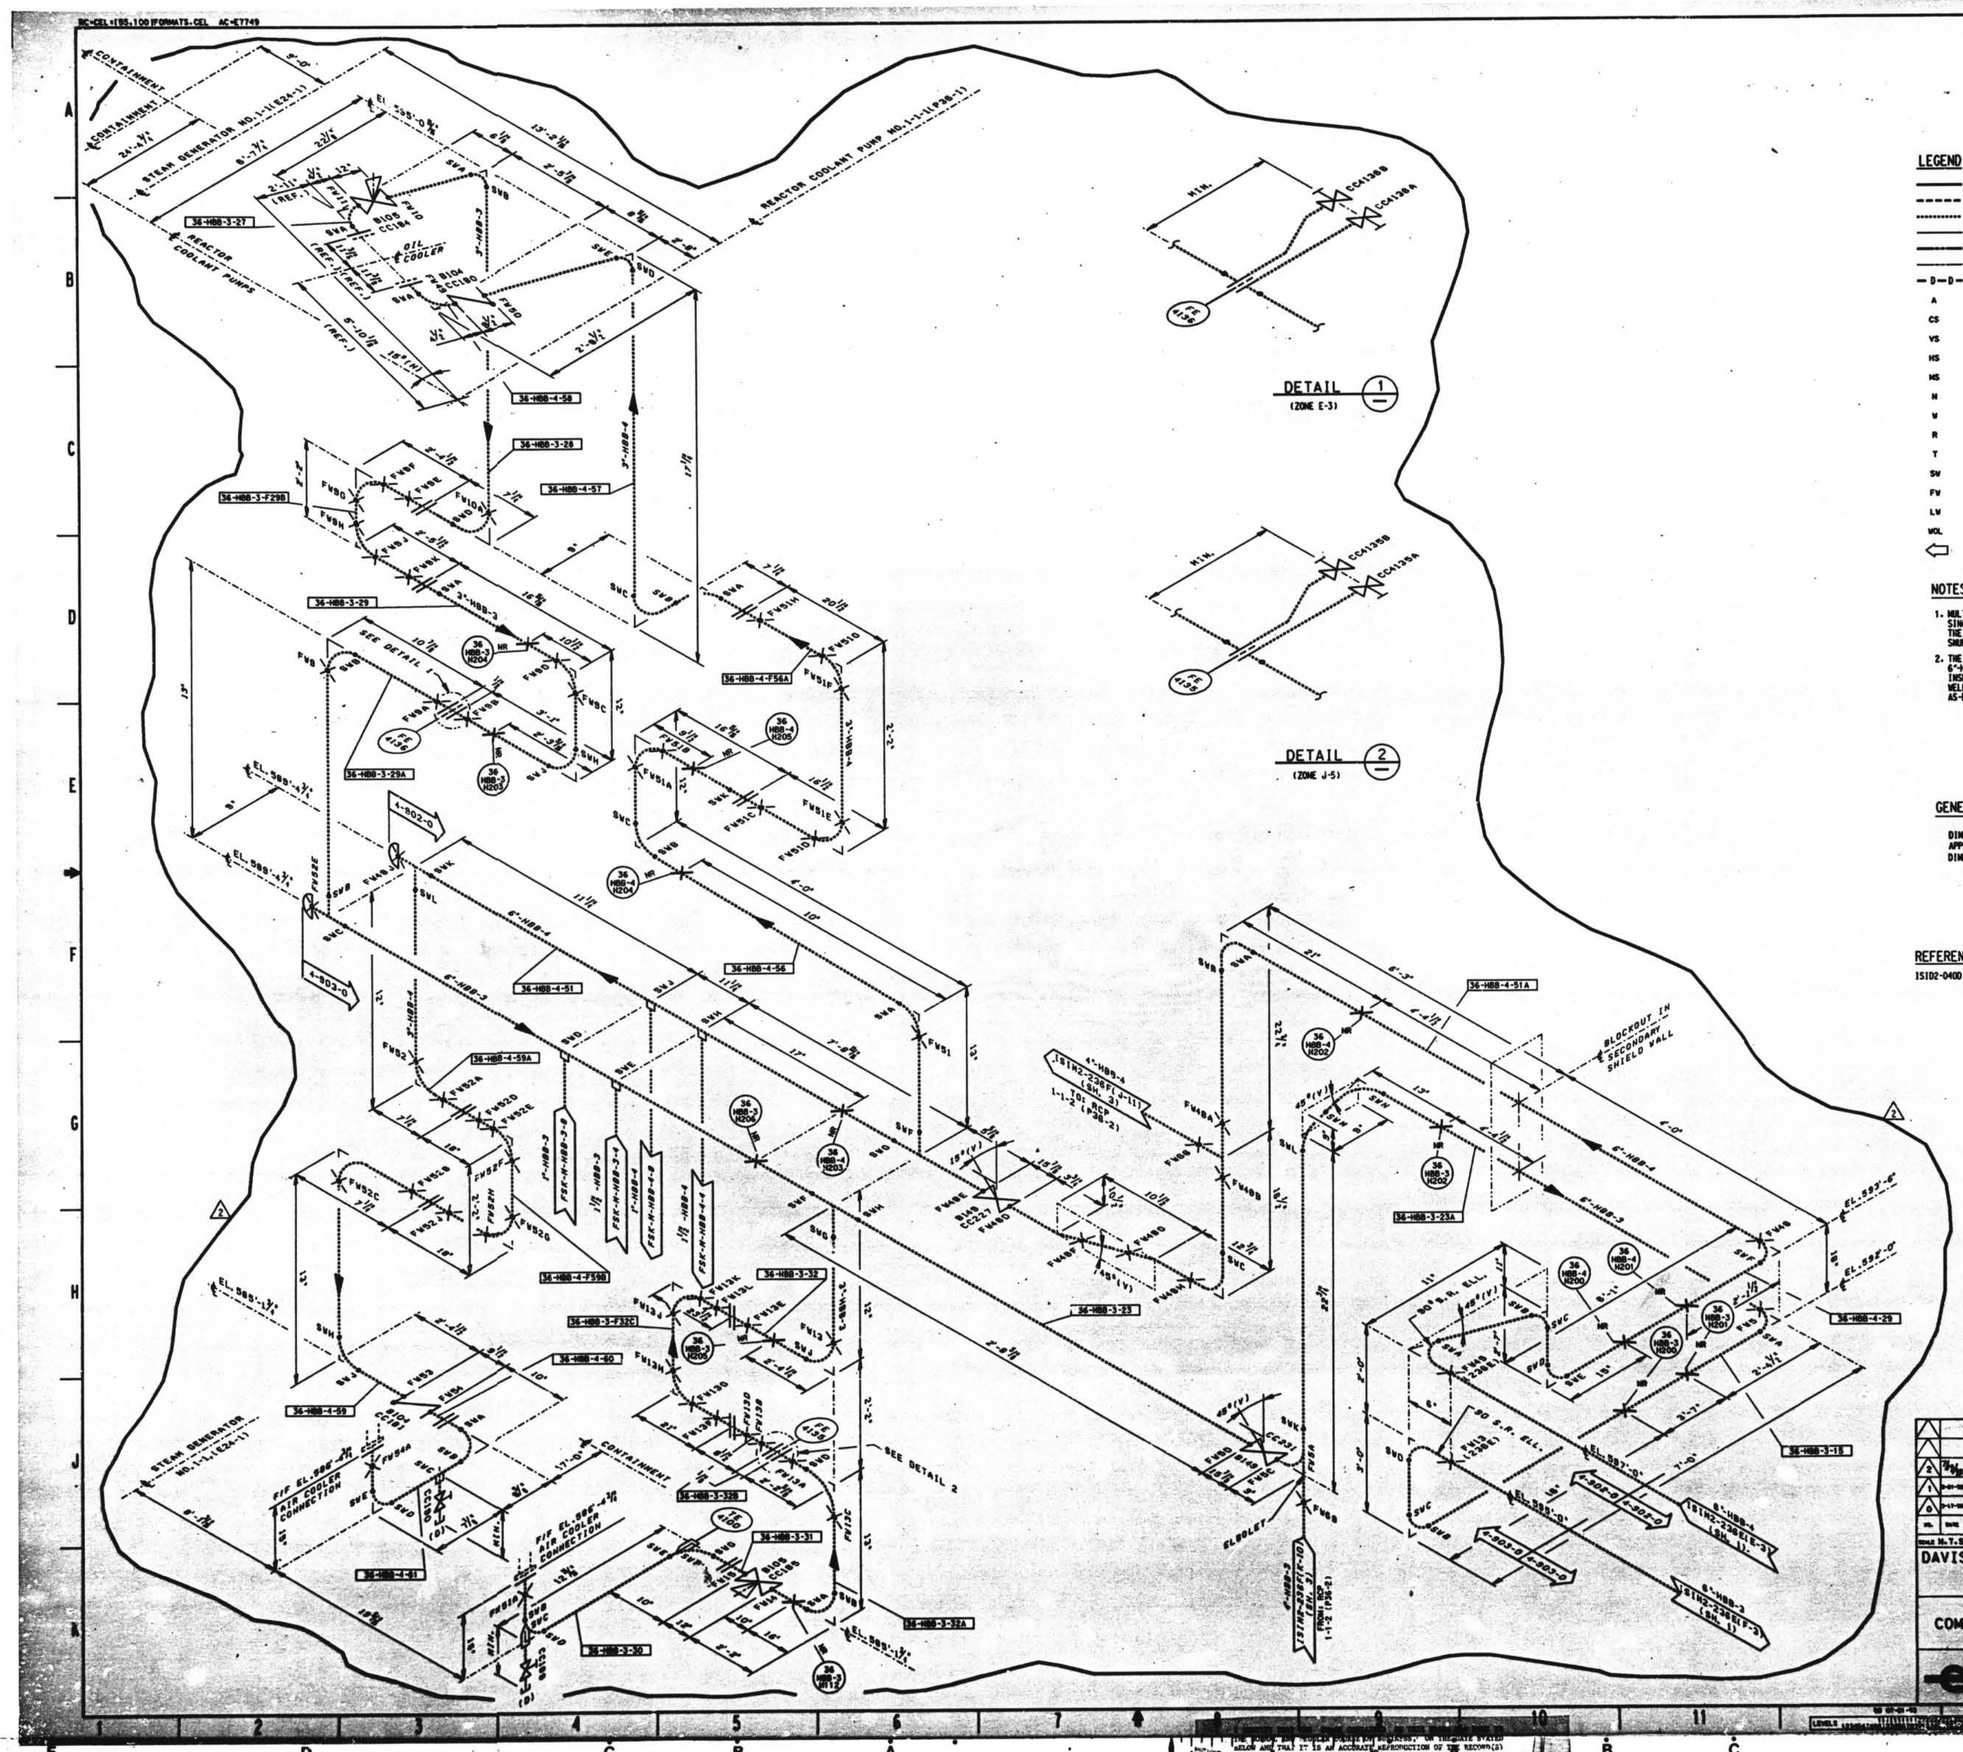

LEGEND

- ASME SECTION XI CLASS 1 PIPING
- ASME SECTION XI CLASS 2 PIPING
- ASME SECTION XI CLASS 3 PIPING
- NON-ISI NUCLEAR CLASS AND HSC CLASS
- PRESSURE BOUNDARY EXTENSION
- REFERENCE & CONTINUITY
- D—D HVAC DUCT
- A ANCHOR
- CS CONSTANT SPRING HANGER
- VS VARIABLE SPRING HANGER
- HS HYDRAULIC SNUBBER
- MS MECHANICAL SNUBBER
- N NON-WELDED SUPPORT ATTACHMENT
- W WELDED INTEGRAL SUPPORT ATTACHMENT
- R RIGID SUPPORT
- T SWAY STRUT
- SW SHOP WELD
- FW FIELD WELD
- LW LONGITUDINAL WELD
- WOL WELDOLET
- ISI ITEM NUMBER DESIGNATION USED IN THE FIRST 10 YEAR INSERVICE INSPECTION INTERVAL.

NOTES:

1. MULTIPLE SWAY STRUTS, SPRING SUPPORTS OR SNUBBERS IN A SINGLE PIPING SUPPORT ARE SHOWN BY A NUMBER BEFORE THE SUPPORT TYPE. (EXAMPLE: 2MHS - TWO HYDRAULIC TYPE SNUBBERS THAT ARE NOT WELDED INTEGRAL TO THE PIPE).
2. THE COMPONENT COOLING WATER LINE 6"-HBB-3, 3"-HBB-3, 6"-HBB-4, & 3"-HBB-4 WELDS AND SUPPORTS ARE EXEMPT FROM INSERVICE EXAMINATION REQUIREMENTS PER IWD 1220. THE WELDS AND SUPPORTS SHOWN MAY NOT REPRESENT THE ACTUAL AS-BUILT CONDITION.

GENERAL NOTE:

DIMENSIONS SHOWN ON THIS DRAWING ARE TO BE USED FOR APPROXIMATE LOCATION ONLY. USE DESIGN DRAWINGS FOR DIMENSIONAL VERIFICATION.

REFERENCE DRAWINGS:

1S1D2-040D REACTOR COOLANT PUMP AND MOTOR.

2	7/29/93	INC. DCN 1SIM2-236F-13 FOR RFA 93-0254	JOR	JJM	- -
1	2-20-90	INC. DCN'S 1SIM2-236F-7 & 8 FOR DCR 91-0011	"SUITI	ALS ON FILE"	
0	2-13-90	ISSUED FOR SECOND 10 YEAR ISI PROGRAM	"SUITI	ALS ON FILE"	

SCALE N.T.S. DESIGNED DRAWN CB DATE

DAVIS-BESSE NUCLEAR POWER STATION
UNIT NO. 1

THE TOLEDO EDISON COMPANY

INSERVICE INSPECTION ISOMETRIC
COMPONENT COOLING WATER SYSTEM
CONTAINMENT BUILDING (P36-1)

DRAWING NO. 1SIM2-236F (SHEET 4) REV. 2

D-65

THE BOARD HAS "REVIEWED THE ENGINEERING DRAWINGS" OR THE DATE STATED BELOW AND THAT IT IS AN ACCURATE REPRODUCTION OF THE RECORD(S) SUBMITTED TO NUCLEAR RECORDS MANAGEMENT.
DATE 7-6-95 OPERATOR 30X