File: C:\ENGINEERING DWG FILE\2001\0104_11E(2) AS-BUILT\0104-01.DWG Last edited: 02/21/01 @ 08:53 a.m. by: klutz Xrefs: none

KEY:

- LIMIT OF WASTE PLACEMENT
- LIMIT OF CONSTRUCTED LINER
- BERM BOUNDARY
- LIMIT OF CONSTRUCTED COVER
- EMBANKMENT DESIGN AND LIMIT OF WASTE

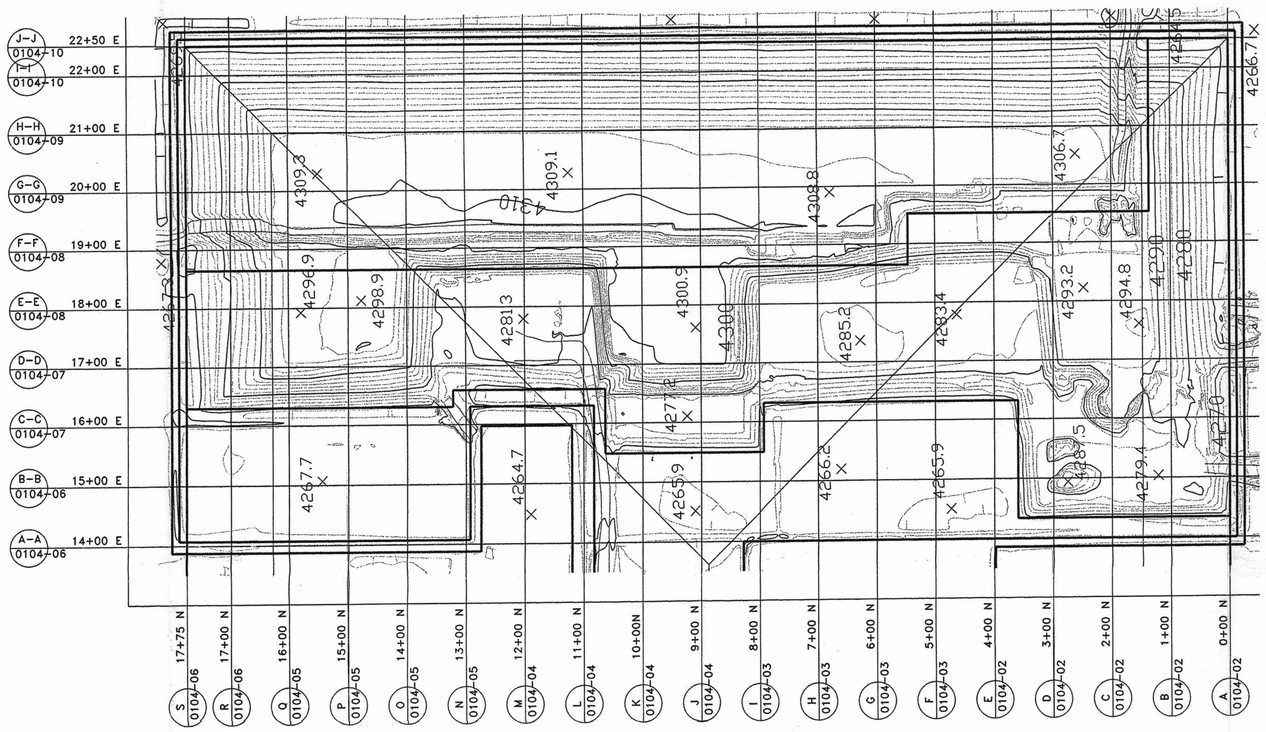

PLAN VIEW

SCALE: 1" = 100'

NOTES:

1. CONTOUR MAPS ARE BASED ON A SITE SURVEY PERFORMED BY AERO-GRAPHICS, INC. ON DECEMBER 18, 2000. PHOTO DATE: 12/18/00 CERTIFIED BY A UTAH LICENSED LAND SURVEYOR
2. CONTOUR INFORMATION SHOWN ON THIS DRAWING WAS TAKEN FROM DIGITAL MAPPING PERFORMED BY AERO-GRAPHICS, INC. PHOTO DATE: 12/18/00
3. WASTE IS ON CONSTRUCTED LINER, INSIDE THE RUN-OFF BERM PERIMETER.
4. EMBANKMENT COORDINATE SYSTEM HAS (0E, 0N) LOCATED AT THE SOUTHWEST CORNER OF WASTE.
5. EMBANKMENT COORDINATE (0E, 0N) IS LOCATED AT (N 859,576 E 1,549,937) IN THE SITE COORDINATE SYSTEM

D-1

LICENSED PROFESSIONAL ENGINEER #266908 DAVID RUSSELL WINTERS STATE OF UTAH

Dave Winters 2/21/01

DATE	INIT.	DESCRIPTION OF CHANGE

ENVIROCARE OF UTAH, INC. THE SAFE ALTERNATIVE

DRAWN BY K. LUTZ	11e(2) DISPOSAL CELL	SCALE AS NOTED	DATE 02/15/01
CHECKED BY —	ANNUAL AS-BUILT DRAWING		
APPROVED BY D. WINTERS	PLAN VIEW CLIVE, UTAH	DRAWING NO. 0104-01	REV.