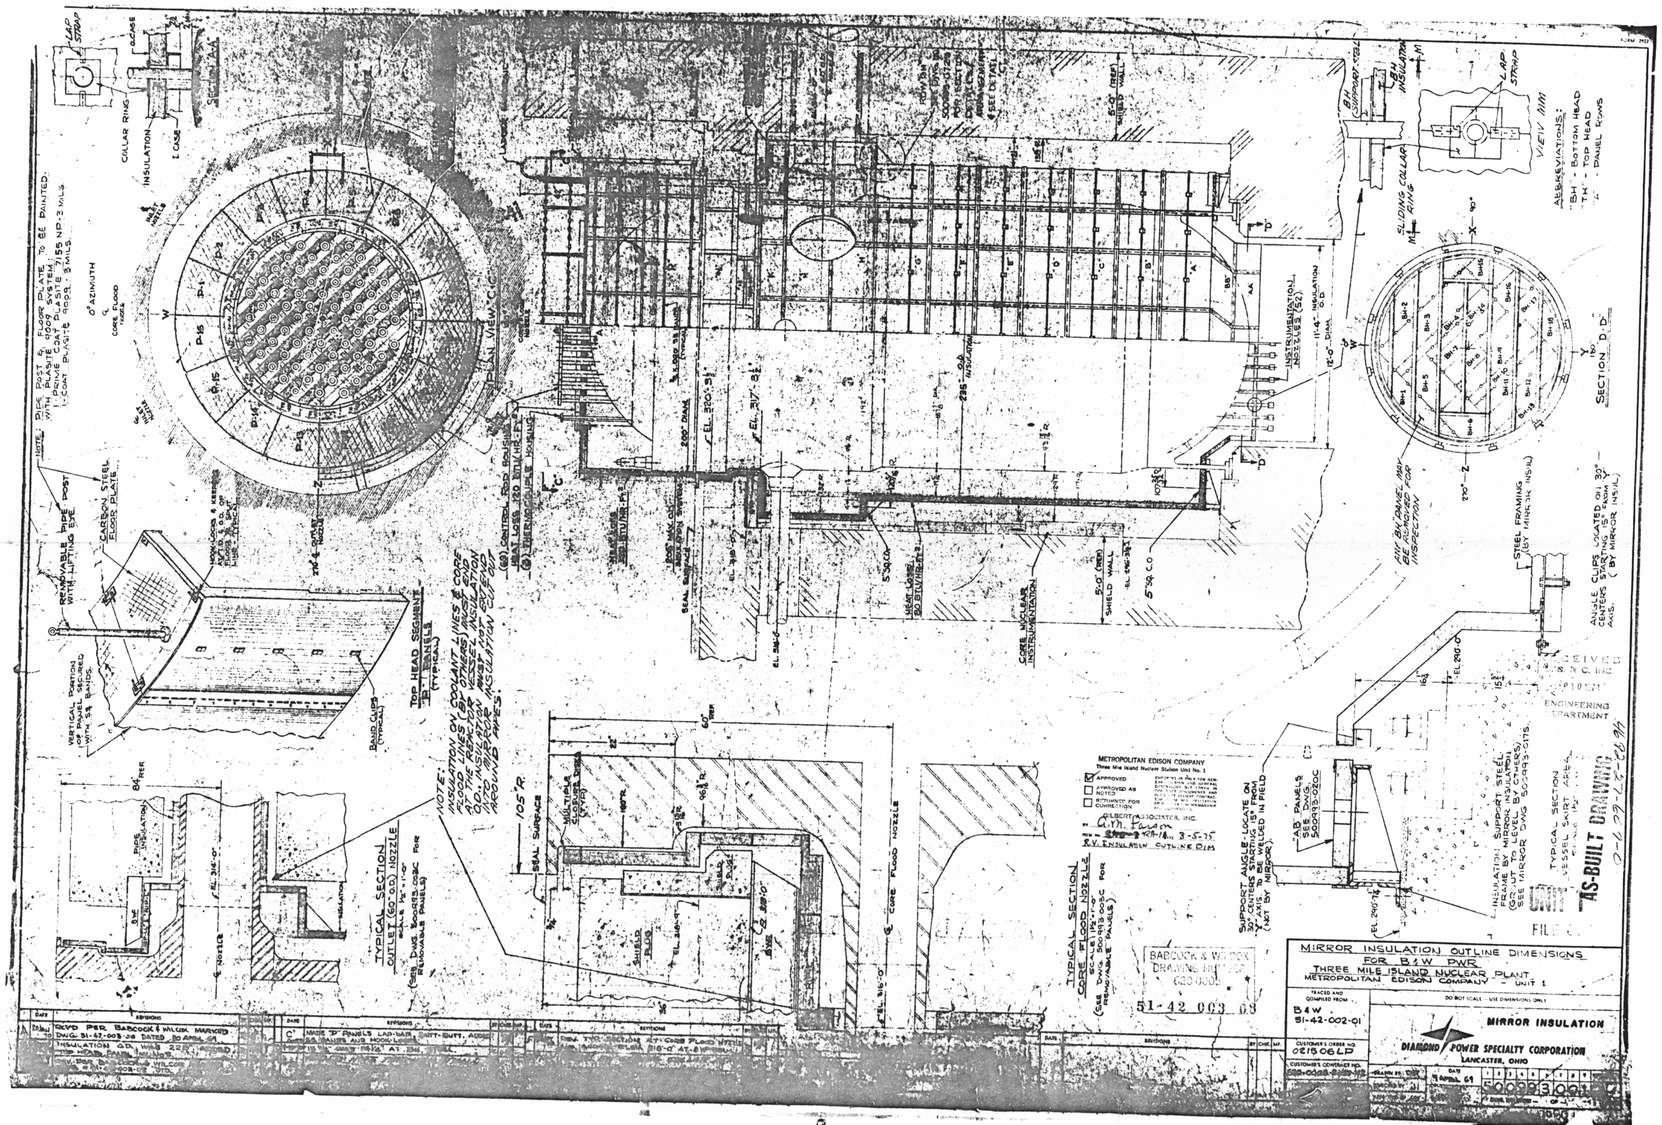
MIRROR INSULATION OUTLINE DIMENSIONS
FOR B&W PWR
THREE MILE ISLAND NUCLEAR PLANT
METROPOLITAN EDISON COMPANY - UNIT 1
MIRROR INSULATION
DIAMOND POWER SPECIALTY CORPORATION
LANCASTER, OHIO
51-42 003 08
AS-BUILT DRAWING
TYPICAL SECTION
CORE FLOOD NOZZLE
TOP HEAD SEGMENT
SECTION D-D
ABBREVIATIONS:
"BH" - BOTTOM HEAD
"TH" - TOP HEAD
"A" - PANEL ROWS
METROPOLITAN EDISON COMPANY
BABCOCK & WILCOX
DRAWING NUMBER
620-0005
51-42-002-01
0215 06 LP

D-7