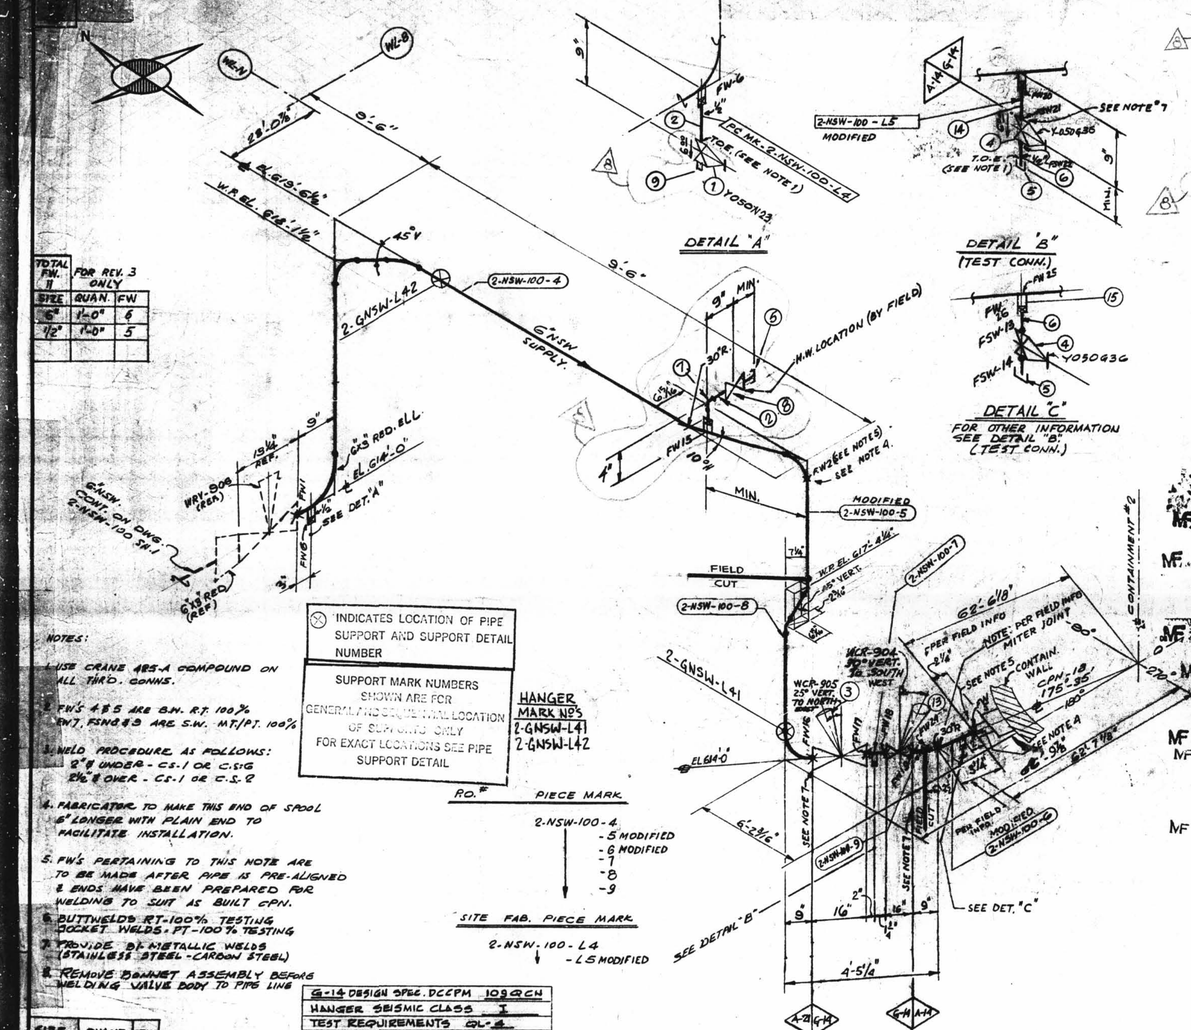

ISO SHT. NO. 1937

QSL	ITEM	QTY.	SIZE	MATERIAL DESCRIPTION	TAG No. OR ASTM MAT'L.	* HEAT NO.*
01	1	1	1/8"	200# THR'D NEEDLE VA. BRASS OR BRONZE	Y050N23	
	2	AS REQ'D	1/2"	PIPE (SCH. 80) SMLS. C.S.	A-106 GR. B.	
04	3	1	6"	B.W. DIAPH. CONTROL VA. S.S.	WCR-905	
	4	2	1/2"	600# C.S. S.W. GATE VALVE	Y050G30	
	5	3	1/2"	3000# C.S. THR'D CAP.	A-181 GR. I OR II	
	6	AS REQ'D	1/2"	PIPE (SCH. 80) SMLS. C.S.	A-106 GR. B	
	7		1/2"	3000# ELBOW, S.W., C.S.	A-181 GR. I OR II	
01	8	1	1/2"	600#, C.S., S.W. GLOBE VALVE	Y-050T36	
	9	2	1/2"	2000# THR'D. PLUG, C.S.	A-181 GR. I OR II	
04	13	1	6"	B.W. DIAPH. CONTROL VA. S.S.	WCR-904	
	14	AS REQ'D	1/2"	PIPE SCH. 40S SMLS	A-312 GR TP 304	
	15	1	1/2"	3000# C.S. S.W. HALF CPLG.	A-181 GR. I OR II	

REVISION RECORD

NO.	DATE	DR. CHK.	DESCRIPTION	REMARKS
1	1-20-76	DR. B.R.	REVISED BY A.E.P. DESIGN; PER RFC-DC-12-671; ADDED: 6" CHECK VALVE 15CE062A, 1" VENT-VALVE No. Y-100T23, 1/2" DRAIN-VALVE No. CY-050T36	ACTION REQ'D.
2	2/1/78	GP LB	PER RFC-12-, ADD DELETED VALVE TAG NO. C15CW062A & ITEMS 3 THRU 12 AND REVISED RELATED PIPING	FIELD ACTION REQ'D
3	9/14/81	K.A. D.R.	PER RFC-DC-12-2549 ADDED: PIPE SPEC. G-14, DIM'S, PCMK #7, FIELD WELD BOX, NOTES: 6, 7, 8, FW 16 TO 20, FSW 21 & 22, ITEM NO'S 13 & 14 TO B/M, DELETED ITEM NO'S; 7, 9, 10, 11 & 12 FROM B/M, REVISED ITEM No 3 B/M, MODIFIED PC. MK. 6 & L5.	FIELD ACTION REQ'D
4	10/14/81	K.A. JM	PER RFC-DC-12-2549 ROTATED ACTUATOR OF VALVE WCR-904 TO 25° VERT TOWARD SOUTH-WEST, REVISED DIM'S, ADDED DIM. 62'-7⅛"	FIELD ACTION REQ'D
5	6/4/82	KA 82	PER RFC-DC-12-2549 REVISED PIPING & DIM'S, RELOCATED TEST CONN. ADDED: FW'S 28, 29, 30, 31, 32, 33, 34, 35, 36, PC.MK. 2-NSW-100-8-5, ITEM 15 TO B/M MODIFIED PTO PC.MK. 2-NSW-100-8 & 5, ROTATED VALVE WCR-905 25° TO NORTH, REVISED & INSULATED PIPE WCR-905 & ROTATED 25° VERT. TO SOUTH-WEST, ADDED 30° ELBOW, 25° VERT. TO SOUTH-WEST, FW'S 5 & 6 SHOULD BE 2" & 3"	FIELD ACTION REQ'D.
6	7/21/82	HE JM	916" DIM. WAS 8'-6", 23'-0 7/8" WAS 23'-0", 62'-6 7/8" WAS 62'-7 7/8" TYPE CHANGES ARE DUE TO RE-DATING BASIC ON LATEST DWG. CHANGES	NO FIELD ACTION REQ'D.
7	8/11/86	DK. DRAWN LB	PER RFC-DC-12-2876 REQ'D - ITEM 8, TYPE OF VALVE. ADDED SUPPORT DETAILS, SUPERSEDED HGR 150 2-GNSW-100 SHT 2. ALL ABOVE TO REFLECT AS-BUILT CONDITIONS.	NO FIELD ACTION REQ'D.
8	7/21/90	FRB DCM LB	TO REFLECT AS-FOUND CONDITIONS FOR RFC-DC-12-3010 PER FWR # 759 REV. 1. ADDED: PLUG & ITEM # 1 & 9 ON B/M. REVISED: 1" VENT CONFIGURATION & B/M ITEM #1. ADDED: SUPPORT MARK NOS. & SUPERSEDES HGR. 150 NO. 2-GNSW-100 SH. # 2.	NO FIELD ACTION REQ'D.