TOTAL FW

N

NOTES:

1. USE CRANE 425-A COMPOUND ON ALL THR'D CONNS.
2. WELD PROCEDURE AS FOLLOWS:
   2" & UNDER - CS-1 OR CS-6
   2½" & OVER - CS-1 OR CS-2.
3. TO SUIT CONDITIONS, FIELD MAY REORIENT HANDWHEEL.

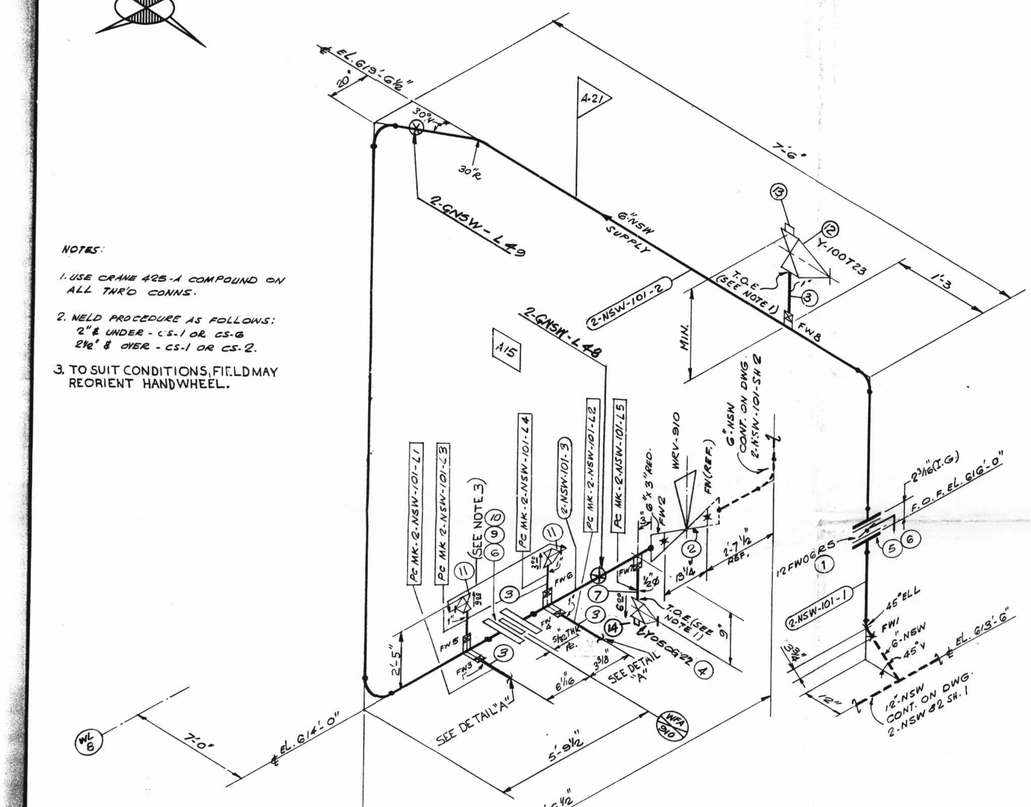

SUPPORT MARK NUMBERS FOR GENERAL ... OF SUPPORT ONLY. FOR EXACT LOCATION SEE PIPE SUPPORT DETAIL

TYPICAL LOCATION OF PIPE SUPPORT AND SUPPORT DETAIL NUMBER

SIZE	QUAN.	FW
6"	26'	1
3"	—	1
1"	4'	4
½"	1'	1

INSULATION
SPEC DCCPM450QCS.

LINE SIZE	NOM THK IN	REMARKS
6"	1"	GLASS

P.O.# PIECE MARK	SITE FAB. PIECE MARK
G16 2-NSW-101-1 -2 -3	2-NSW-101-L1 -L2 -L3 -L4 -L5

SUPPORT MARK NOS.
2-GNSW-L-48
2-GNSW-L-49

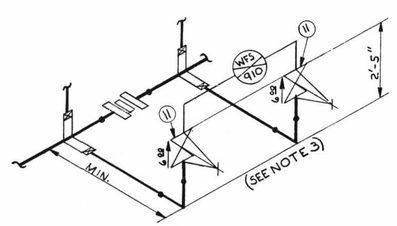

DETAIL "A"

ISO SHT. NO. 1998

QSL	ITEM	QTY.	SIZE	MATERIAL DESCRIPTION	TAG No. OR ASTM MAT'L.	HEAT NO.
01	1	1	6"	125# C.I. WAFER BUTTERFLY VA	12FWGRS	
	2	1	3"	REGULATING VALVE	WRV-910	
	3	AS REQ'D	1"	PIPE (SCH. 80) SMLS. C.S.	A-106 GR. B	
	4	1	½"	200# THR'D GLOBE VA. BRASS OR BRONZE	YOSO922	
	5	8	⅜ø	5½" LG. HEX. HD. MACH. BOLT	A-307 GR. B	
	6	16	⅜"	HEAVY HEX. NUT CL. 2 TOL.	A-307 GR. B.	
	7	AS REQ'D	½"	PIPE (SCH. 80) SMLS C.S.	A-106 GR. B	
	8					
	9	8	¾ ø	3½" LG. HEX. HD. MACH. BOLT	A-307 GR. B.	
	10	2	G	1/16" THK. FULL FACE, COMP. ASBESTOS RUBBER BONDED GASKET.	ANSI B16.21	
	11	4	1"	GLOBE-600# S.W.C.S. VALVE	Y-100T36	
	12	1	1"	2000# SCR'D GLOBE VALVE	Y-100T23	
	13	1	1"	2000# THR'D PLUG C.S.	B1B1 GR 3 OR II	
	14	1	½"	2000# THR'D. PLUG, C.S.		

REVISION RECORD

NO.	DATE	DRN. CHK.	DESCRIPTION	REMARKS
1	7-2-74	JM E.J.G.	RELEASED HOLDS ON PC. MK-2-NSW-101-L1-L2, -L3-& -L4 ADDED ITEM #11, NOTE #3, P.O.# G16 DET. 'A' & INSULATION STAMP. VOIDED ITEM #11. PER A.E.P. ARR'GT. DWG. 2-5497-4.	FIELD ACTION REQ'D
2	7/10/74	mc	ADDED VENT Y-100T23 - ARR'GT. DWG. 2-5497-B	
3	7/24/89	EBB SDW JB	TO REFLECT AS-FOUND CONDITIONS FOR RFC-DC-12-3010 PER FWR #759 REV. 1, ADDED: PLUG & ITEM #14 ON B/M. REVISED: B/M ITEM #4. ADDED: SUPPORT MARK NOS. & SUPESEDES HGR. ISO. # 2-GNSW-101 SH. # 1.	NO FIELD ACTION REQ'D.

| | | | | |