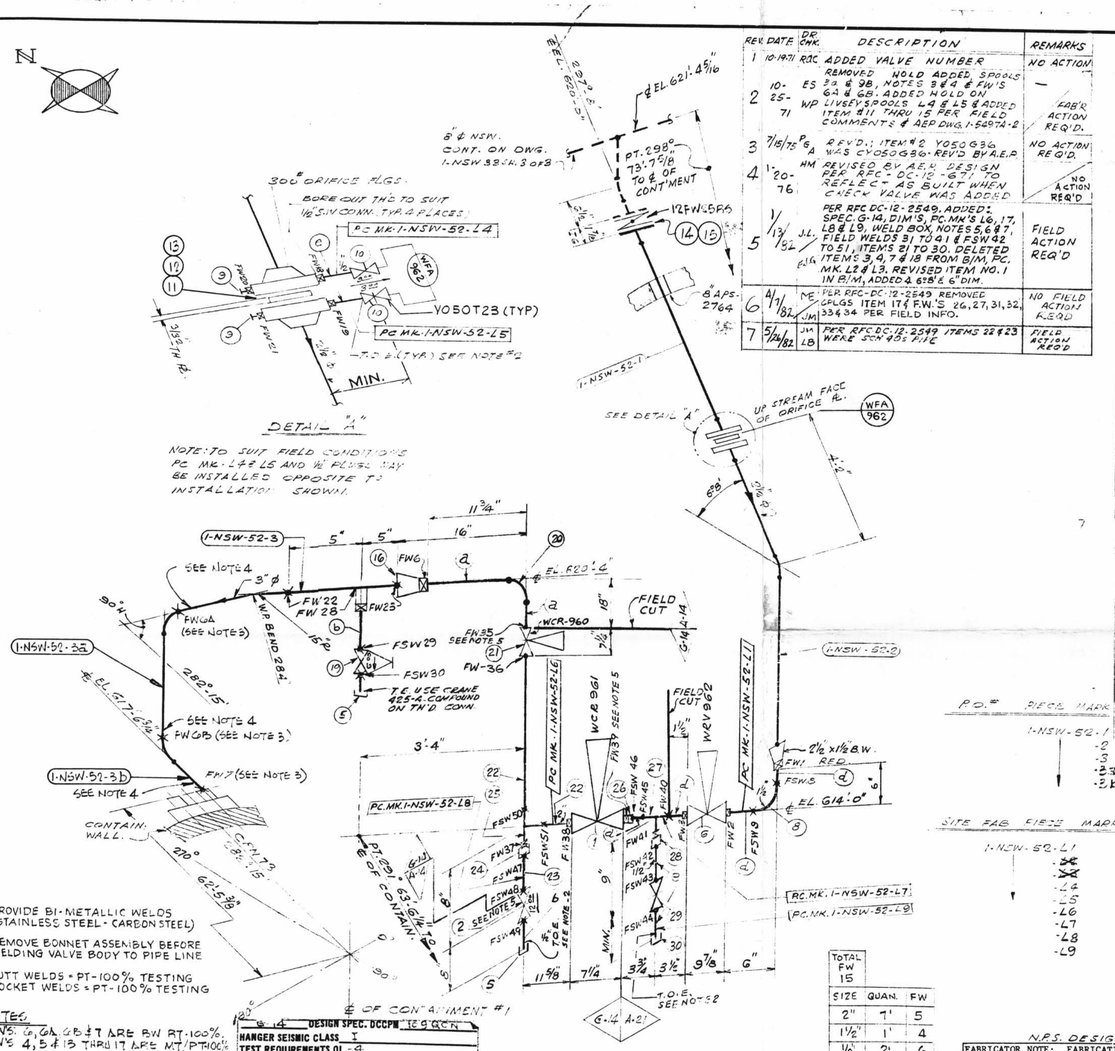

REV	DATE	DR. CHK.	DESCRIPTION	REMARKS
1	10-19-71	RJC	ADDED VALVE NUMBER	NO ACTION
2	10-25-71	ES WP	REMOVED HOLD ADDED SPOOLS 3a & 9B, NOTES 3 & 4 & FW'S G4 & G8. ADDED WELD ON LIVSEY SPOOLS L4 & L5 & ADDED ITEM #11 THRU 15 PER FIELD COMMENTS & AEP DWG. 1-5497A-2	FAB'R ACTION REQ'D.
3	7/15/75	P.G. A	REV'D.: ITEM #2 Y050G36 WAS CY050G36. REV'D BY A.E.P.	NO ACTION REQ'D.
4	1-20-76	HM	REVISED BY A.E.P. DESIGN PER RFC-DC-12-671 TO REFLECT AS BUILT WHEN CHECK VALVE WAS ADDED	NO ACTION REQ'D
5	1/13/82	JL EGK	PER RFC DC-12-2549, ADDED: SPEC. G-14, DIM'S, PC MK'S L6, L7, L8 & L9, WELD BOX, NOTES 5, 6 & 7, FIELD WELDS 31 TO 41 & FSW 42 TO 51, ITEMS 31 TO 30. DELETED ITEMS 3, 4, 7 & 18 FROM B/M, PC. MK. L2 & L3. REVISED ITEM NO. 1 IN B/M, ADDED 4.638'ℓ 6" DIM.	FIELD ACTION REQ'D
6	4/7/82	ME JM	PER RFC DC-12-2549 REMOVED SFLGS ITEM 17 & F.W.'S 26, 27, 31, 32, 33 & 34 PER FIELD INFO.	NO FIELD ACTION REQ'D
7	5/24/82	JM LB	PER RFC DC-12-2549 ITEMS 22 & 23 WERE SCH 40S PIPE	FIELD ACTION REQ'D

MATERIAL 150 SH. No. 1312

OSL	ITEM	QTY	SIZE	DESCRIPTION	TAG No. OR ASTM MAT'L	HEAT NO.
04	1	1	2"	S.W. DIAPH. CONTROL VA. S.S.	WCR 961	
	2	1	½"	600# S.W. C.S. GATE VALVE	Y050G36	
04	5	2	½"	C.S SOCK CAP 3000#	A-181 GR. I OR II	
01	6	1	1½"	CONTROL VALVE	WRV-962	
	8	1	1½"	S.W C.S. 90° ELL 3000#	A-181 GR I OR II	
	9	2	½"	PLUGS C.S. S.W. 3000#	"	
	10	2	½"	900# GLOBE VA. SOCKET WELD OR BRAZED	Y050T23	
04	11	1	2½"	GASKET, SPIRAL WOUND, STYLE CG, 1/16" THK. C.S. COMPRESSION RING, TYPE 304 S.S. WINDINGS & ASBESTOS FILLER		
04	12	8	¾" ⌀ 4"	LONG STUD BOLTS	A-193 GR. B7	
04	13	16	¾"	NUTS: HEXAGON, HEAVY SERIES	A-194 GR. 2H	
04	14	4	⅝" ⌀ 5"	LONG HEX HD. MACH BOLTS	A-307 GR. B	
04	9	AS REQ'D	2"	PIPE (SCH. 80) SMLS. C.S.	A-106 GR B	
04	6	"	1½"	"	"	
01	7	"	2"	"	"	
01	8	"	1½"	"	"	
01	9	"	1½"	"	"	
04	15	4	⅝"	HEAVY HEX NUT, CLASS 2 TOL.	A-307 GR B	
	16	1	3x2"	REDUCER	A-181 GR. I OR II	
04	19	1	½"	600# C.S. S.W. GLOBE VALVE	Y050T36	
04	20	1	2"	SW 90° ELL - 3000#	A-105 II	
	21	1	2"	S.W. DIAPH. CONTROL VA. S.S.	WCR-960	
	22	AS REQ'D	2"	PIPE (SCH. 80S) S.S.	A-312 GR TP 304	
	23	AS REQ'D	½"	PIPE (SCH. 80S) S.S.	"	
	24	1	2"x1½"	RED. INSERT S.S. 3000#	A-182 GR. F 304	
	25	1	2"	TEE S.W. S.S. 3000#	"	
01	26	1	2"x1½"	RED. INSERT C.S. 3000#	A-181 GR. I OR II	
	27	1	1½"	TEE S.W. C.S. 3000#	"	
	28	1	1½"x½"	RED. INSERT C.S. 3000#	"	
	29	1	½"	600# S.W. C.S. GATE VALVE	Y050G36	
	30	1	½"	CAP SCR'D C.S. 3000#	A-181 GR. I OR II	

P.O.# PIECE MARK
1-NSW-52-1
-2
-3
-3a
-3b

SITE FAB PIECE MARK
1-NSW-52-L1
-L2
-L3
-L4
-L5
-L6
-L7
-L8
-L9

D-83

LABOR COST CONTROL	
USE ONLY WITH	
PIPE SIZE	
SCHEDULE	
TYPE	
ISO START DATE	
ISO FINISH DATE	
WORK OPERATION	LINE ITEM NUMBER
HANGER INST.	
ERECT	
WELD	
RADIO-G – X-RAY	
STRESS RELIEVE	
MISC. WORK	

LABOR COST CONTROL	
USE ONLY WITH	
PIPE SIZE	
SCHEDULE	
TYPE	
ISO START DATE	
ISO FINISH DATE	
WORK OPERATION	LINE ITEM NUMBER
HANGER INST.	
ERECT	
WELD	
RADIO-G – X-RAY	
STRESS RELIEVE	
MISC. WORK	

5. PROVIDE BI-METALLIC WELDS (STAINLESS STEEL - CARBON STEEL)
6. REMOVE BONNET ASSEMBLY BEFORE WELDING VALVE BODY TO PIPE LINE
7. BUTT WELDS = PT-100% TESTING
SOCKET WELDS = PT-100% TESTING

NOTES:
1. FW'S: G, GA, GB & 7 ARE BW RT-100%. FW'S 4, 5 & 13 THRU 17 ARE MT/PT 100%
2. USE CRANE 425-A COMPOUND ON ALL THRD CONNS.
3. FIELD WELDS REFERENCED TO THIS NOTE ARE TO BE MADE AFTER PIPE IS CUT, ALIGNED & ENDS HAVE BEEN PREPARED FOR WELDING TO SUIT AS BUILT CPN.
4. SPOOL TO BE FABRICATED WITH 6" EXTRA PIPE AND PLAIN END TO FACILITATE INSTALLATION.

⌀ 14 DESIGN SPEC. DCCPM 12 9 QCR	
HANGER SEISMIC CLASS I	
TEST REQUIREMENTS QL-4	
WELD PROCEDURE	
QSL-04 TESTING SEE NOTE 7	
A-21 DESIGN SPEC. DCCPM 102 QCS	
HANGAR SEISMIC CLASS II	
TEST REQUIREMENTS QL-1	
WELD PROCEDURE 25-21	
QSL-01 TESTING N/A	
A-14 DESIGN SPEC. DCCPM 103 QCN	
HANGAR SEISMIC CLASS	
TEST REQUIREMENTS QL-4	
WELD PROCEDURE 25-21	
QSL-06 TESTING SEE NOTE #1	

DESIGN SPEC	SEE
HANGER SEISMIC CLASS	[illegible]
TEST REQUIREMENTS	[illegible]
MATERIAL CLASS	[illegible]

A.P. - APPROXIMATE POINT
T.O.E. - THREAD ONE END
T.B.E. - THREAD BOTH ENDS
B.O.E. - BEVEL ONE END
T.O.P. - TOP OF PIPE ELEV.
T.S.L. - THERMAL SENSITIVITY REQUIREMENTS
T.L. - TRUE LENGTH
B.B.E. - BEVEL BOTH ENDS
P.O.E. - PLAIN ONE END
P.B.E. - PLAIN BOTH ENDS
S.O.E. - SHAPE ONE END
B.O.P. - BOTTOM OF PIPE ELEV.
F.W.F. - FIELD WELD
H - HORIZONTAL
V - VERTICAL
SW - SHOP WELD
FSW - FIELD SHOP WELD
F - FIELD WELD
A - AUTOMATIC SHOP WELD
M - MANUAL SHOP WELD
* - VERIFY DIMENSION IN FIELD

PIPE													
A-53		A-106		A-376		A-312							
		GR. B				GR. 304							
STD.	XS	XXS	10	20	30	40	60	80	100	120	140	160	
SWLS		WLDD											

FITTINGS		
A-105	A-234	A-182
A-403	A-181	

TESTING				
N.D.T.				
M.T.	P.T.	R.T.	U.T.	
PRESSURE TEST				
MED.	PRESS.	DURATION		

ADDITIONAL

TOTAL FW 15		
SIZE	QUAN.	FW
2"	7'	5
1½"	1'	4
½"	2'	6

N.P.S. DESIGNS

FABRICATOR NOTE: FABRICATION MUST CONFORM TO LATEST A.E.P. ARRGT. DWGS.

POUR/ZONE No. 1C5 FLOW DIAGRAM 1-5114A
REQUIRED COMPLETION DATE Q.S.L. SEE DESIGN
FABRICATED BY TUBECO WELD PROCEDURE CODE 21 AMP

REVISION RECORD		
NO.	DATE	DESCRIPTION

1NSW-52

LIVSEY & COMPANY, INC.
DONALD C. COOK NUCLEAR PLANT

DWN. S.G.	DATE 8-25-71	CONTAIN. VICINITY	
CKD. GN	DATE 10-5-71	DWG. NO. 1-NSW-52	REV. 7
ISSUED			

REF. DWG. 1-5497A