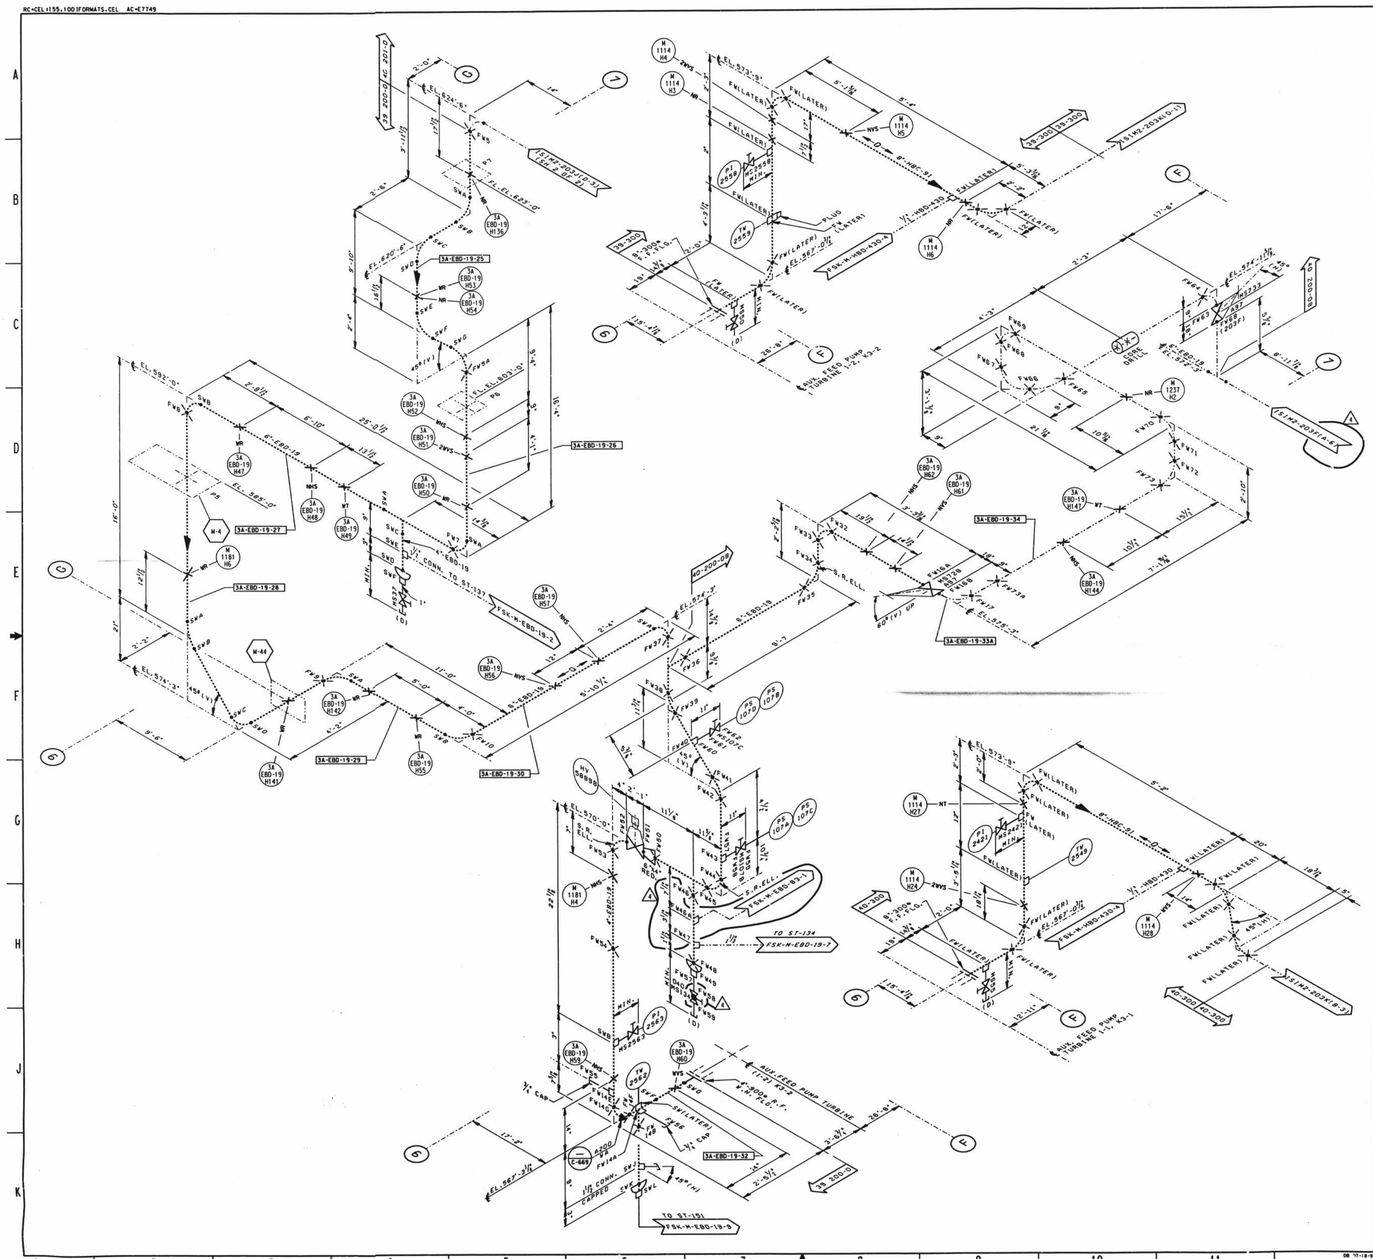

LEGEND

———	ASME SECTION XI CLASS 1 PIPING
– – – –	ASME SECTION XI CLASS 2 PIPING
· · · · · ·	ASME SECTION XI CLASS 3 PIPING
———	NON-ISI NUCLEAR CLASS AND NSC CLASS
—·—·—	PRESSURE BOUNDARY EXTENSION
—·—·—	REFERENCE & CONTINUITY
—D—D—	HVAC DUCT
A	ANCHOR
CS	CONSTANT SPRING HANGER
VS	VARIABLE SPRING HANGER
HS	HYDRAULIC SNUBBER
MS	MECHANICAL SNUBBER
N	NON-WELDED SUPPORT ATTACHMENT
W	WELDED INTEGRAL SUPPORT ATTACHMENT
R	RIGID SUPPORT
T	SWAY STRUT
SW	SHOP WELD
FW	FIELD WELD
LW	LONGITUDINAL WELD
WOL	WELDOLET
⇦	ISI ITEM NUMBER DESIGNATION USED IN THE FIRST 10 YEAR INSERVICE INSPECTION INTERVAL.

NOTES:

1. MULTIPLE SWAY STRUTS, SPRING SUPPORTS OR SNUBBERS IN A SINGLE PIPING SUPPORT ARE SHOWN BY A NUMBER BEFORE THE SUPPORT TYPE. (EXAMPLE: 2MHS - TWO HYDRAULIC TYPE SNUBBERS THAT ARE NOT WELDED INTEGRAL TO THE PIPE).
2. THERE ARE NO SPOOL NUMBERS FOR LINE 8"-HBC-91.
3. SUPPORT NUMBERS AND LOCATIONS FOR THIS DRAWING ARE DERIVED FROM DRAWINGS 1250I-HL-203H (SUPPLY TO AFPT 1-2) AND 1250I-HL-1114, SHEET 1 (AFPT EXHAUST).
4. THE SUPPORTS ON THE MAINSTEAM AUX. FEED PUMP SUPPLY LINE 4"-EBD-19, 6"-EBD-19, AND 8"-EBD-91 ARE WITHIN THE ISI EXAMINATION BOUNDARY. THE PIPING WELDS IN THESE LINES ARE SHOWN FOR REFERENCE PURPOSES ONLY. THESE WELDS MAY NOT BE REPRESENTED IN THE ACTUAL AS-BUILT CONDITION.
5. PIPING SYSTEMS ON THIS DRAWING WHICH ARE OUTSIDE OF THE ISI BOUNDARY, ARE SHOWN FOR REFERENCE AND CONTINUITY PURPOSES ONLY. THE CONFIGURATION SHOWN MAY NOT REPRESENT THE ACTUAL AS-BUILT CONDITION.

REFERENCE DRAWINGS:

1SI02-003C MAIN STEAM AND REHEAT STEAM SYSTEM SHEET 3

GENERAL NOTE:

DIMENSIONS SHOWN ON THIS DRAWING ARE TO BE USED FOR APPROXIMATE LOCATION ONLY. USE DESIGN DRAWINGS FOR DIMENSIONAL VERIFICATION.

D-040

NO.	DATE	REVISIONS	BY	CK'D	ENGR.	SUPV. ENGR.	DES. SUPV.
4	12/29/92	INC DCN 1SIM2-203H-8 PER MOD 85-0060 SUP. 0 & DEN. UPDATE ZONE COND. FOR CONT. TO 1SIM2-203F (ZONE B-12)	SBW	DVK			—
3	10/5/92	INC DCN 1SIM2-203H-6 PER MOD 92-0488	*INITIALS ON FILE*				
2	11/15/90	INC DCN'S 1SIM2-203H-5 FOR MOD 87-1273 SUP. 0 & 1SIM2-203H-4 FOR MOD 87-1273 SUP. 1	*INITIALS ON FILE*				
1	12/15/89	INC DCN 1SIM2-203H-2 FOR MOD 91-0051	*INITIALS ON FILE*				
0	11/15/89	ISSUED FOR SECOND 10 YEAR ISI PROGRAM	*INITIALS ON FILE*				

SCALE N.T.S. | DESIGNED | DRWN. CB | DATE

DAVIS-BESSE NUCLEAR POWER STATION
UNIT NO. 1

THE TOLEDO EDISON COMPANY

INSERVICE INSPECTION ISOMETRIC

MAIN STEAM SYSTEM

SUPPLY TO AUX. FEED PUMP TURBINE NO.1-2 & EXHAUST

DRAWING NO. ISIM2-203H | REV. 4

SIZE

DR 17-18-96 | DFN=F:/ISIM/ISIM203H.DGN | LEVELS 1234567891011121314151617181920212223242526272829303132

I CERTIFY THAT THE IMAGE CONTAINED ON THIS FRAME WAS MADE BY THE STORAGE AND RETRIEVAL SYSTEM OF TECHNICAL DATA AND WORK STORAGE BEGIN AND THAT IT IS AN ACCURATE REPRODUCTION OF THE RECORDS CONTAINED IN ATTACHED RECORDS.