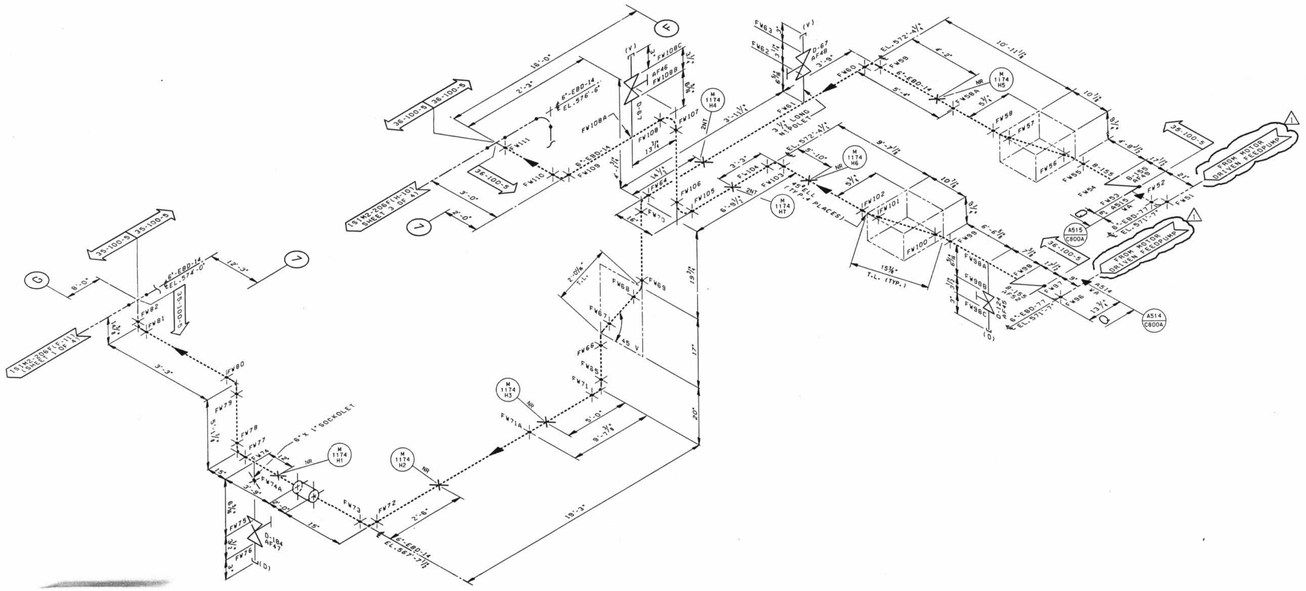

LEGEND

- ASME SECTION XI CLASS 1 PIPING
- ASME SECTION XI CLASS 2 PIPING
- ASME SECTION XI CL. 3 PIPING
- NON-ISI NUCLEAR CLASS AND HSC CLASS
- PRESSURE BOUNDARY EXTENSION
- REFERENCE & CONTINUITY
- HVAC DUCT

A	ANCHOR
CS	CONSTANT SPRING HANGER
VS	VARIABLE SPRING HANGER
HS	HYDRAULIC SNUBBER
MS	MECHANICAL SNUBBER
N	NON-WELDED SUPPORT ATTACHMENT
W	WELDED INTEGRAL SUPPORT ATTACHMENT
R	RIGID SUPPORT
T	SWAY STRUT
SW	SHOP WELD
FW	FIELD WELD
LW	LONGITUDINAL WELD
WOL	WELDOLET

⇦ ISI ITEM NUMBER DESIGNATION USED IN THE FIRST 10 YEAR INSERVICE INSPECTION INTERVAL.

NOTES:

1. MULTIPLE SWAY STRUTS, SPRING SUPPORTS OR SNUBBERS IN A SINGLE PIPING SUPPORT ARE SHOWN BY A NUMBER BEFORE THE SUPPORT TYPE. (EXAMPLE: 2MS - TWO HYDRAULIC TYPE SNUBBERS THAT ARE NOT WELDED INTEGRAL TO THE PIPE).
2. THERE ARE NO SPOOL NUMBERS FOR PIPING ON THIS DRAWING.
3. THE SUPPORTS ON THE MOTOR DRIVEN FEED PUMP LINE 4"-EBD-14 ARE WITHIN THE ISI EXAMINATION BOUNDARY. THE PIPING WELDS IN THIS LINE ARE SHOWN FOR REFERENCE PURPOSES ONLY. THESE WELDS MAY NOT BE REPRESENTED IN THE ACTUAL AS-BUILT CONDITION.

GENERAL NOTES:

DIMENSIONS SHOWN ON THIS DRAWING ARE TO BE USED FOR APPROXIMATE LOCATION ONLY. USE DESIGN DRAWINGS FOR DIMENSIONAL VERIFICATION.

REFERENCE DRAWINGS:

1SI02-006D AUXILIARY FEEDWATER SYSTEM

1SI02-007B STEAM GENERATOR SECONDARY SYSTEM

HL-1174 SHT.2 OF 2 HANGER LOCATION DRAWING FOR FCR 85-025

D-051

NO.	DATE	REVISIONS	BY	QA	ENGR	ENGR	CHIEF ENGR
1	11/92	ING DCN 1SIM2-2060-1 FOR DCR 91-001	JOR				
0	4-24-90	ISSUED FOR SECOND 10 YEAR ISI PROGRAM					

SCALE N.T.S. DESIGNED DRAWN CB CHK'D

DAVIS-BESSE NUCLEAR POWER STATION
UNIT NO. 1
THE TOLEDO EDISON COMPANY

Q

INSERVICE INSPECTION ISOMETRIC
CONDENSATE SYSTEM
MOTOR DRIVEN FEED PUMP P-241 DISCHARGE

DRAWING NO. ISIM2-2060 REV. 1

DRAWING: 1SIM2-2060-DCN

LEVELS: 1234567890123456789012345678901234567890123456789012345678901234

14