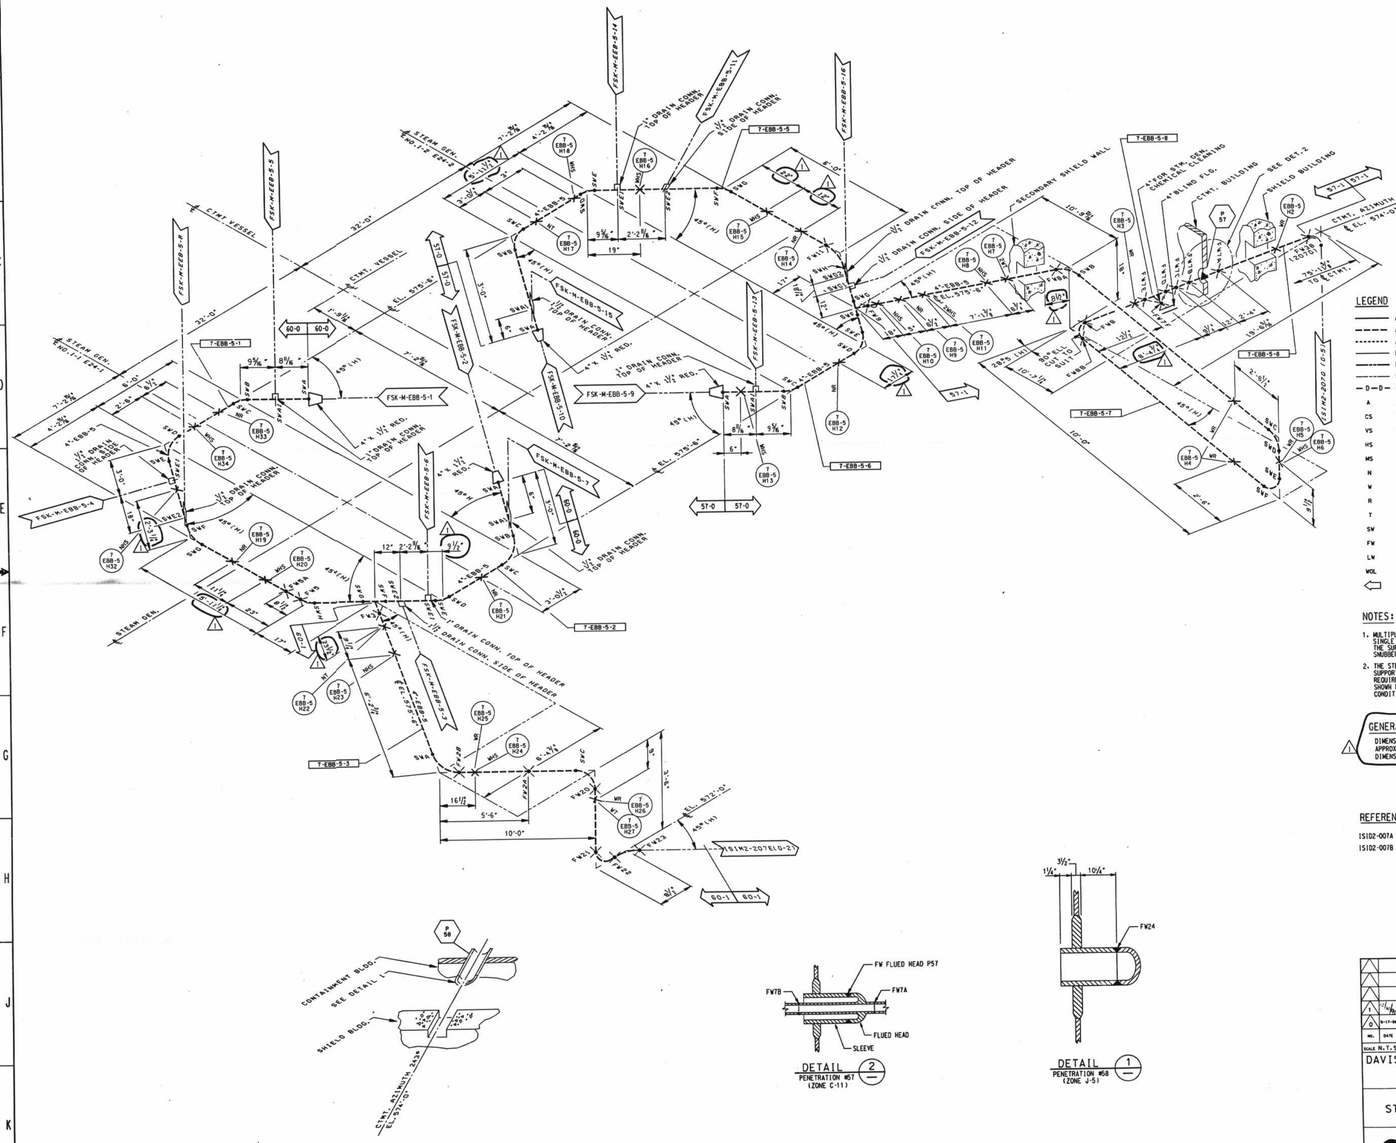

LEGEND

- ASME SECTION XI CLASS 1 PIPING
- ASME SECTION XI CLASS 2 PIPING
- ASME SECTION XI CLASS 3 PIPING
- NON-ISI NUCLEAR CLASS AND HSC CLASS
- PRESSURE BOUNDARY EXTENSION
- REFERENCE & CONTINUITY
- HVAC DUCT

A	ANCHOR
CS	CONSTANT SPRING HANGER
VS	VARIABLE SPRING HANGER
HS	HYDRAULIC SNUBBER
MS	MECHANICAL SNUBBER
N	NON-WELDED SUPPORT ATTACHMENT
W	WELDED INTEGRAL SUPPORT ATTACHMENT
R	RIGID SUPPORT
T	SWAY STRUT
SW	SHOP WELD
FW	FIELD WELD
LW	LONGITUDINAL WELD
WOL	WELDOLET

ISI ITEM NUMBER DESIGNATION USED IN THE FIRST 10 YEAR INSERVICE INSPECTION INTERVAL.

NOTES:

1. MULTIPLE SWAY STRUTS, SPRING SUPPORTS OR SNUBBERS IN A SINGLE PIPING SUPPORT ARE SHOWN BY A NUMBER BEFORE THE SUPPORT TYPE. (EXAMPLE: 2HMS - TWO HYDRAULIC TYPE SNUBBERS THAT ARE NOT WELDED INTEGRAL TO THE PIPE).
2. THE STEAM GENERATOR DRAIN LINE 4"-EBB-S WELDS AND SUPPORTS ARE EXEMPT FROM INSERVICE EXAMINATION REQUIREMENTS PER IWC-1220. THE WELDS AND SUPPORTS SHOWN MAY NOT REPRESENT THE ACTUAL AS-BUILT CONDITION.

GENERAL NOTE

DIMENSIONS SHOWN ON THIS DRAWING ARE TO BE USED FOR APPROXIMATE LOCATION ONLY. USE DESIGN DRAWINGS FOR DIMENSIONAL VERIFICATION.

REFERENCE DRAWINGS:

ISI02-007A STEAM GENERATOR SECONDARY SYSTEM
ISI02-007B STEAM GENERATOR SECONDARY SYSTEM

D-052

NO.	DATE	REVISIONS	BY	CH'K	ENGR. SUPV.	ENG. MGR.
1	10-29-91	INC DCN ISIM2-207A-1 PER DCN 91-0011	DVK			
0	9-17-90	ISSUED FOR SECOND 10 YEAR ISI PROGRAM	LFM	MRN DUC	TWB	MGH ECC

SCALE N.T.S. | DESIGNED | DRAWN CB | DATE

DAVIS-BESSE NUCLEAR POWER STATION
UNIT NO. 1
THE TOLEDO EDISON COMPANY

INSERVICE INSPECTION ISOMETRIC
STEAM GENERATOR DRAIN SYSTEM
CONTAINMENT BUILDING

DRAWING NO. ISIM2-207A | REV. 1

DFN=//ISIM/ISIM207A.DGN | DB 10-29-91 | 14 | 24X44 "E" SIZE

I CERTIFY THAT THE IMAGE CONTAINED ON THIS FRAME WAS MADE IN THE NORMAL AND REGULAR COURSE OF BUSINESS, ON THE DATE STATED BELOW AND THAT IT IS AN ACCURATE REPRODUCTION OF THE RECORD(S) DESCRIBED ON MAPS FOR SUPERVISOR/OPERATOR