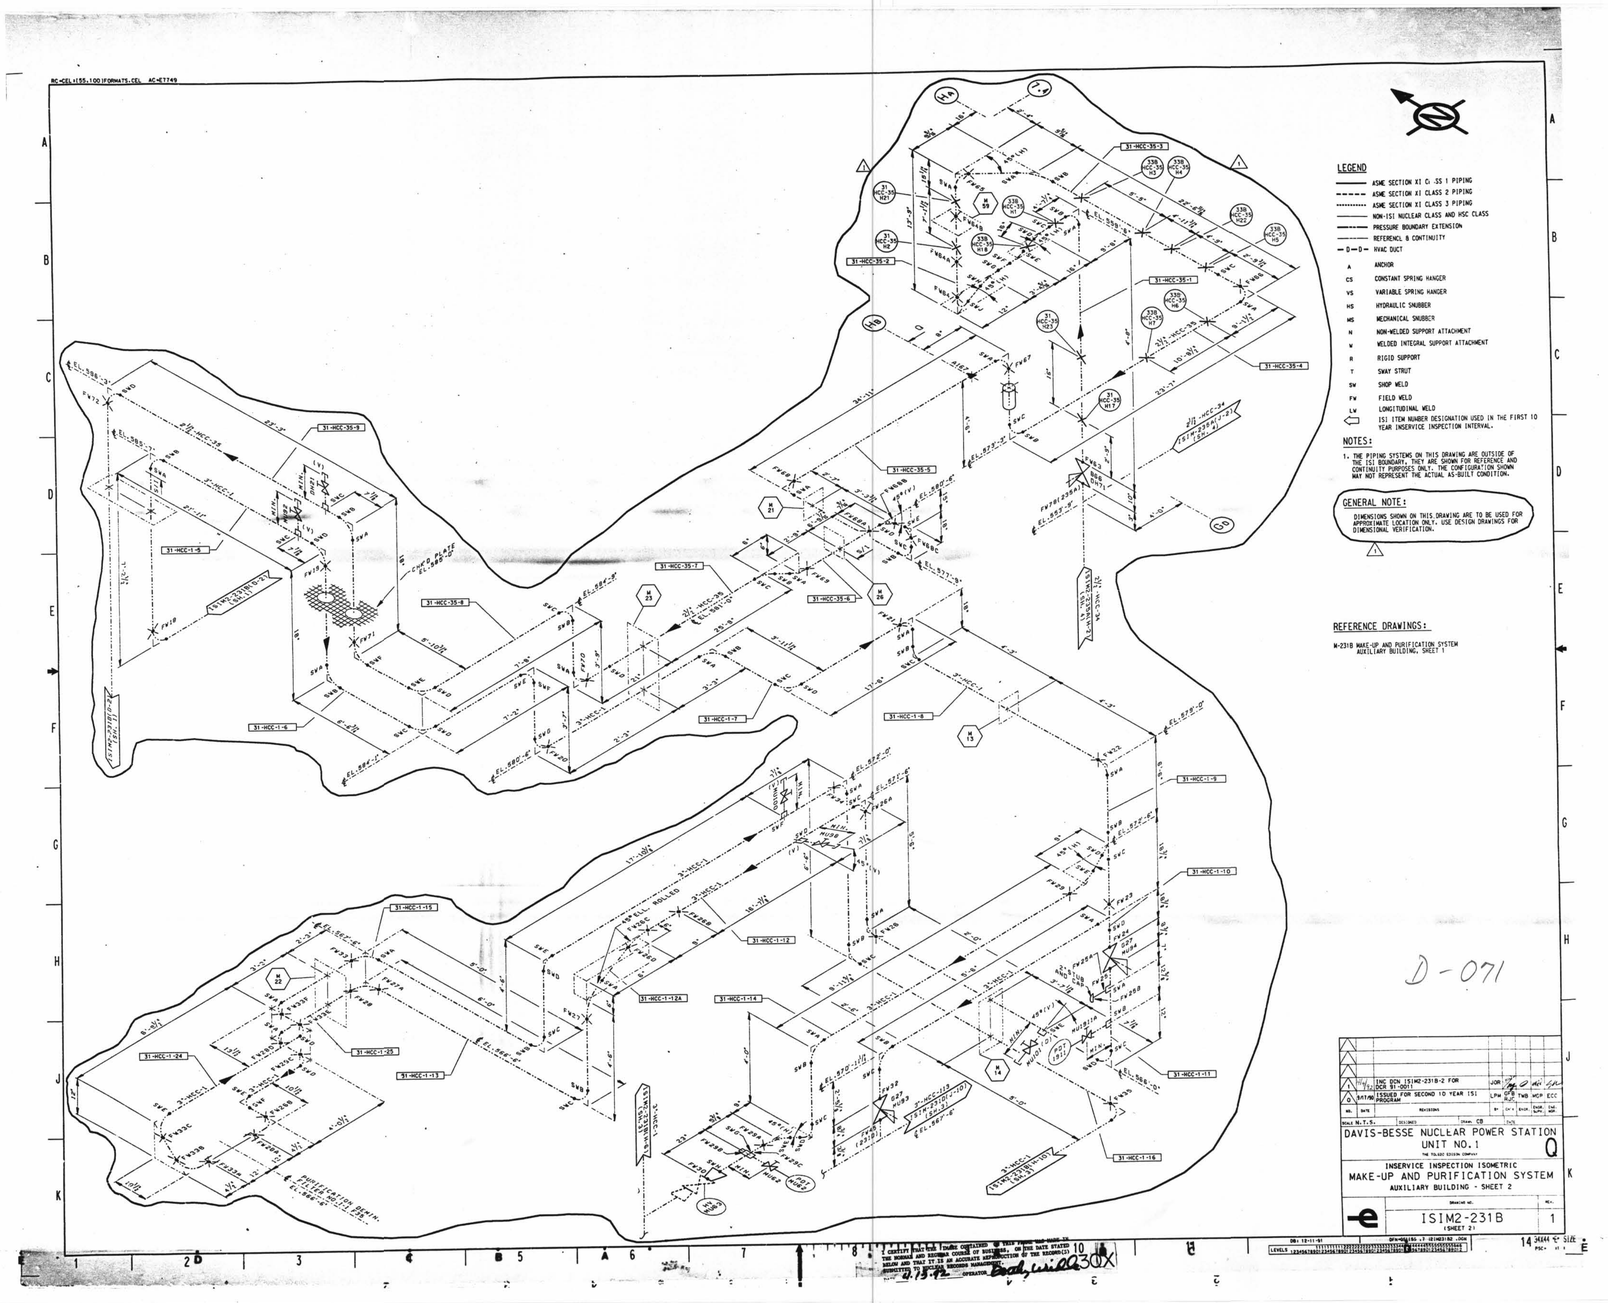
LEGEND
ASME SECTION XI CLASS 1 PIPING
ASME SECTION XI CLASS 2 PIPING
ASME SECTION XI CLASS 3 PIPING
NON-ISI NUCLEAR CLASS AND HSC CLASS
PRESSURE BOUNDARY EXTENSION
REFERENCE & CONTINUITY
HVAC DUCT
A ANCHOR
CS CONSTANT SPRING HANGER
VS VARIABLE SPRING HANGER
HS HYDRAULIC SNUBBER
MS MECHANICAL SNUBBER
N NON-WELDED SUPPORT ATTACHMENT
W WELDED INTEGRAL SUPPORT ATTACHMENT
R RIGID SUPPORT
T SWAY STRUT
SW SHOP WELD
FW FIELD WELD
LW LONGITUDINAL WELD
ISI ITEM NUMBER DESIGNATION USED IN THE FIRST 10 YEAR INSERVICE INSPECTION INTERVAL.
NOTES:
1. THE PIPING SYSTEMS ON THIS DRAWING ARE OUTSIDE OF THE ISI BOUNDARY. THEY ARE SHOWN FOR REFERENCE AND CONTINUITY PURPOSES ONLY. THE CONFIGURATION SHOWN MAY NOT REPRESENT THE ACTUAL AS-BUILT CONDITION.
GENERAL NOTE:
DIMENSIONS SHOWN ON THIS DRAWING ARE TO BE USED FOR APPROXIMATE LOCATION ONLY. USE DESIGN DRAWINGS FOR DIMENSIONAL VERIFICATION.
REFERENCE DRAWINGS:
M-231B MAKE-UP AND PURIFICATION SYSTEM AUXILIARY BUILDING, SHEET 1
D-071
INC DCN 151M2-231B-2 FOR DCR 91-0011
ISSUED FOR SECOND 10 YEAR ISI PROGRAM
DAVIS-BESSE NUCLEAR POWER STATION UNIT NO. 1
THE TOLEDO EDISON COMPANY
INSERVICE INSPECTION ISOMETRIC
MAKE-UP AND PURIFICATION SYSTEM
AUXILIARY BUILDING - SHEET 2
ISIM2-231B
(SHEET 2)
SIZE E