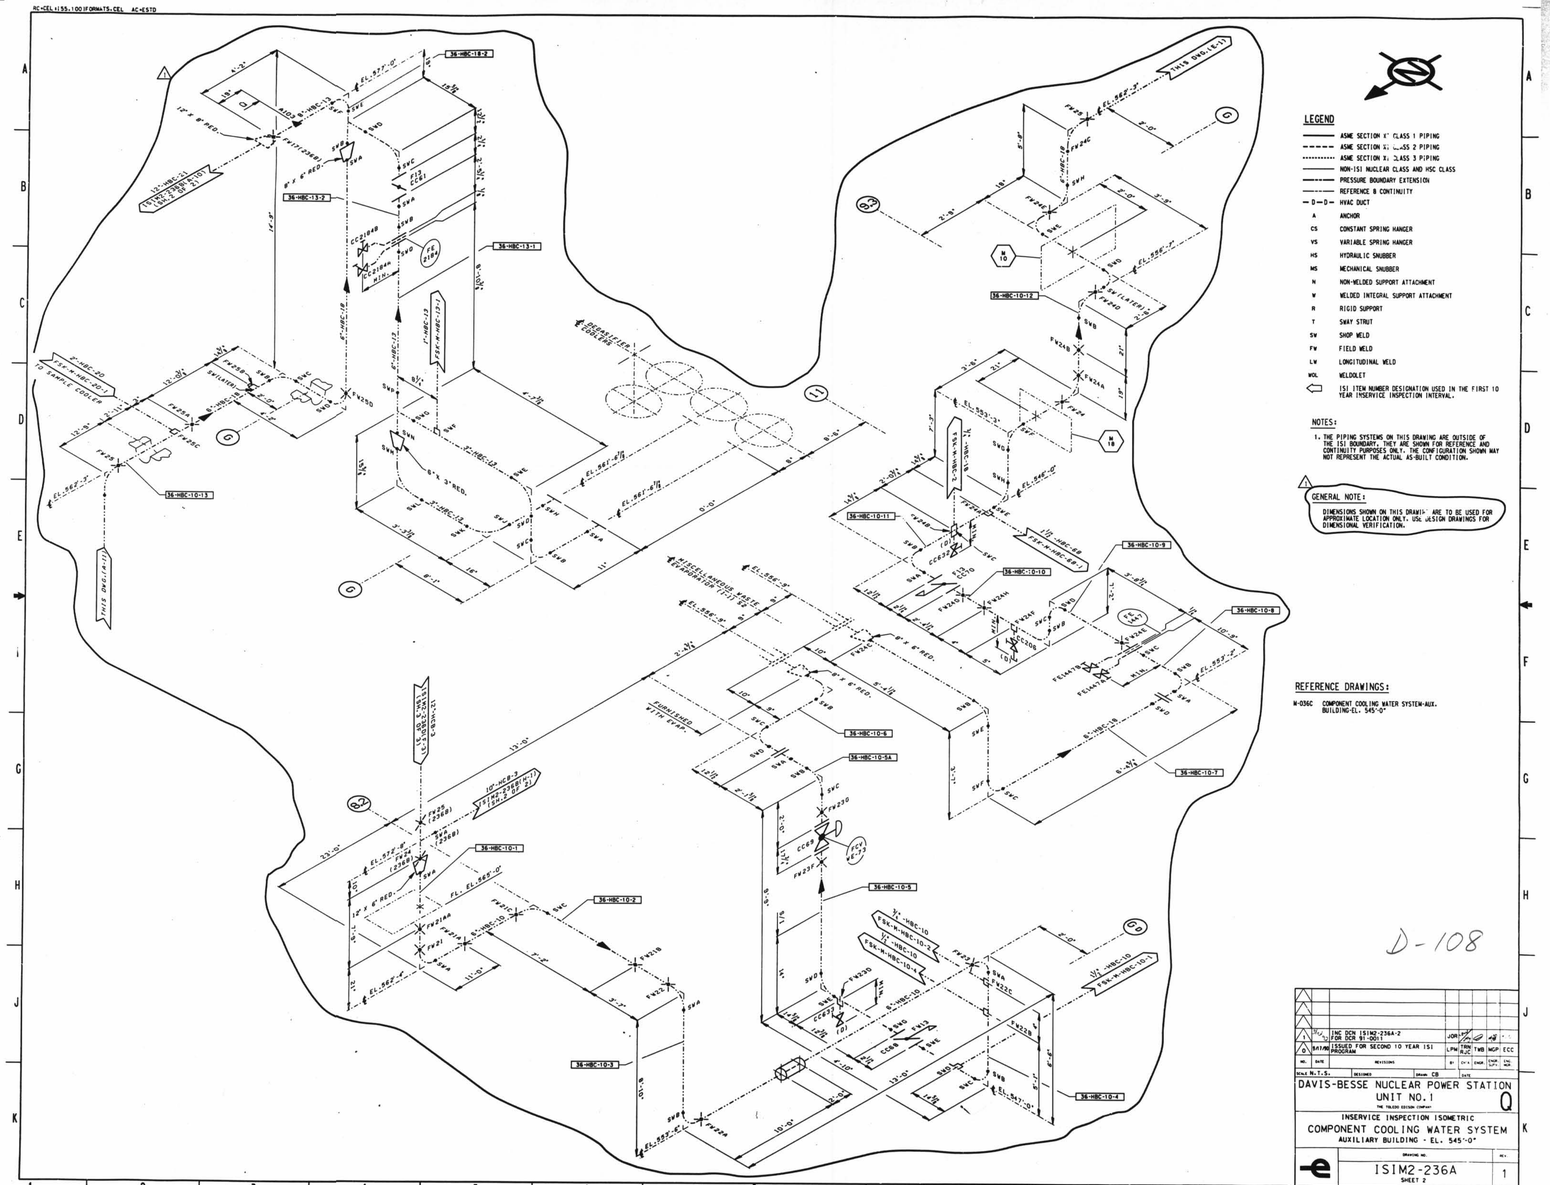
LEGEND
ASME SECTION X CLASS 1 PIPING
ASME SECTION X CLASS 2 PIPING
ASME SECTION X CLASS 3 PIPING
NON-ISI NUCLEAR CLASS AND HSC CLASS
PRESSURE BOUNDARY EXTENSION
REFERENCE & CONTINUITY
HVAC DUCT
A ANCHOR
CS CONSTANT SPRING HANGER
VS VARIABLE SPRING HANGER
HS HYDRAULIC SNUBBER
MS MECHANICAL SNUBBER
N NON-WELDED SUPPORT ATTACHMENT
W WELDED INTEGRAL SUPPORT ATTACHMENT
R RIGID SUPPORT
T SWAY STRUT
SW SHOP WELD
FW FIELD WELD
LW LONGITUDINAL WELD
WOL WELDOLET
ISI ITEM NUMBER DESIGNATION USED IN THE FIRST 10 YEAR INSERVICE INSPECTION INTERVAL.
NOTES:
1. THE PIPING SYSTEMS ON THIS DRAWING ARE OUTSIDE OF THE ISI BOUNDARY. THEY ARE SHOWN FOR REFERENCE AND CONTINUITY PURPOSES ONLY. THE CONFIGURATION SHOWN MAY NOT REPRESENT THE ACTUAL AS-BUILT CONDITION.
GENERAL NOTE:
DIMENSIONS SHOWN ON THIS DRAWING ARE TO BE USED FOR APPROXIMATE LOCATION ONLY. USE DESIGN DRAWINGS FOR DIMENSIONAL VERIFICATION.
REFERENCE DRAWINGS:
M-056C COMPONENT COOLING WATER SYSTEM-AUX. BUILDING-EL. 545'-0"
D-108
INC DCN 1SIM2-236A-2 FOR DCR 91-0011
ISSUED FOR SECOND 10 YEAR ISI PROGRAM
DAVIS-BESSE NUCLEAR POWER STATION
UNIT NO. 1
THE TOLEDO EDISON COMPANY
INSERVICE INSPECTION ISOMETRIC
COMPONENT COOLING WATER SYSTEM
AUXILIARY BUILDING - EL. 545'-0"
ISIM2-236A
SHEET 2
REV. 1