


- LEGEND**
- ASME SECTION XI CLASS 1 PIPING
 - - - ASME SECTION XI CLASS 2 PIPING
 - ASME SECTION XI CLASS 3 PIPING
 - NON-151 NUCLEAR CLASS AND HSC CLASS
 - PRESSURE BOUNDARY EXTENSION
 - REFERENCE B CONTINUITY
 - D - D - HVAC DUCT
 - A ANCHOR
 - CS CONSTANT SPRING HANGER
 - VS VARIABLE SPRING HANGER
 - HS HYDRAULIC SMOOTHER
 - MS MECHANICAL SMOOTHER
 - N NON-WELDED SUPPORT ATTACHMENT
 - V WELDED INTEGRAL SUPPORT ATTACHMENT
 - R RIGID SUPPORT
 - T SWAY STRUT
 - SW SHOP WELD
 - FW FIELD WELD
 - LW LONGITUDINAL WELD
 - WOL WELDOLET
 - (S) ITEM NUMBER DESIGNATION USED IN THE FIRST 10 YEAR INSERVICE INSPECTION INTERVAL.

- NOTES:**
1. MULTIPLE SWAY STRUTS, SPRING SUPPORTS OR SMOOTHERS IN A SINGLE PIPING SUPPORT ARE SHOWN BY A NUMBER BEFORE THE SUPPORT TYPE. (EXAMPLE: 2MS - TWO HYDRAULIC TYPE SMOOTHERS THAT ARE NOT WELDED INTEGRAL TO THE PIPE).
 2. THE SERVICE WATER LINE 10"-HBC-35, 20"-HBC-43 & 24"-HBC-54 WELDS AND SUPPORTS ARE EXEMPT FROM INSERVICE EXAMINATION REQUIREMENTS PER 10 CFR 100.1220. THE WELDS AND SUPPORTS SHOWN MAY NOT REPRESENT THE ACTUAL AS-BUILT CONDITION.

GENERAL NOTE
DIMENSIONS SHOWN ON THIS DRAWING ARE TO BE USED FOR APPROXIMATE LOCATION ONLY. USE DESIGN DRAWINGS FOR DIMENSIONAL VERIFICATION.

REFERENCE DRAWINGS:
15102-041A SERVICE WATER PUMPS AND SECONDARY SERVICE WATER SYSTEM
15102-041B PRIMARY SERVICE WATER SYSTEM

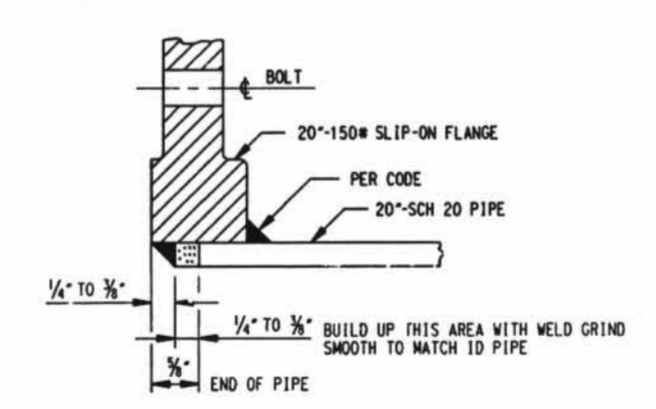

D-134

REV	DATE	BY	CHKD	APP'D	DESCRIPTION
1	11/11/11	CB	LLC	ECC	ISSUED FOR SECOND TO YEAR 151 PROGRAM
2	08/01/09	CB	LLC	ECC	REVISED

SCALE: N.T.S.		DESIGNED: CB	DRAWN: CB
DAVIS-BESSE NUCLEAR POWER STATION UNIT NO. 1			
INSERVICE INSPECTION ISOMETRIC SERVICE WATER SYSTEM VALVE ROOMS AND TUNNEL			
DRAWING NO.		REV.	
ISIM2-241B		2	
SHEET 2			