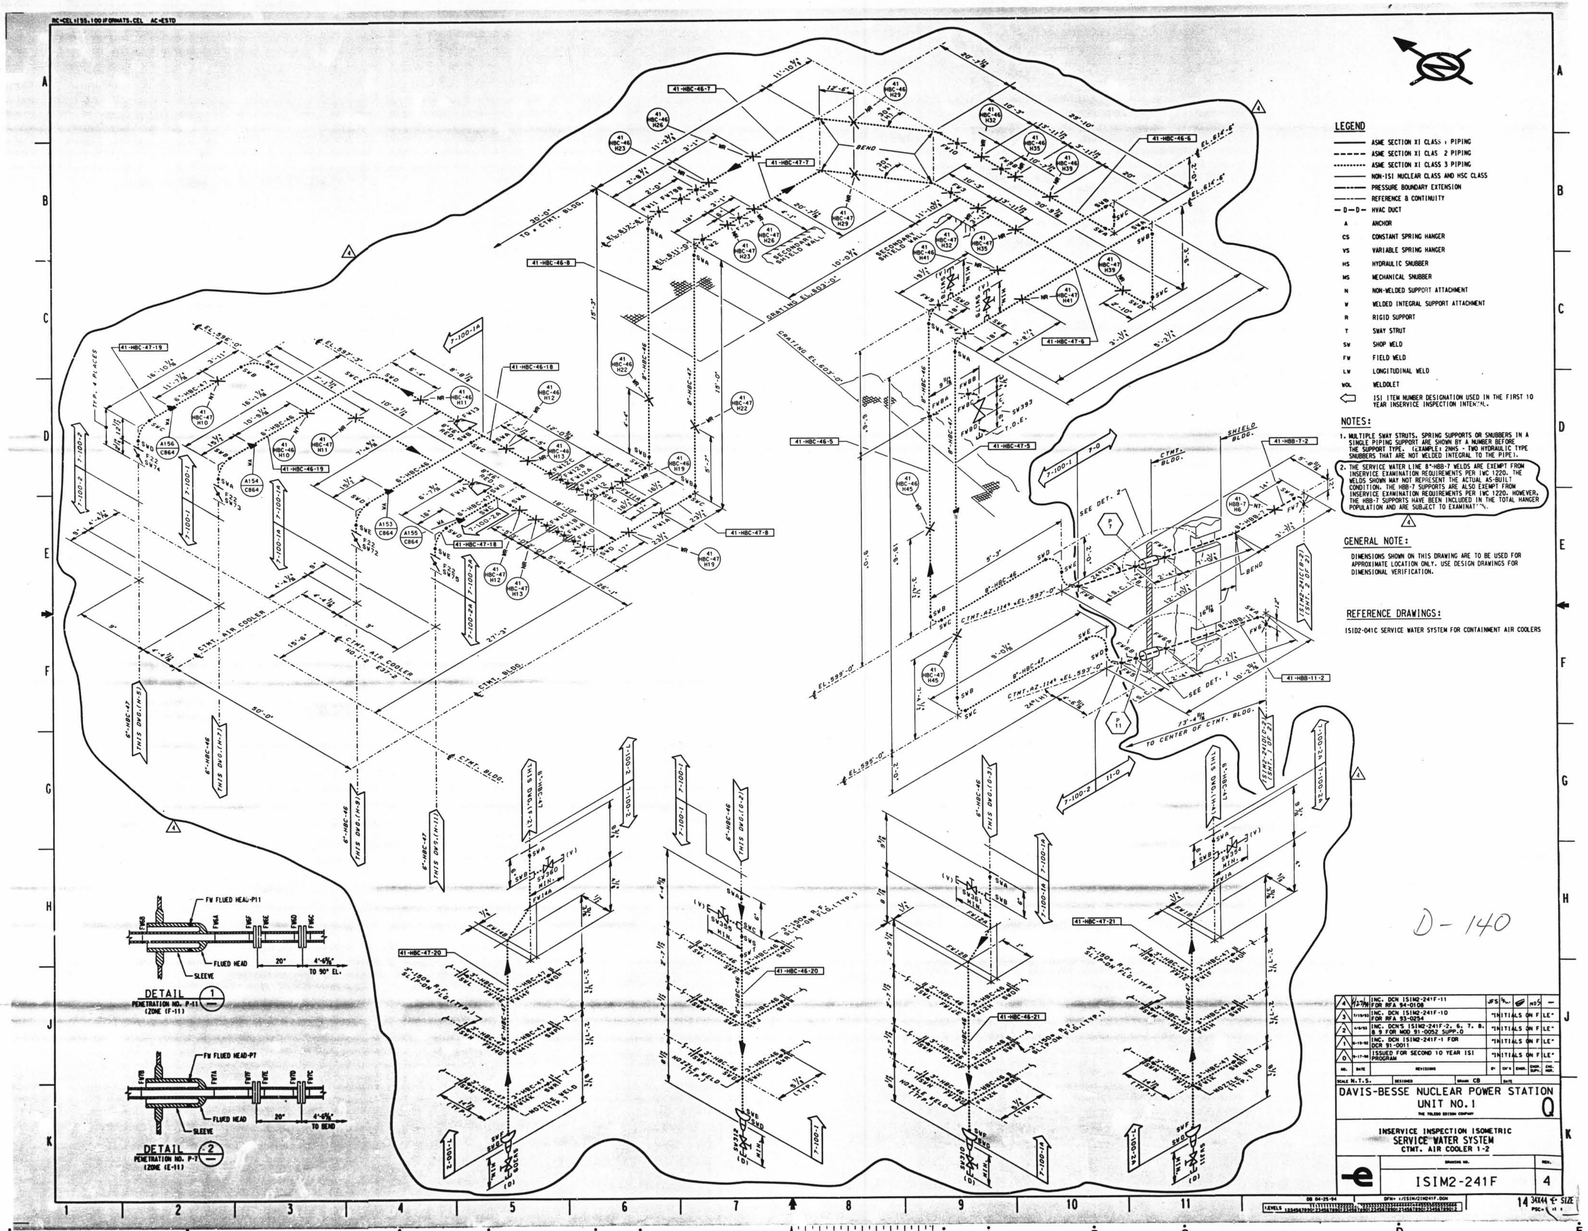

LEGEND

- ASME SECTION XI CLASS 1 PIPING
- ASME SECTION XI CLAS 2 PIPING
- ASME SECTION XI CLASS 3 PIPING
- NON-ISI NUCLEAR CLASS AND HSC CLASS
- PRESSURE BOUNDARY EXTENSION
- REFERENCE & CONTINUITY
- HVAC DUCT
- A ANCHOR
- CS CONSTANT SPRING HANGER
- VS VARIABLE SPRING HANGER
- HS HYDRAULIC SNUBBER
- MS MECHANICAL SNUBBER
- N NON-WELDED SUPPORT ATTACHMENT
- W WELDED INTEGRAL SUPPORT ATTACHMENT
- R RIGID SUPPORT
- T SWAY STRUT
- SW SHOP WELD
- FW FIELD WELD
- LW LONGITUDINAL WELD
- WOL WELDOLET
- ISI ITEM NUMBER DESIGNATION USED IN THE FIRST 10 YEAR INSERVICE INSPECTION INTERVAL.

NOTES:

1. MULTIPLE SWAY STRUTS, SPRING SUPPORTS OR SNUBBERS IN A SINGLE PIPING SUPPORT ARE SHOWN BY A NUMBER BEFORE THE SUPPORT TYPE. (EXAMPLE: 2HMS - TWO HYDRAULIC TYPE SNUBBERS THAT ARE NOT WELDED INTEGRAL TO THE PIPE).
2. THE SERVICE WATER LINE 8"-HBB-7 WELDS ARE EXEMPT FROM INSERVICE EXAMINATION REQUIREMENTS PER IWC 1220. THE WELDS SHOWN MAY NOT REPRESENT THE ACTUAL AS-BUILT CONDITION. THE HBB-7 SUPPORTS ARE ALSO EXEMPT FROM INSERVICE EXAMINATION REQUIREMENTS PER IWC 1220. HOWEVER, THE HBB-7 SUPPORTS HAVE BEEN INCLUDED IN THE TOTAL HANGER POPULATION AND ARE SUBJECT TO EXAMINATION.

GENERAL NOTE:

DIMENSIONS SHOWN ON THIS DRAWING ARE TO BE USED FOR APPROXIMATE LOCATION ONLY. USE DESIGN DRAWINGS FOR DIMENSIONAL VERIFICATION.

REFERENCE DRAWINGS:

1S102-041C SERVICE WATER SYSTEM FOR CONTAINMENT AIR COOLERS

D-140

REV. NO.	DATE	REVISIONS	BY	CK'D	DWN.	SUPV.	APP.
4	11-17-98	INC. DCN 1S1N2-241F-11 FOR RFA 98-0108					
3	11-04-96	INC. DCN 1S1N2-241F-10 FOR RFA 95-0054					
2	4-96-96	INC. DCN'S 1S1N2-241F-2, 6; 7; 8-9 3 FOR MOD 91-0002 SUPP. 3					
1	10-17-90	INC. DCN 1S1N2-241F-1 FOR RFA 89-0001					
0	11-17-88	ISSUED FOR SECOND 10 YEAR 1SI PROGRAM					

Scale N.T.S. DESIGNED Drawn CB Date

DAVIS-BESSE NUCLEAR POWER STATION
UNIT NO. 1
THE TOLEDO EDISON COMPANY

INSERVICE INSPECTION ISOMETRIC
SERVICE WATER SYSTEM
CTMT. AIR COOLER 1-2

DRAWING NO. ISIM2-241F REV. 4

DB 04-25-94 DFN= 1/ISIN2/ISIM2-241F.DGN

14 34X44 E SIZE PRC= 1 =

