BILL OF MATERIALS

QUANTITIES ARE FOR

GROUP NO. & QUANTITY 6	5	4	3	2	1	ITEM NO.	NAME	PIECE NO.	MATERIAL	REMARKS
						1	ALIGNMENT LUG	E-23866-164-004-1	SEE NOTE 6	
						2	SNUBBER SPACER BLOCK	E-23866-164-004-2	SEE NOTE 6	
						3				
						4				
						5	PIN	E-23866-164-004-5	SEE NOTE 6	
						6	SHIM	E-23866-164-004-6	SEE NOTE 6	
						7	SOC. HD CAP SCREW	E-23866-164-004-7	AMS 5735	
						8	SOC. HD CAP SCREW	E-23866-164-004-8	AMS 5735	

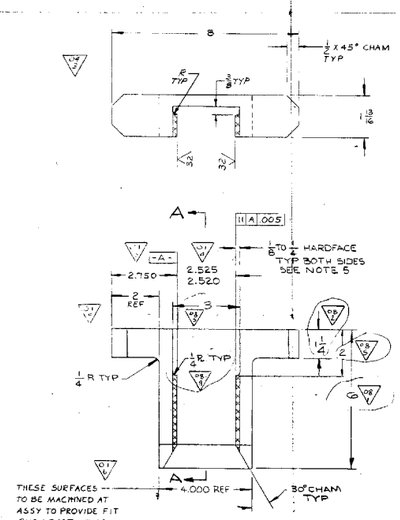

1 ALIGNMENT LUG
SCALE: HALF

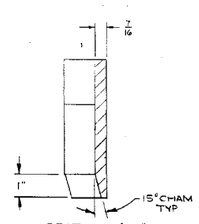

SECTION A-A

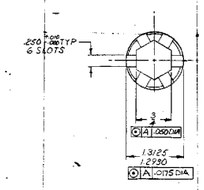

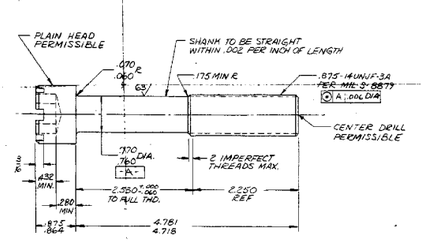

7 SOCKET HEAD CAP SCREW
SCALE: FULL SIZE
SEE NOTES 7 TO 11

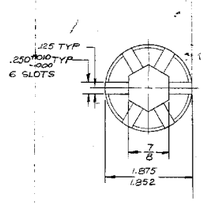

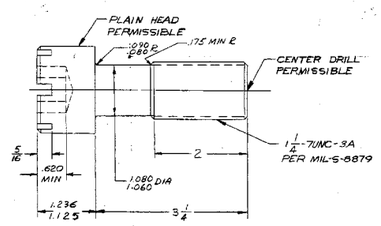

8 SOCKET HEAD CAP SCREW
SCALE: FULL SIZE
SEE NOTES 7 TO 11

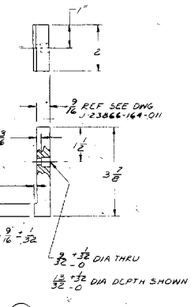

6 SHIM
SCALE: HALF

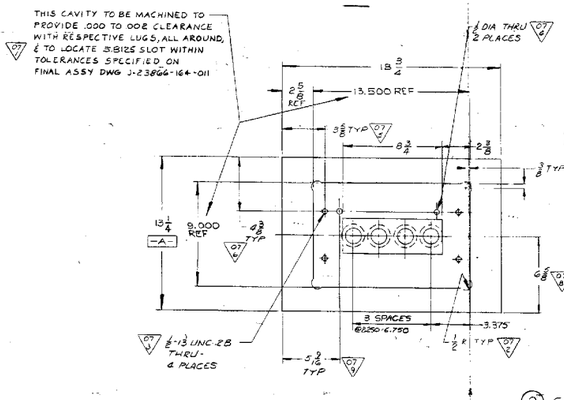

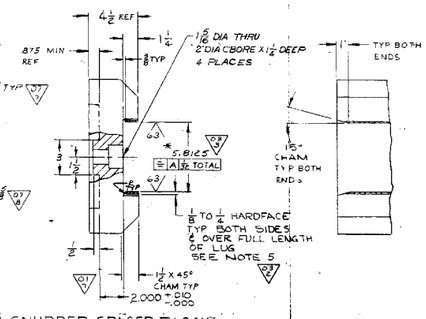

2 SNUBBER SPACER BLOCK
SCALE: QUARTER

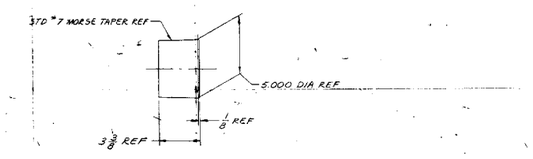

5 PIN
SEE DWG J-23866-164-011
SCALE: QUARTER

11. SOCKET HEAD TO BE STD 1960 SERIES HD
10. TENSILE PROPERTIES (ROOM TEMP)
    A. 130,000 PSI MIN TENSILE
    B. 85,000 PSI MIN YIELD @ .2% OFFSET
    C. ELONGATION 15% IN 4D
9. MFG. PROCEDURES PER SPS-B-186 OR EQUIV. AS APPLICABLE.
8. HEAD TO SHANK FILLET TO BE COLD WORKED
7. THREADS TO BE ROLLED AFTER HEAT TREATING.
6. MATL:
    ITEM 5 ASTM A 276-65, SPT-2
    ITEM 6 ASTM A 240-63, SPT-2
    ITEM 1 ASTM A 240-63, SPT-2
    ITEM 2 ASTM A 240-63, SPT-12
5. SURFACE TO BE HARDFACED WITH HAYNES STELLITE #25 ALLOY PER CENPD SPEC 23866-164-3 AFTER HARDFACING THE COMPONENT SHALL BE HEAT TREATED AT 1950°F IN AN INERT ATMOSPHERE FOR TWO HOURS AND FAST AIR COOLED AT 50°F PER MIN OR FASTER.
3. DIMENSIONING AND TOLERANCING PER USASI Y14.5 1966.
2. * INDICATES AS BUILT DIMENSIONS ARE TO BE RECORDED PER CENPD SPEC 23866-16-40-1.
1. PRODUCT TO BE IN ACCORDANCE WITH CENPD SPEC. 23866-16-40-1.

E-23866-164-004 OE

EA-FC-00-XXX DF 12/01

CERTIFIED FOR CONSTRUCTION

ALL ITEMS DEPICTED ON THIS DRAWING ARE WITHIN LICENSE RENEWAL SCOPE.

REV.	DESCRIPTION	BY & DATE	CHK & DATE	ENG. APPD	PROJ. APPD
07	1) ITEM NO. 1 WAS 4/4 (2) WAS 3/4 3) ADDED 3" DIM (4) ADDED IN R. 5) ADDED 2" DIM. PER REV REQ 23866-318	R.W. 2-28-68	2-5	2-5	2-5
	6) REVISED ITEM 2 7) ADDED ITEM 8 PER REV REQ 23866-353	8/7/68	8-7-68	8-7-68	8-7-68

REV.	DESCRIPTION	BY & DATE	CHK & DATE	ENG. APPD	PROJ. APPD
06	1) ZONE D-8 WAS 6.000 SLOT PER REV REQ. 23866-296	RJA 6-6-67	RJA 6-6-67		
	2) ITEM 2 WAS 1/4-20 TYP. 3) ITEM 2: ADDED 1/4-13UNC-2B, 4 PLACES; 4) ITEM 2: ADDED 1" DIA THRU; 5) ITEM 2: ADDED 3 3/8 TYP; 6) ITEM 2 ADDED 4 3/8 TYP; 7) ITEM 2: ADDED 4 3/8 TYP; 8) ITEM 2: ADDED 6 5/8 DIM; 9) ITEM 2: ADDED 2 5/8 DIM. 10) ITEM NO. 7 ADDED, (11) NOTES 7 TO 11 ADDED. PER REV REQ. 23866-310	DW. 7/16/68	RJA 7-16-68		

REV.	DESCRIPTION	BY & DATE	CHK & DATE	ENG. APPD
05 CONT.	3) ITEM 1, REMOVED 23/32 DIA HOLES & THEIR POSITIONAL DIMS PER REV. REQUEST 23866-106	JM 5/14/68	RJA 5/14/68	
	4) REMOVED ITEM 4, 5) REMOVED FROM NOTE 6 ITEM 4, ASTM 290 63, SAE-2, PER REV. REQ. 23866-129.	SCR. 9-17-68	RJA 9-17-68	
05	PER REV REQ. 23866-187	RJA 10-16-68	RJA 10-16-68	

REV.	DESCRIPTION	BY & DATE	CHK & DATE	ENG. APPD
04	6) ITEM 2 REVISED LOCATION & DEPTH OF 1"-8 UNC-2B TAPPED HOLES, AS PER REV. REQ. 23866-76	L.J. 4-22-68	RJA 4-22-68	
	7) DELETED NOTE 4 8) ZONE B-5 SEE NOTE 5 WAS SEE NOTE 4 PER REV REQ 23866-83 9) ZONE C-5 WAS 8.000 PER REV REQ 23866-84	MAS 5-8-68	5-8-68	5-8-68
	10) GENERALLY REVISED ITEM 4 2) ITEM 4 NAME WAS ALIGN. REV PER REV. REQUEST 23866-162	JM 6-6-68		

REV.	DESCRIPTION	BY & DATE	CHK & DATE	ENG. APPD
03	1) CHANGED NOTE 6, ITEM 1 & 2 WERE ASTM A276-65 2) DELETED WORD "MACHINING" FROM TOL BLOCK. ITEM 1: 3) WAS 2 3/4, 4) WAS 2 EQ. SPC 5) REVISED LOCAT. & TOLERANCES. 6) ADDED "ANG. LOCATION AFTER HEAT TREAT", ITEM 2: 7) WAS 2" MIN. AS PER REV REQ 23866-72	L.J. 11-20-67		5-14-68
	8) DELETED ITEM 3 & ADDED ITEM 14, DELETED NOTE 7 "SEE REV REQ 23866-74"	MAS 4-2-68	4-2-68	
	9) ADDED ITEMS 5 & 6 PER REV REQ 23866-75	MAS 4-25-68	4-25-68	

REV.	DESCRIPTION	BY & DATE	CHK & DATE	ENG. APPD
00	ORIGINAL ISSUE			

OMAHA PUBLIC POWER DISTRICT
FORT CALHOUN UNIT NO. 1

TOLERANCES UNLESS OTHERWISE SPECIFIED

DIMENSIONS	UNDER 6	6 TO 18	OVER 18
DECIMAL DIMS	± .005	± .010	± .010
FRACTIONAL DIMS	± 1/64	± 1/32	± 1/16
FINISH (√) AA-125 MICRO IN		ANGLES ± 1/2°	
THREADS-UNIFIED (4-2A-2B)		CHAMFER ± 5°	
BREAK CORNERS 1/64 MAX	RAD. FOR CHAMFER		
FILLETS-1/64 TO 1/32 RADIUS			
DIMENSION IN INCHES BASED ON 68°F (20°C)			

DO NOT SCALE DWG. — CALC. WT.:
SCALE: 1/4 = 1'-0" — ACT. WT.:

THIS DRAWING IS THE PROPERTY OF COMBUSTION ENGINEERING, INC. NUCLEAR WINDSOR, CONNECTICUT AND IS NOT TO BE REPRODUCED, OR USED TO FURNISH ANY INFORMATION FOR MAKING THE DRAWING OR APPARATUS EXCEPT UNDER ANY RIGHTS FOR BY AGREEMENT WITH SAID COMPANY.

NEXT ASSY:
FINAL ASSY:
SUPERSEDES:
SUPERSEDED:

PREPARED UNDER ARC CONTRACT — CEND CONTRACT 23866

DRAWN BY:		11-29-66
CHECKED:		2-5-67
APPROVED:		2-5-67
		2-7-67
		2-7-67
		2-7-67

REACTOR INTERNALS
MISCELLANEOUS
DETAILS

E-23866-164-004 — 05

SHEET — OF — REV.

0015151

FOR INFORMATION ONLY

NOTE: THIS PRINT IS TO BE USED FOR THE FCS LICENSE RENEWAL PROJECT ONLY. IT MAY NOT REFLECT THE MOST CURRENT REVISION OF THIS DRAWING.