U.E.&C. 9321F-25463

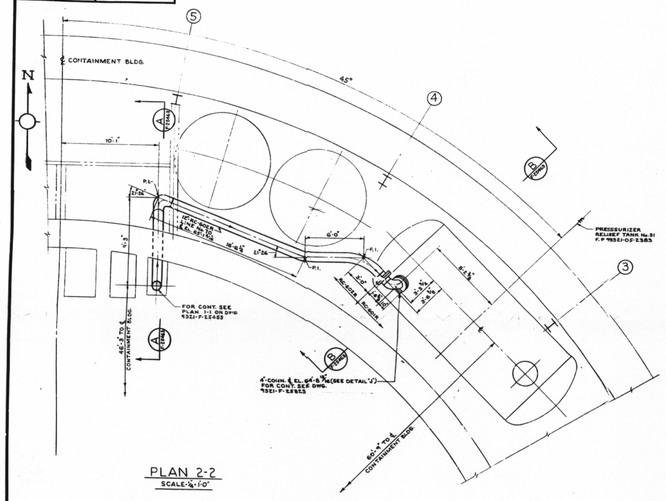

PLAN 2-2
SCALE-¼"-1'-0"

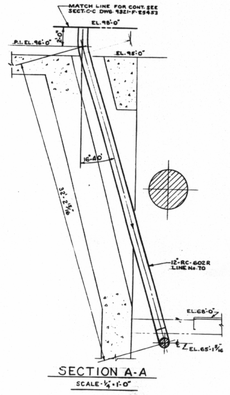

SECTION A-A
SCALE-½"-1'-0"

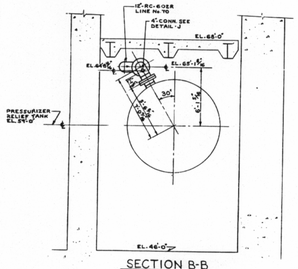

SECTION B-B
SCALE-½"-1'-0"

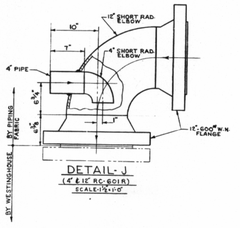

DETAIL 'J'
(4"&12"RC-601R)
SCALE-1½"-1'-0"

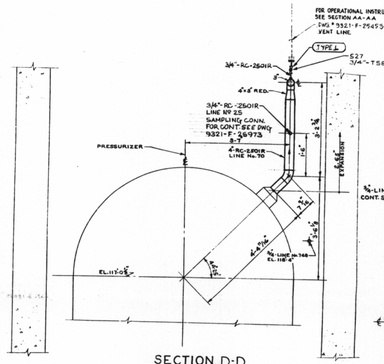

SECTION D-D
SCALE-¾"-1'-0"

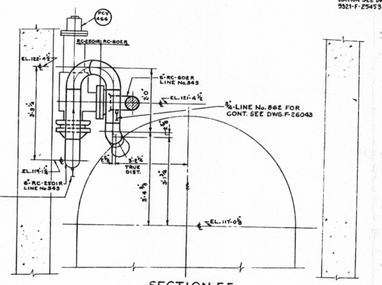

SECTION F-F
SCALE-¾"-1'-0"

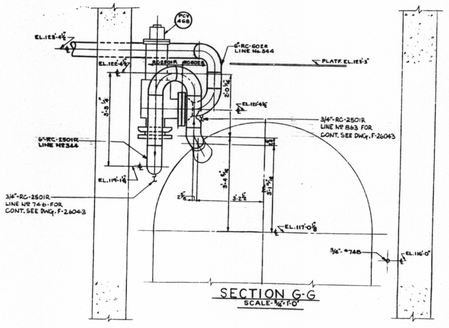

SECTION G-G
SCALE-¾"-1'-0"

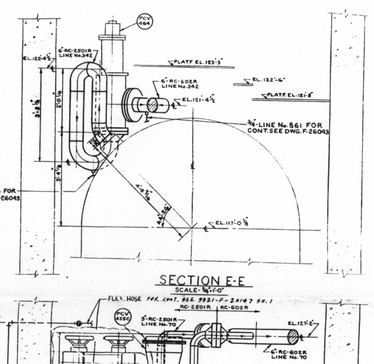

SECTION E-E
SCALE-¾"-1'-0"

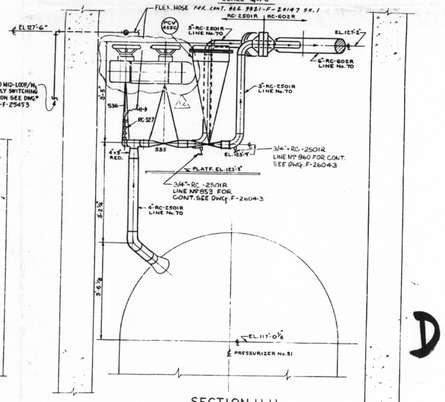

SECTION H-H
SCALE-¾"-1'-0"

D-3

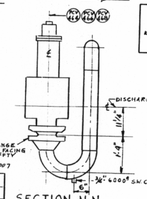

SECTION N-N
SCALE-3/4"=1'-0"
(TYPICAL FOR LINES 342, 343 & 344)

WORK THIS DWG. WITH 9321-F-25453

THIS DRAWING CONTAINS "CLASS A" ITEMS AS DEFINED BY CORPORATE INSTRUCTION CI-240-1

UNCONTROLLED DRAWING
Copy Date FEB 28 2002
CAUTION — Extended use of this drawing copy may result in its inaccuracy due to subsequent design changes and drawing updates.

NO.	DATE	DESCRIPTION	DWG. APP.
10	7/94	AS BUILT PER MOD # 92-074 ECO	
9	6/94	REVISED DWG. TO INDICATE AS BUILT CONDITIONS	
8	1/94	REVISED PER MOD # 92-074 ECO	
7	7/93	ADDED VIOL VENT LINE	
1	7/89	REVISED & STANDARDIZED ALL RELIEF VALVE DRAIN PIPING PER MOD 89-074 ECO'S PER MOD 89-074 ECO	
2	1/89	REVISED LINE No. 346, 347 & 348 TO 6" SCH 160 PER MOD 89-074 ECO	
3	7/88	NO DUPL. PER MOD 87-107 ECO	
4	1/88	REVISED PER MOD 87-107 ECO	
5	7/87	AS BUILT PER MOD 87-107 ECO	

FIRST ISSUE PRELIMINARY DWG. RD.

ENGINEER Sam Silkin 6/57
STATE REG. N.Y. No. 42796

UNITED ENGINEERS & CONSTRUCTORS INC.

WESTINGHOUSE ELECTRIC CORPORATION
CONTAINMENT BUILDING
PRIMARY COOLANT PRESSURIZER SAFETY RELIEF VALVE PIPING - SHEET NO. 2
FOR
CONSOLIDATED EDISON COMPANY
INDIAN POINT GENERATING STATION
UNIT NO. 3

U.E.&C. DWG. NO. 9321-F-25463-12 | CON. ED. CO. DWG. NO. A202109

Attachment to IPN-02-024 For NRC 3-14, Rev. 1