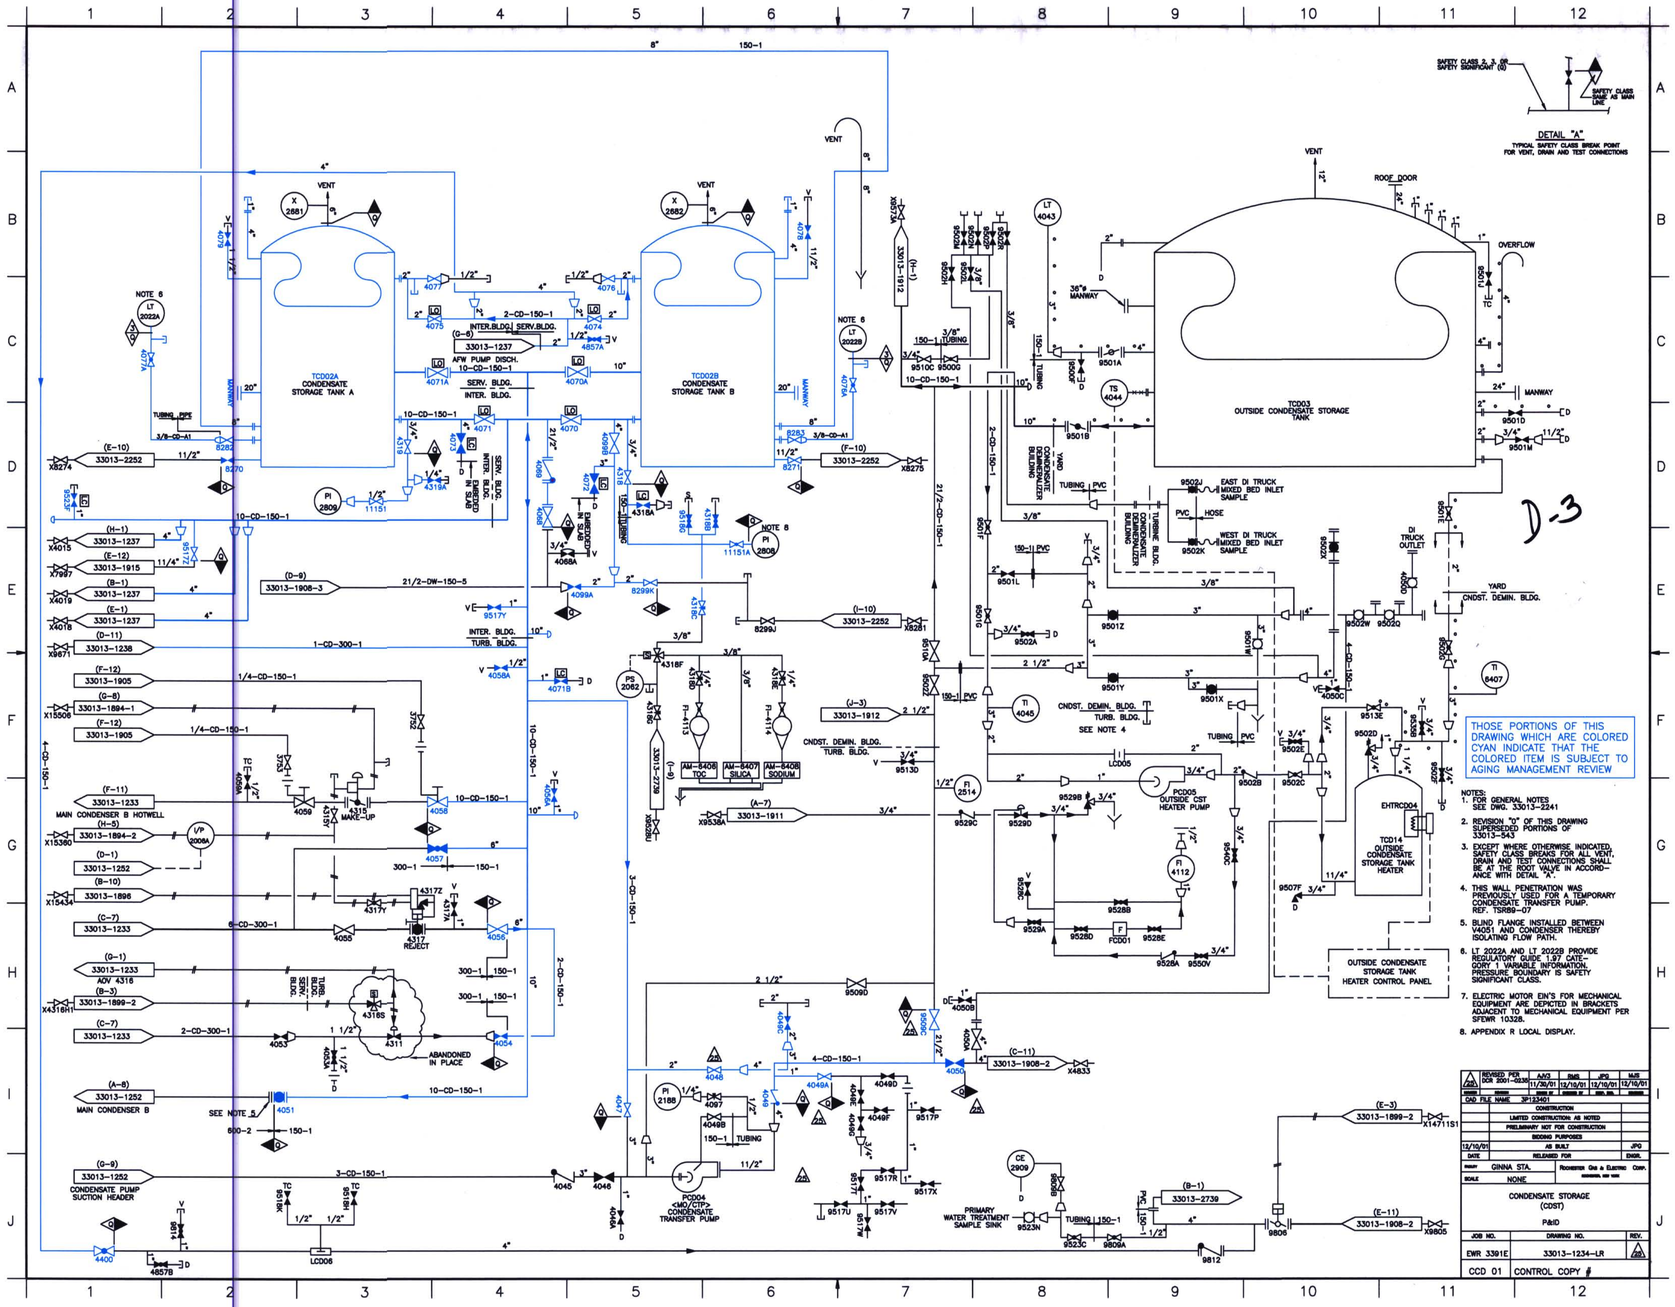

THOSE PORTIONS OF THIS DRAWING WHICH ARE COLORED CYAN INDICATE THAT THE COLORED ITEM IS SUBJECT TO AGING MANAGEMENT REVIEW

NOTES:
1. FOR GENERAL NOTES SEE DWG. 33013-2241
2. REVISION "0" OF THIS DRAWING SUPERSEDED PORTIONS OF 33013-543
3. EXCEPT WHERE OTHERWISE INDICATED, SAFETY CLASS BREAKS FOR ALL VENT, DRAIN AND TEST CONNECTIONS SHALL BE AT THE ROOT VALVE IN ACCORDANCE WITH DETAIL "A".
4. THIS WALL PENETRATION WAS PREVIOUSLY USED FOR A TEMPORARY CONDENSATE TRANSFER PUMP. REF. TSR89-07
5. BLIND FLANGE INSTALLED BETWEEN V4051 AND CONDENSER THEREBY ISOLATING FLOW PATH.
6. LT 2022A AND LT 2022B PROVIDE REGULATORY GUIDE 1.97 CATEGORY 1 VARIABLE INFORMATION. PRESSURE BOUNDARY IS SAFETY SIGNIFICANT CLASS.
7. ELECTRIC MOTOR EIN'S FOR MECHANICAL EQUIPMENT ARE DEPICTED IN BRACKETS ADJACENT TO MECHANICAL EQUIPMENT PER SFEWR 10328.
8. APPENDIX R LOCAL DISPLAY.

22	REVISED PER DCR 2001-0235	AJG 11/30/01	RMS 12/10/01	JPG 12/10/01	MJS 12/10/01
CAD FILE NAME	3P123401				
CONSTRUCTION					
LIMITED CONSTRUCTION AS NOTED					
PRELIMINARY NOT FOR CONSTRUCTION					
BIDDING PURPOSES					
12/10/01	AS BUILT			JPG	
DATE	RELEASED FOR			ENGR.	
DRAWN GINNA STA.		ROCHESTER GAS & ELECTRIC CORP.			
SCALE NONE					

CONDENSATE STORAGE (CDST)

P&ID

JOB NO.	DRAWING NO.	REV.
EWR 3391E	33013-1234-LR	22

CCD 01 CONTROL COPY #