THOSE PORTIONS OF THIS DRAWING WHICH ARE COLORED CYAN INDICATE THAT THE COLORED ITEM IS SUBJECT TO AGING MANAGEMENT REVIEW

D-6

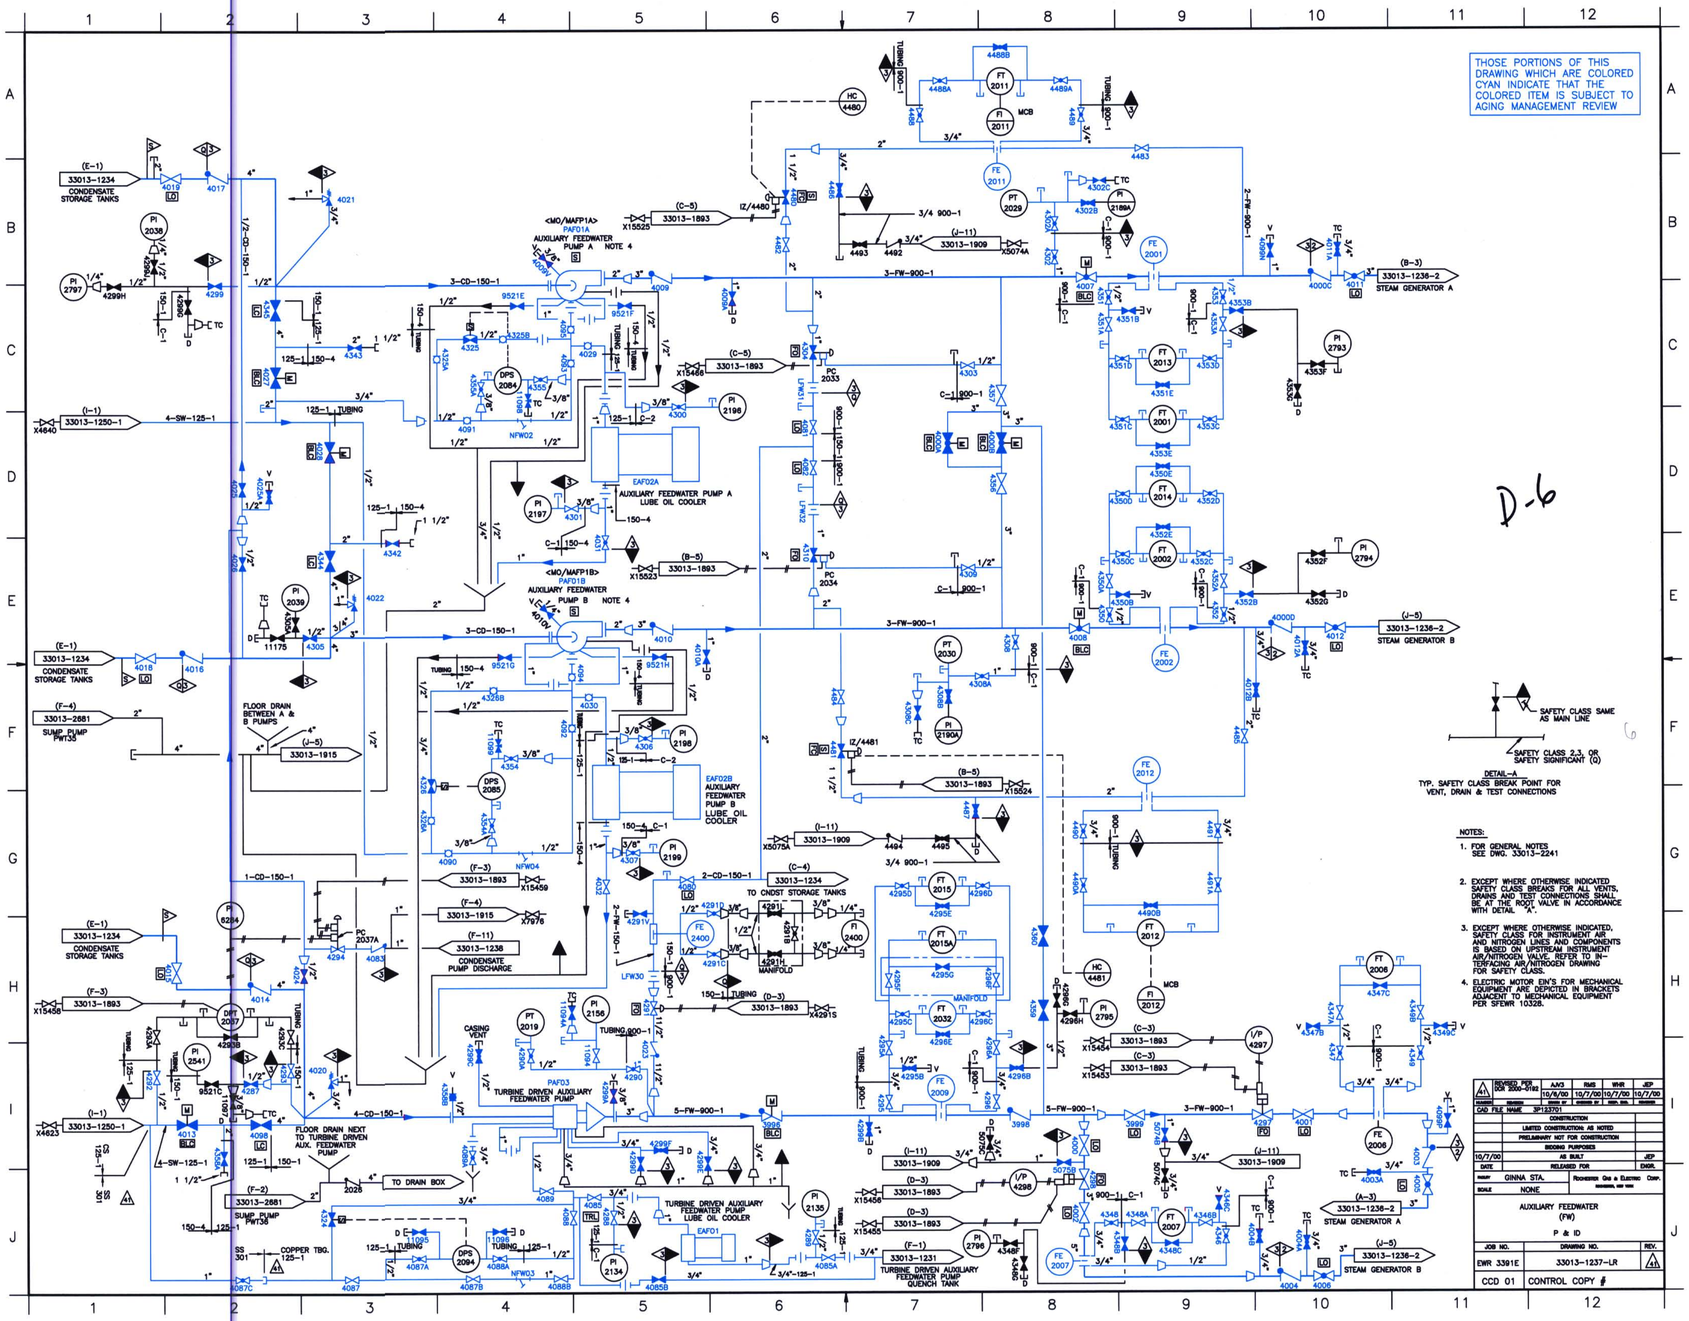

NOTES:

1. FOR GENERAL NOTES SEE DWG. 33013-2241
2. EXCEPT WHERE OTHERWISE INDICATED SAFETY CLASS BREAKS FOR ALL VENTS, DRAINS AND TEST CONNECTIONS SHALL BE AT THE ROOT VALVE IN ACCORDANCE WITH DETAIL "A".
3. EXCEPT WHERE OTHERWISE INDICATED, SAFETY CLASS FOR INSTRUMENT AIR AND NITROGEN LINES AND COMPONENTS IS BASED ON UPSTREAM INSTRUMENT AIR/NITROGEN VALVE. REFER TO INTERFACING AIR/NITROGEN DRAWING FOR SAFETY CLASS.
4. ELECTRIC MOTOR EIN'S FOR MECHANICAL EQUIPMENT ARE DEPICTED IN BRACKETS ADJACENT TO MECHANICAL EQUIPMENT PER SFEWR 10326.

1	REVISED PER DCR 2000-0198	AJV3	RMS	WHR	JEP
		10/6/00	10/7/00	10/7/00	10/7/00
CAD FILE NAME	3P133701				
	CONSTRUCTION				
	LIMITED CONSTRUCTION AS NOTED				
	PRELIMINARY NOT FOR CONSTRUCTION				
	BIDDING PURPOSES				
10/7/00	AS BUILT				JEP
DATE	RELEASED FOR				ENGR.
DRAWN	GINNA STA.	ROCHESTER GAS & ELECTRIC CORP. ROCHESTER, NEW YORK			
SCALE	NONE				

AUXILIARY FEEDWATER (FW)

P & ID

JOB NO.	DRAWING NO.	REV.
EWR 3391E	33013-1237-LR	1

CCD 01 CONTROL COPY #