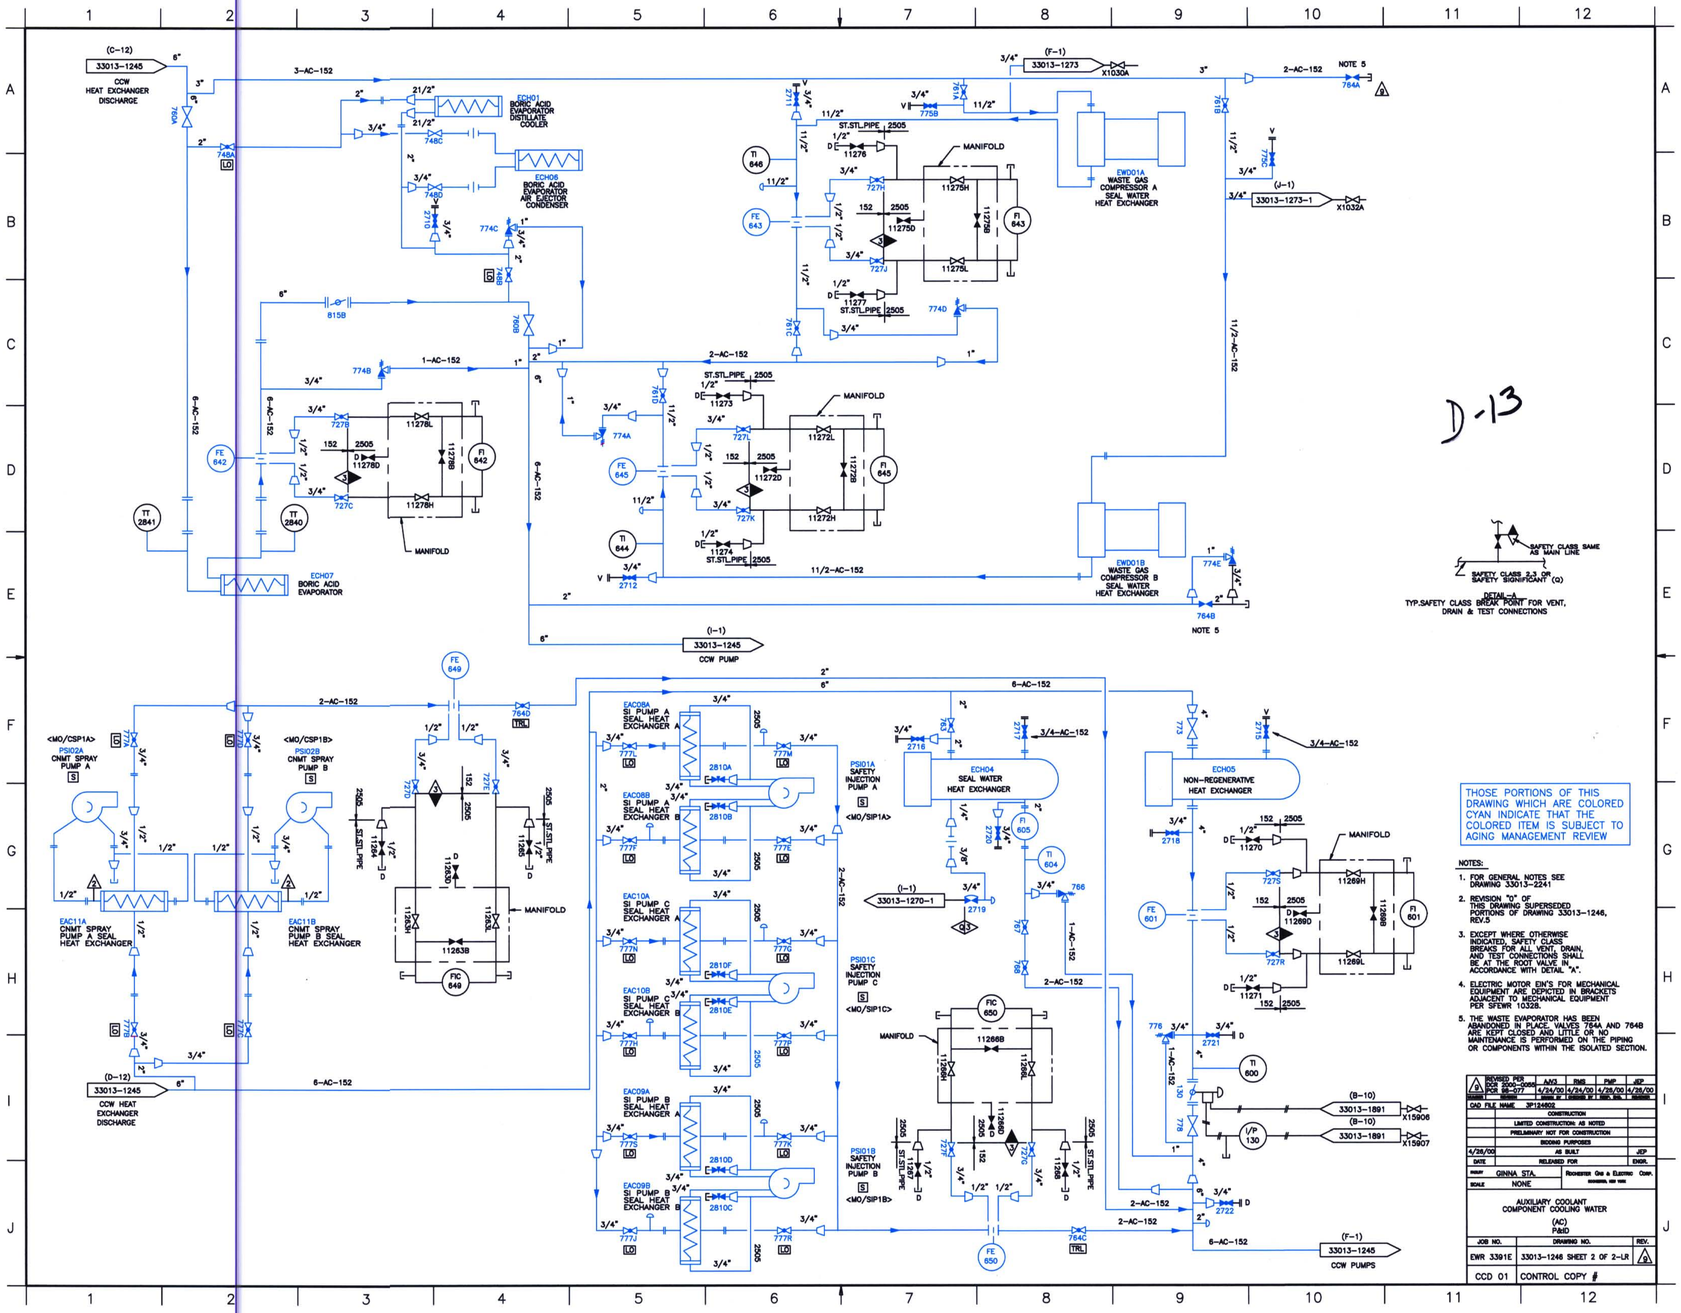

THOSE PORTIONS OF THIS DRAWING WHICH ARE COLORED CYAN INDICATE THAT THE COLORED ITEM IS SUBJECT TO AGING MANAGEMENT REVIEW

NOTES:

1. FOR GENERAL NOTES SEE DRAWING 33013-2241
2. REVISION "0" OF THIS DRAWING SUPERSEDED PORTIONS OF DRAWING 33013-1246, REV.5
3. EXCEPT WHERE OTHERWISE INDICATED, SAFETY CLASS BREAKS FOR ALL VENT, DRAIN, AND TEST CONNECTIONS SHALL BE AT THE ROOT VALVE IN ACCORDANCE WITH DETAIL "A".
4. ELECTRIC MOTOR EIN'S FOR MECHANICAL EQUIPMENT ARE DEPICTED IN BRACKETS ADJACENT TO MECHANICAL EQUIPMENT PER SFEWR 10328.
5. THE WASTE EVAPORATOR HAS BEEN ABANDONED IN PLACE. VALVES 764A AND 764B ARE KEPT CLOSED AND LITTLE OR NO MAINTENANCE IS PERFORMED ON THE PIPING OR COMPONENTS WITHIN THE ISOLATED SECTION.

REV	DESCRIPTION	DRAWN	CHECKED	APPROVED	APPROVED
9	REVISED PER DCR 2000-0055 PCR 99-077	AJG	RMS	PMP	JEP
		4/24/00	4/24/00	4/26/00	4/26/00

CAD FILE NAME 3P124602

	CONSTRUCTION	
	LIMITED CONSTRUCTION AS NOTED	
	PRELIMINARY NOT FOR CONSTRUCTION	
	BIDDING PURPOSES	
4/26/00	AS BUILT	JEP
DATE	RELEASED FOR	ENGR.

DRAWN	GINNA STA.	ROCHESTER GAS & ELECTRIC CORP.
SCALE	NONE	

AUXILIARY COOLANT COMPONENT COOLING WATER (AC) P&ID

JOB NO.	DRAWING NO.	REV.
EWR 3391E	33013-1246 SHEET 2 OF 2-LR	9

CCD 01 CONTROL COPY #