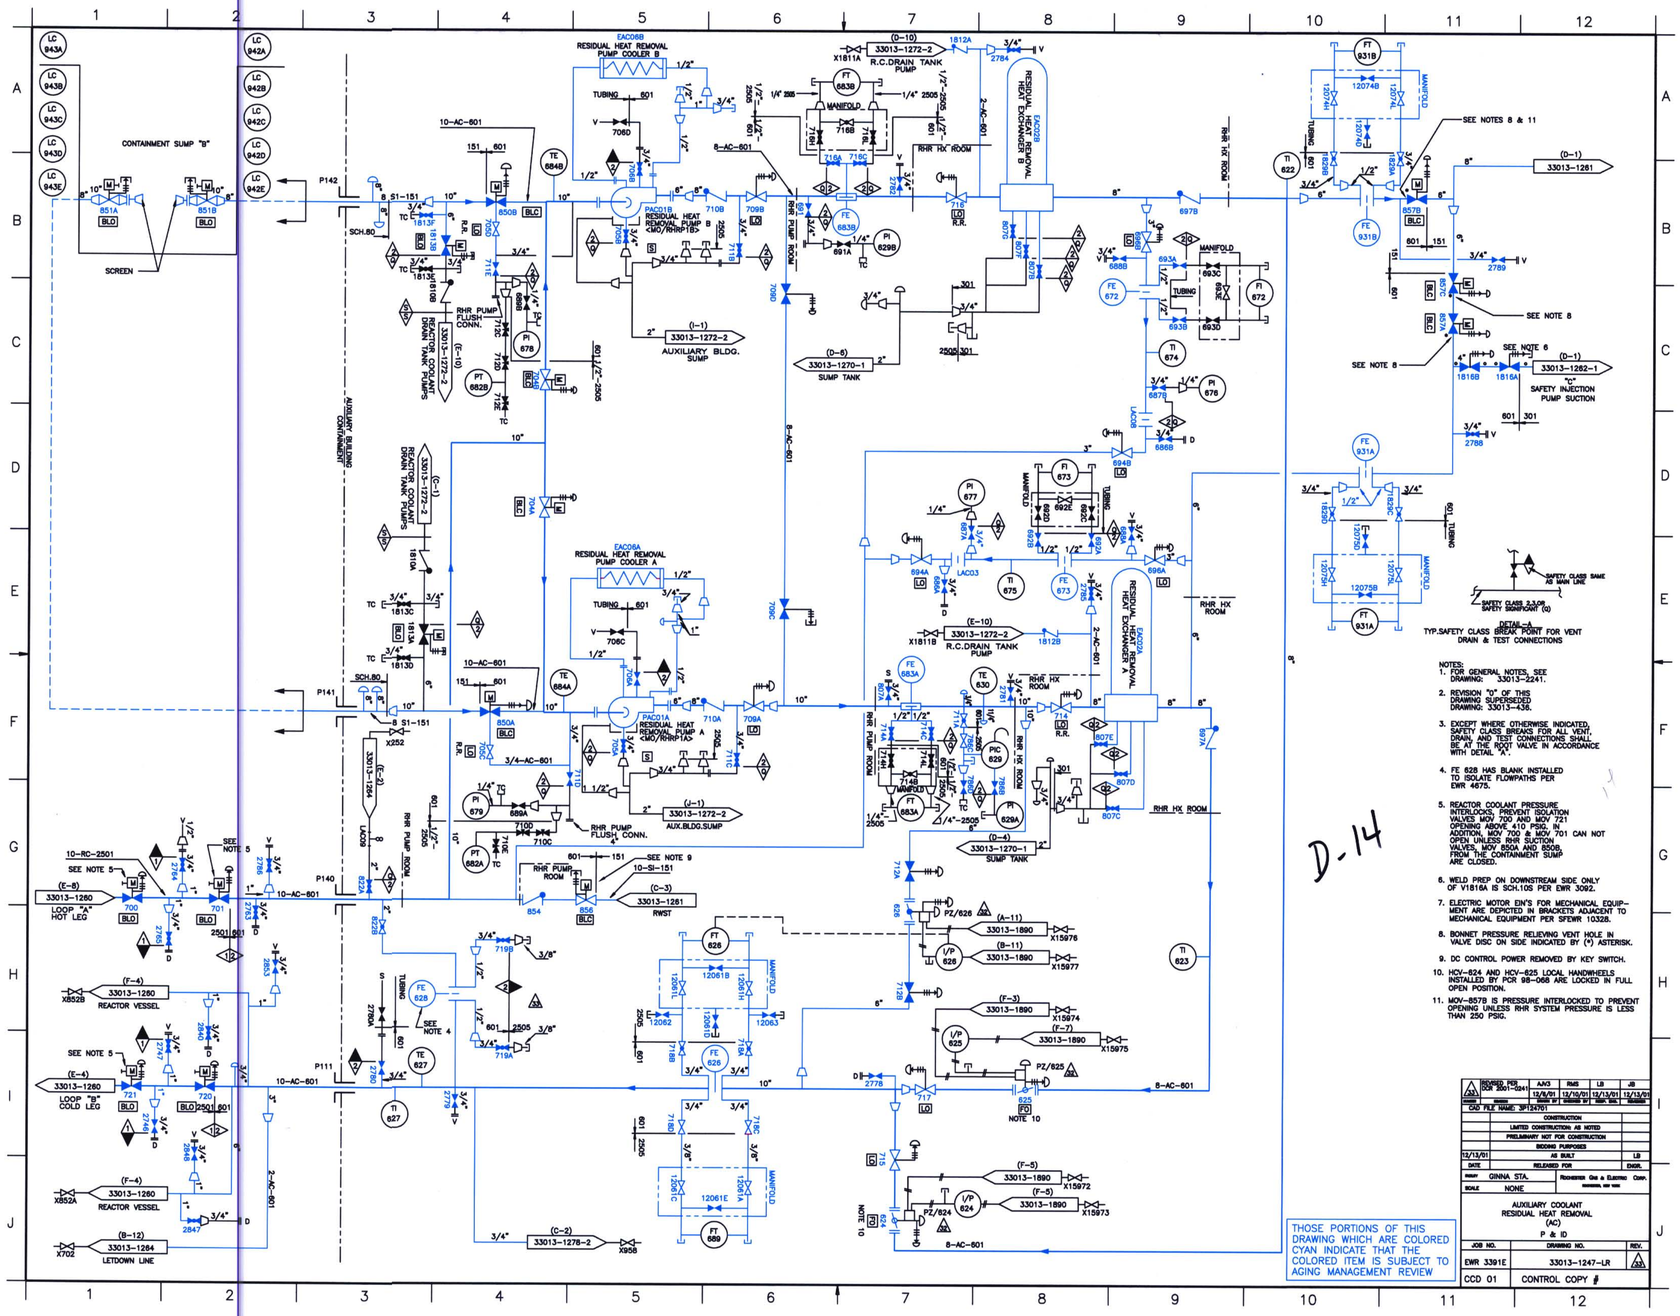

NOTES:

1. FOR GENERAL NOTES, SEE DRAWING: 33013-2241.
2. REVISION "0" OF THIS DRAWING SUPERSEDED DRAWING: 33013-438.
3. EXCEPT WHERE OTHERWISE INDICATED, SAFETY CLASS BREAKS FOR ALL VENT, DRAIN AND TEST CONNECTIONS SHALL BE AT THE ROOT VALVE IN ACCORDANCE WITH DETAIL "A".
4. FE 628 HAS BLANK INSTALLED TO ISOLATE FLOWPATHS PER EWR 4675.
5. REACTOR COOLANT PRESSURE INTERLOCKS, PREVENT ISOLATION VALVES MOV 700 AND MOV 721 OPENING ABOVE 410 PSIG. IN ADDITION, MOV 700 & MOV 701 CAN NOT OPEN UNLESS RHR SUCTION VALVES, MOV 850A AND 850B, FROM THE CONTAINMENT SUMP ARE CLOSED.
6. WELD PREP ON DOWNSTREAM SIDE ONLY OF V1816A IS SCH.10S PER EWR 3092.
7. ELECTRIC MOTOR EIN'S FOR MECHANICAL EQUIPMENT ARE DEPICTED IN BRACKETS ADJACENT TO MECHANICAL EQUIPMENT PER SFEWR 10328.
8. BONNET PRESSURE RELIEVING VENT HOLE IN VALVE DISC ON SIDE INDICATED BY (*) ASTERISK.
9. DC CONTROL POWER REMOVED BY KEY SWITCH.
10. HCV-624 AND HCV-625 LOCAL HANDWHEELS INSTALLED BY PCR 98-068 ARE LOCKED IN FULL OPEN POSITION.
11. MOV-857B IS PRESSURE INTERLOCKED TO PREVENT OPENING UNLESS RHR SYSTEM PRESSURE IS LESS THAN 250 PSIG.

THOSE PORTIONS OF THIS DRAWING WHICH ARE COLORED CYAN INDICATE THAT THE COLORED ITEM IS SUBJECT TO AGING MANAGEMENT REVIEW

REVISED PER PCR 2001-0241	AJKO	RMS	LB	JB
12/6/01	12/10/01	12/13/01	12/13/01
CAD FILE NAME: 3P124701			
CONSTRUCTION			
LIMITED CONSTRUCTION AS NOTED			
PRELIMINARY NOT FOR CONSTRUCTION			
BIDDING PURPOSES			
12/13/01	AS BUILT		LB
DATE	RELEASED FOR		ENGR.
DRAWN GINNA STA.	ROCHESTER GAS & ELECTRIC CORP.		
SCALE NONE			

AUXILIARY COOLANT
RESIDUAL HEAT REMOVAL
(AC)
P & ID

JOB NO.	DRAWING NO.	REV.
EWR 3391E	33013-1247-LR	
CCD 01	CONTROL COPY #	