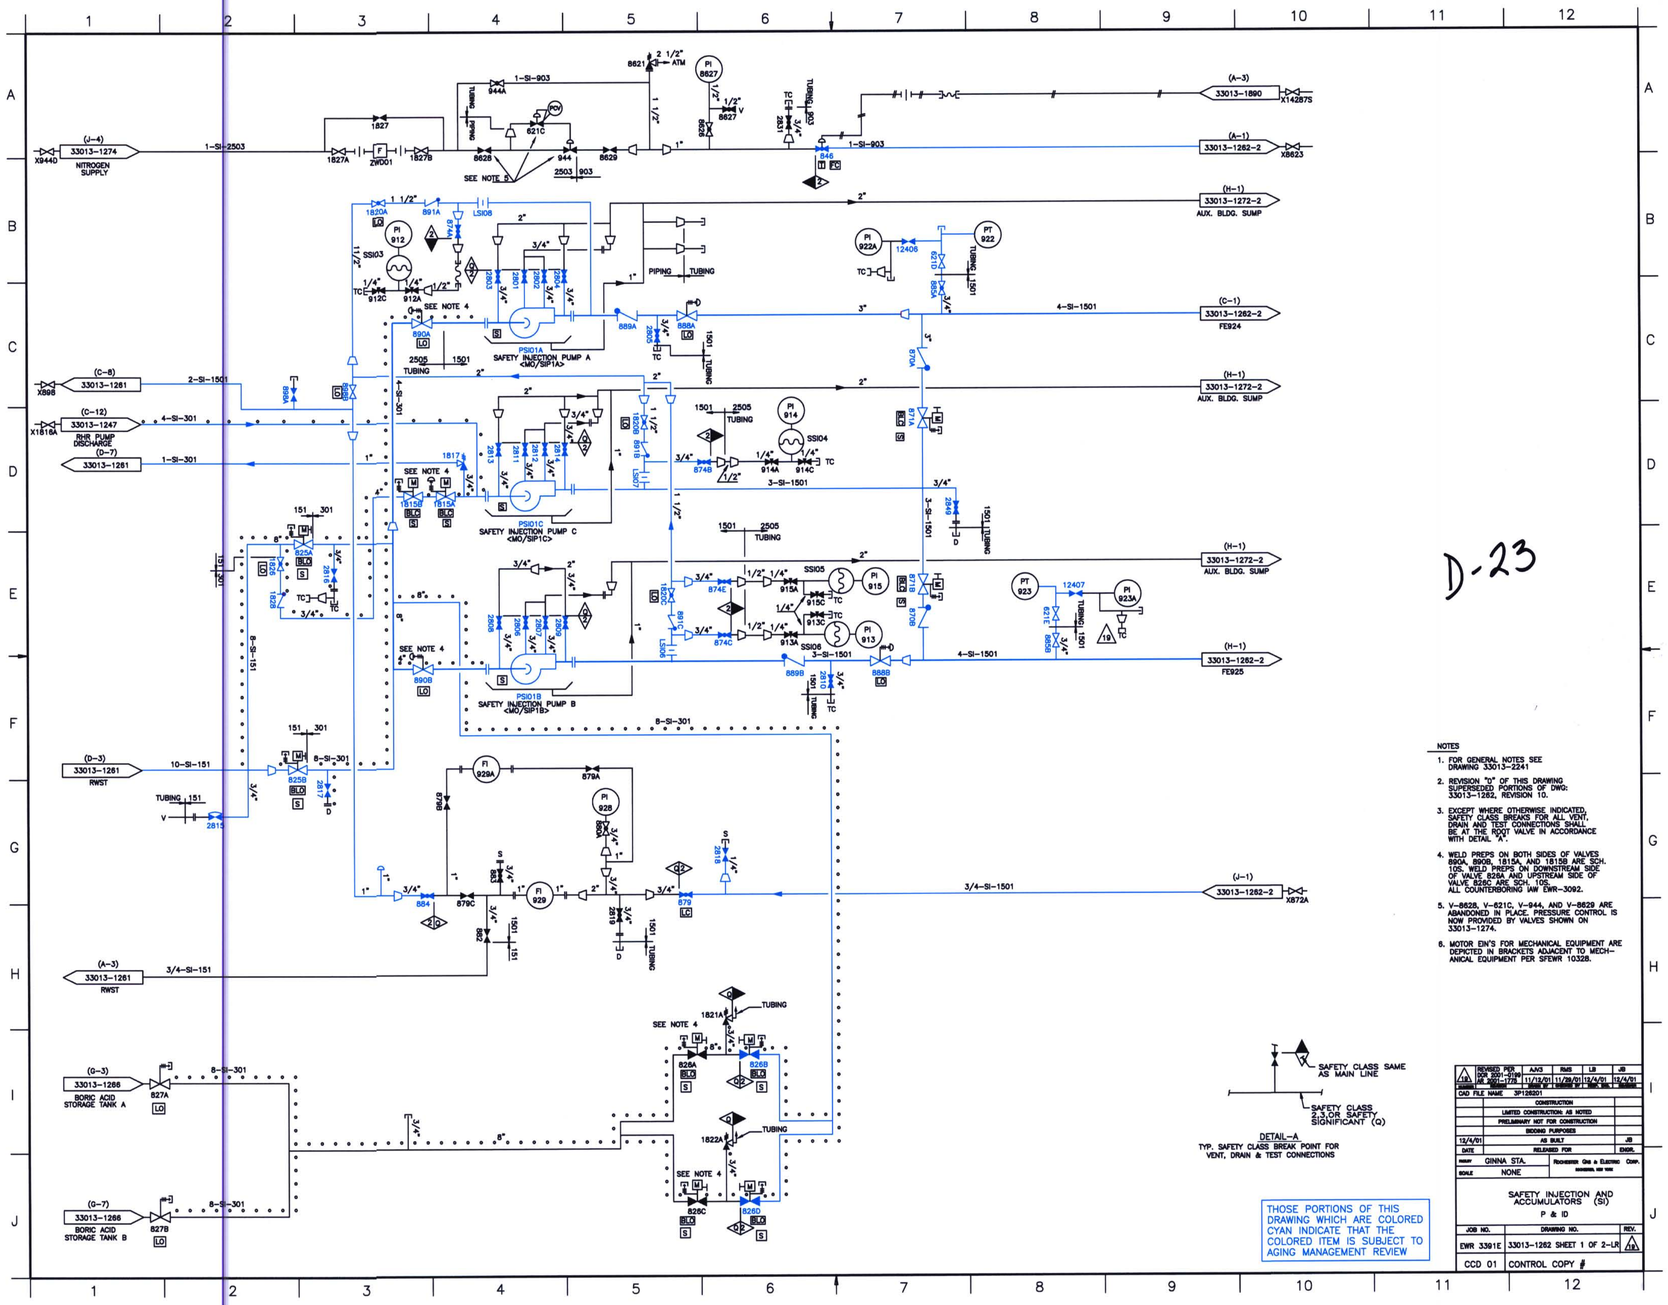

NOTES

1. FOR GENERAL NOTES SEE DRAWING 33013-2241
2. REVISION "0" OF THIS DRAWING SUPERSEDED PORTIONS OF DWG: 33013-1282, REVISION 10.
3. EXCEPT WHERE OTHERWISE INDICATED, SAFETY CLASS BREAKS FOR ALL VENT, DRAIN AND TEST CONNECTIONS SHALL BE AT THE ROOT VALVE IN ACCORDANCE WITH DETAIL "A".
4. WELD PREPS ON BOTH SIDES OF VALVES 890A, 890B, 1815A, AND 1815B ARE SCH. 10S. WELD PREPS ON DOWNSTREAM SIDE OF VALVE 825A AND UPSTREAM SIDE OF VALVE 825C ARE SCH. 10S. ALL COUNTERBORING IAW EWR-3092.
5. V-8628, V-621C, V-944, AND V-8629 ARE ABANDONED IN PLACE. PRESSURE CONTROL IS NOW PROVIDED BY VALVES SHOWN ON 33013-1274.
6. MOTOR EIN'S FOR MECHANICAL EQUIPMENT ARE DEPICTED IN BRACKETS ADJACENT TO MECHANICAL EQUIPMENT PER SFEWR 10328.

REV	REVISED PER JCO 00-0001-1274	AJK3	RMS	LB	JB
1	JCO 00-0001-1274	11/13/01	11/28/01	12/4/01	12/4/01

CAD FILE NAME 3P126201

CONSTRUCTION
LIMITED CONSTRUCTION AS NOTED
PRELIMINARY NOT FOR CONSTRUCTION
BIDDING PURPOSES
12/4/01 AS BUILT JB
DATE RELEASED FOR ENGR.

DRAWN GINNA STA. ROCHESTER GAS & ELECTRIC CORP. ROCHESTER, NEW YORK
SCALE NONE

SAFETY INJECTION AND ACCUMULATORS (SI)
P & ID

JOB NO.	DRAWING NO.	REV.
EWR 3391E	33013-1282 SHEET 1 OF 2-LR	1

CCD 01 CONTROL COPY #